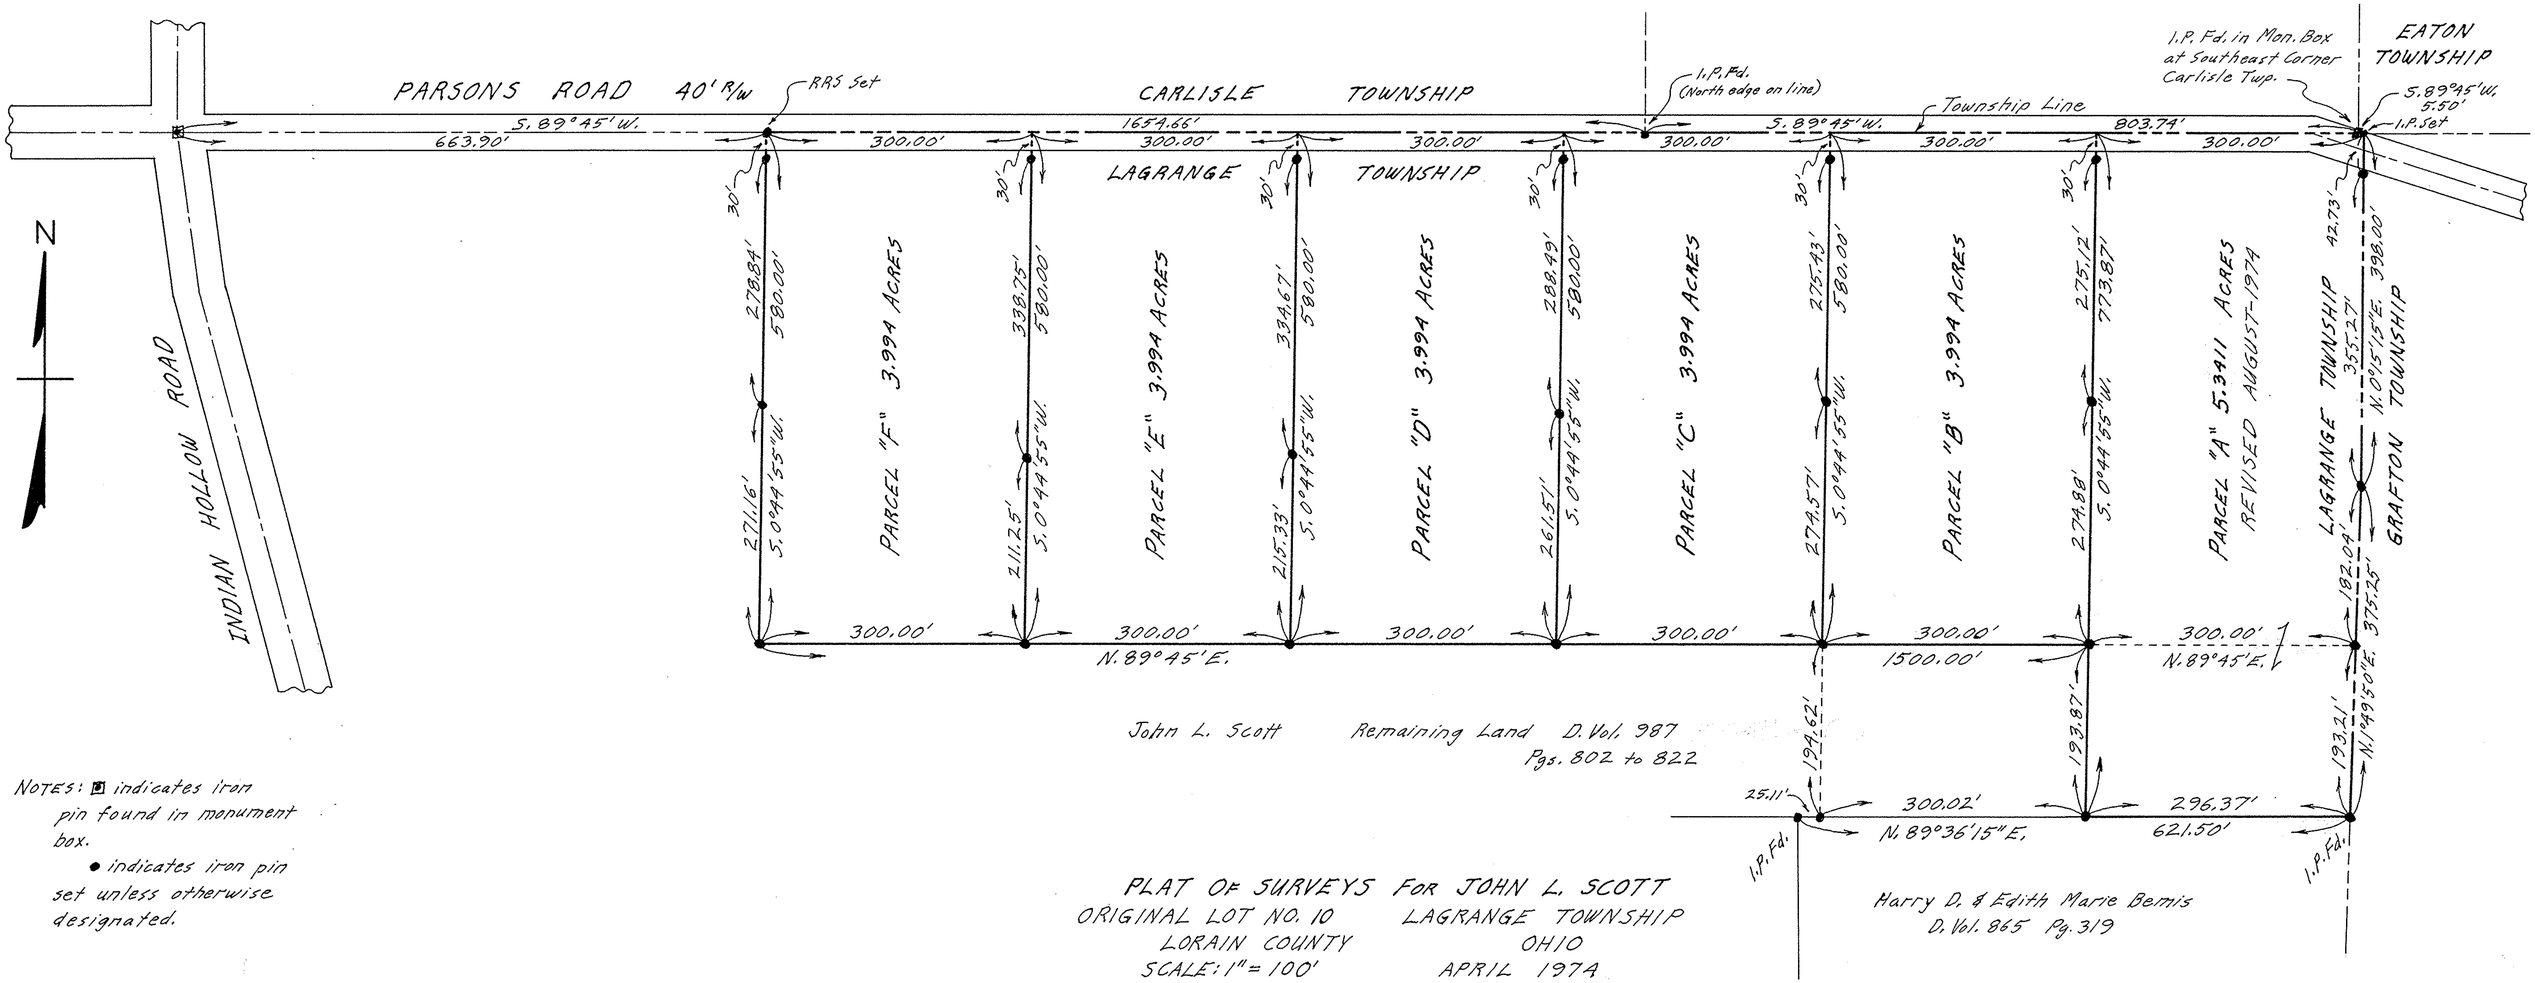

NOTES: ▣ indicates iron pin found in monument box.

● indicates iron pin set unless otherwise designated.

PLAT OF SURVEYS FOR JOHN L. SCOTT

ORIGINAL LOT NO. 10 LAGRANGE TOWNSHIP

LORAIN COUNTY OHIO

SCALE: 1" = 100' APRIL 1974

Gary E. Penfound Reg. Surveyor No. 4457

15-00-010