


NOTE: • indicates iron pin set
unless otherwise designated.

Gary E. Penfound
Reg. Surveyor No. 4457

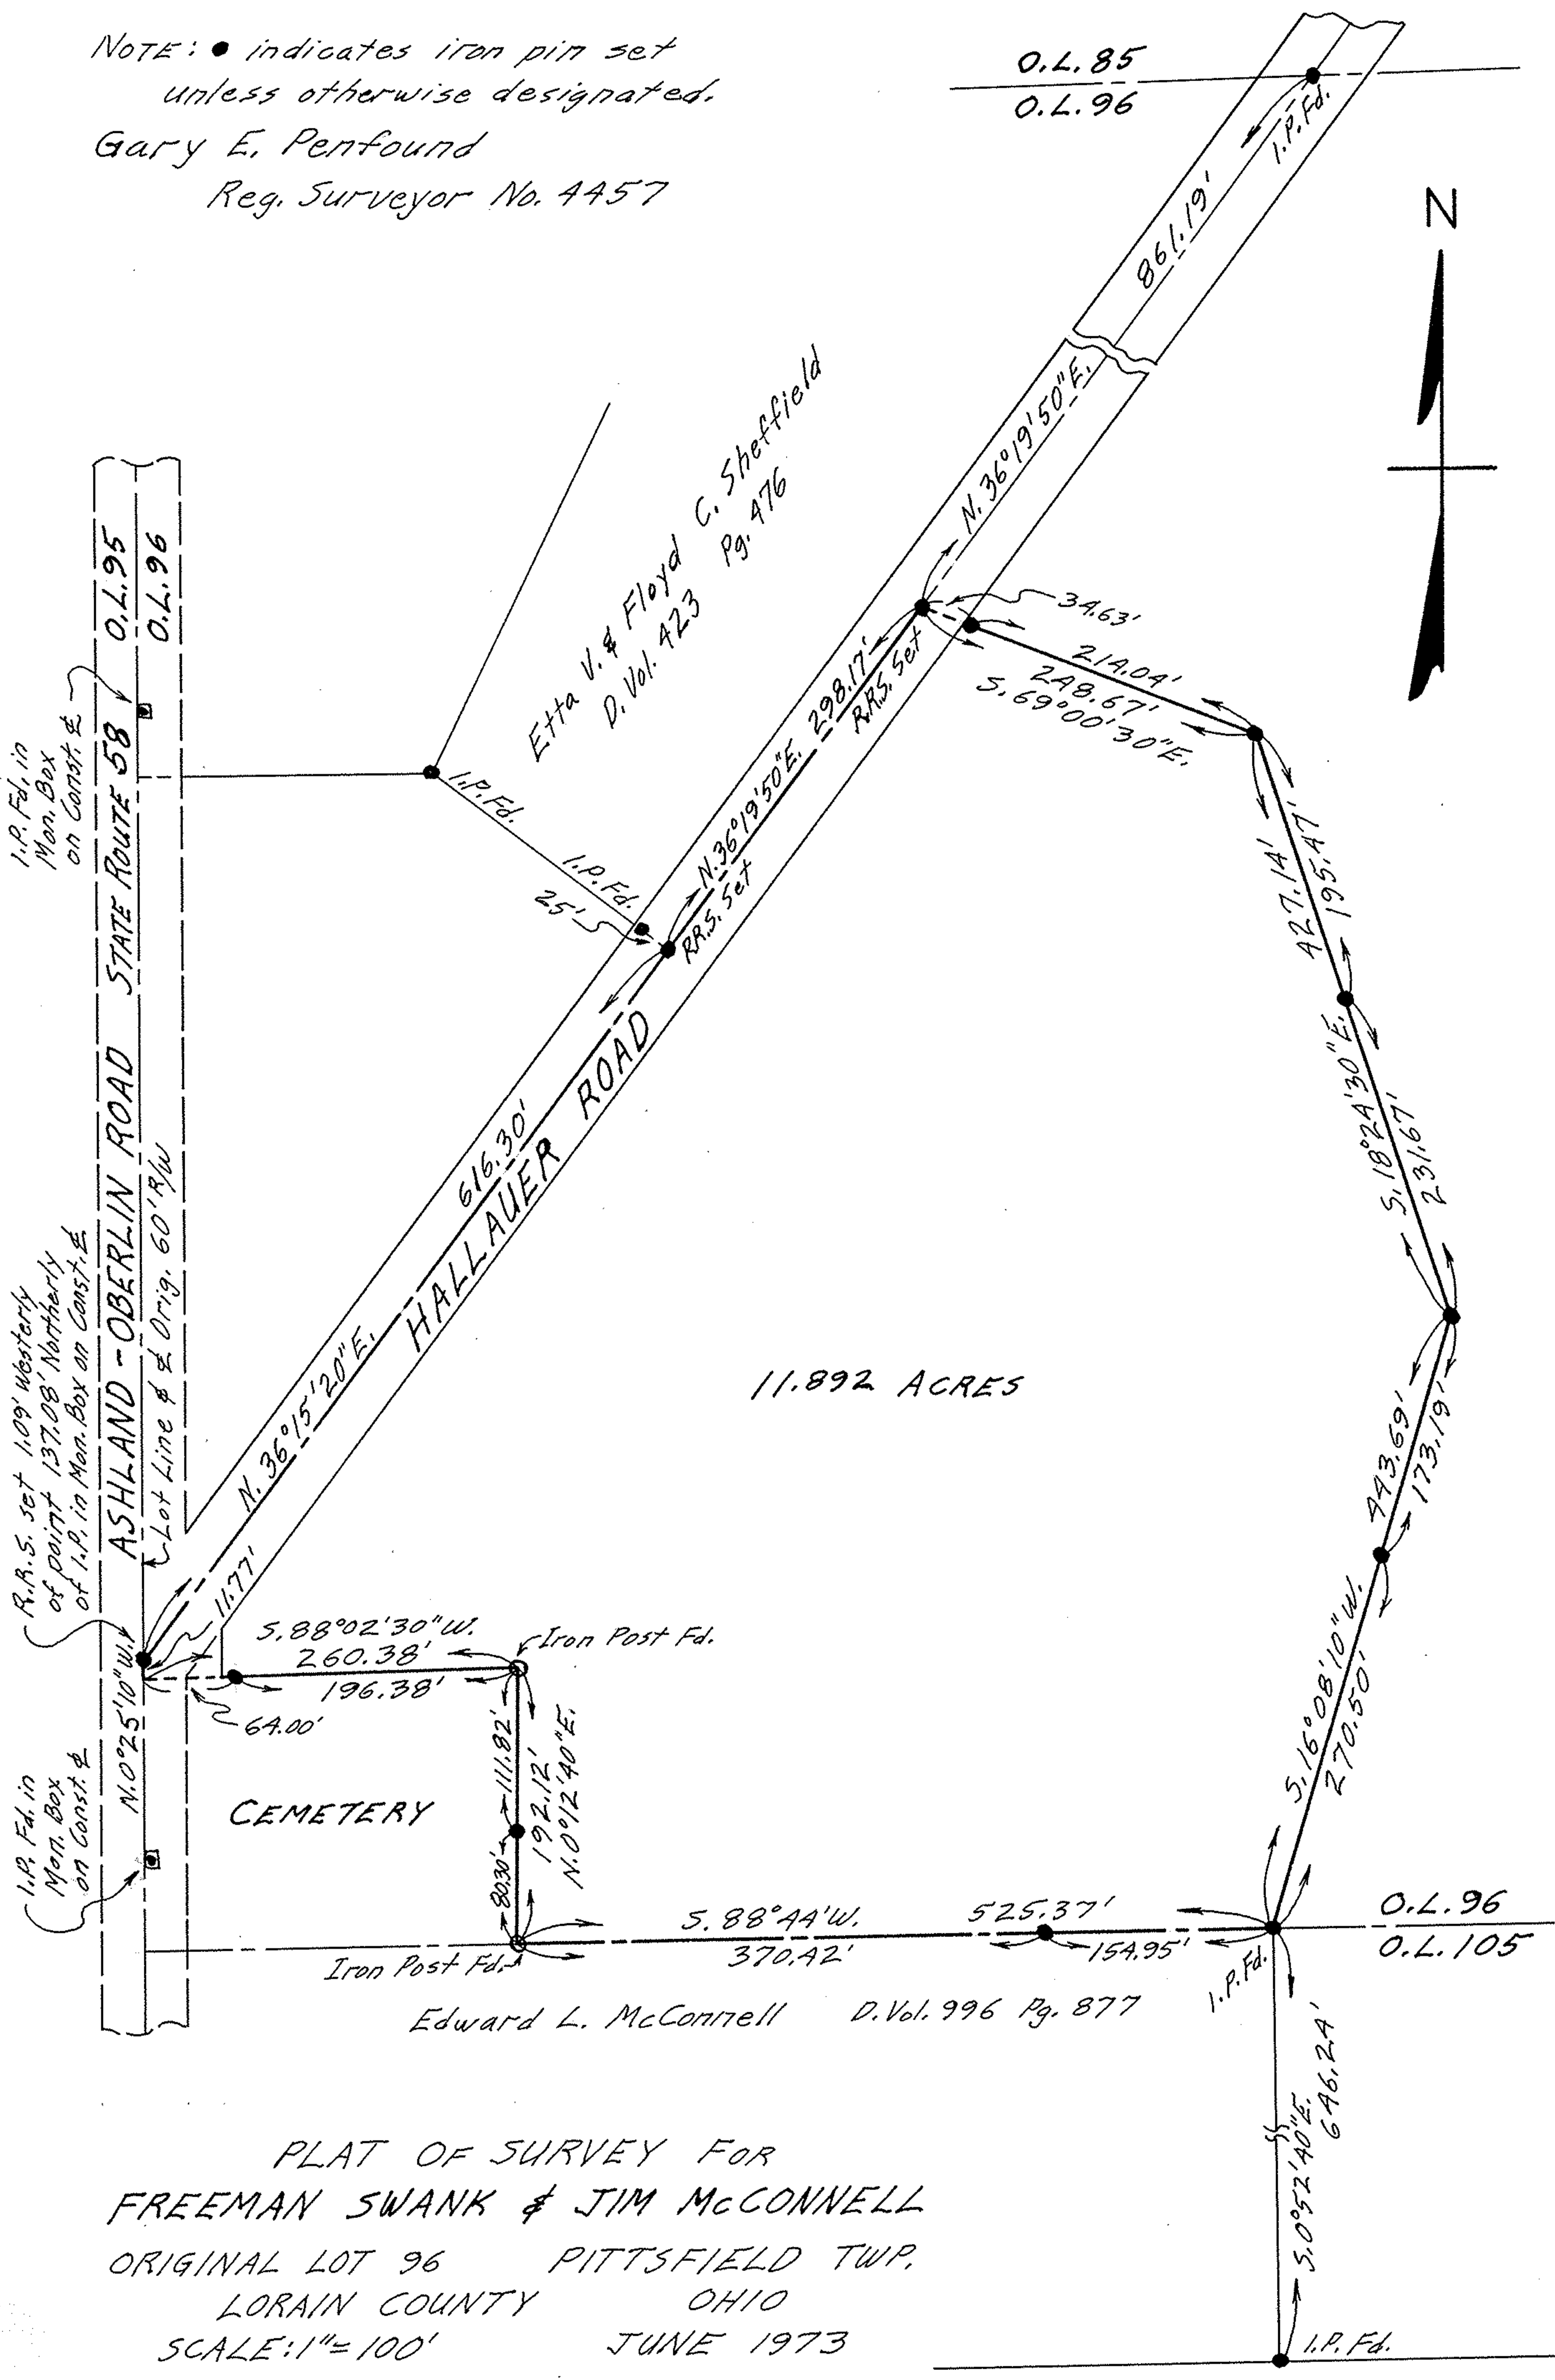

11.892 ACRES

PLAT OF SURVEY FOR
FREEMAN SWANK & JIM MCCONNELL
ORIGINAL LOT 96 PITTSFIELD TWP.
LORAIN COUNTY OHIO
SCALE: 1" = 100' JUNE 1973

14-00-096