PLAT OF SURVEYS FOR
GRACE BRUCE WALKER & KENNETH W. WALKER
AND FOR KENNETH B. WALKER

SECTIONS NO'S. 14 & 15 CARLISLE TWP.
LORAIN COUNTY OHIO
SCALE: 1" = 50' JUNE 1967
Gary E. Penfound Reg. Surveyor No. 4457

NOTE: ● indicates iron pin set unless otherwise designated.

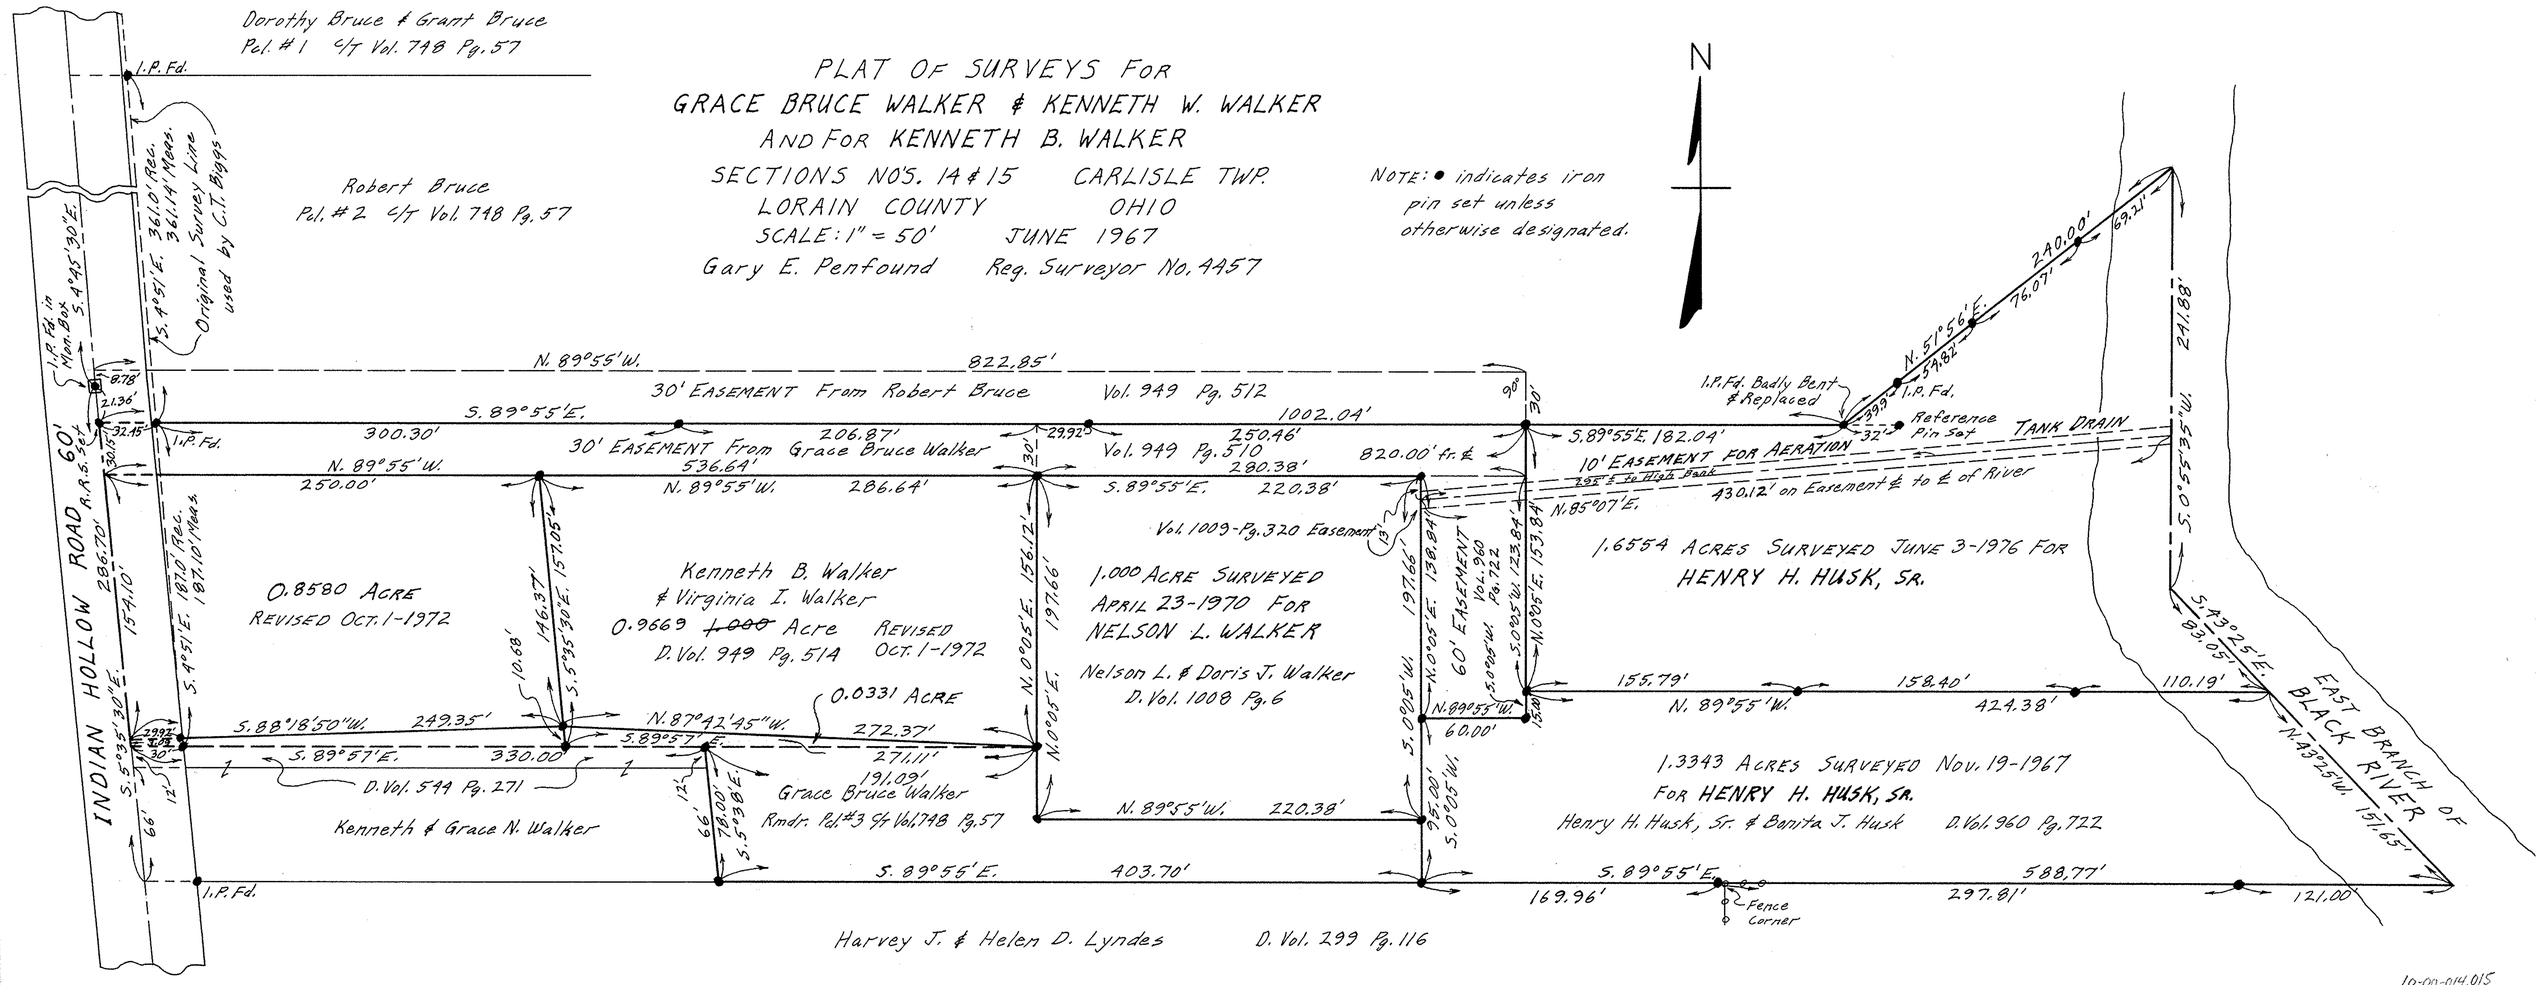

10-00-014,015