PLAT OF SURVEY FOR WALTER WARRINER

SECTIONS NOS. 14 & 15 CARLISLE TOWNSHIP
LORAIN COUNTY OHIO
SCALE: 1" = 100' MARCH 1971
Gary E. Penfound Reg. Surveyor No. 4457

NOTE: ● indicates iron pin set unless otherwise designated.

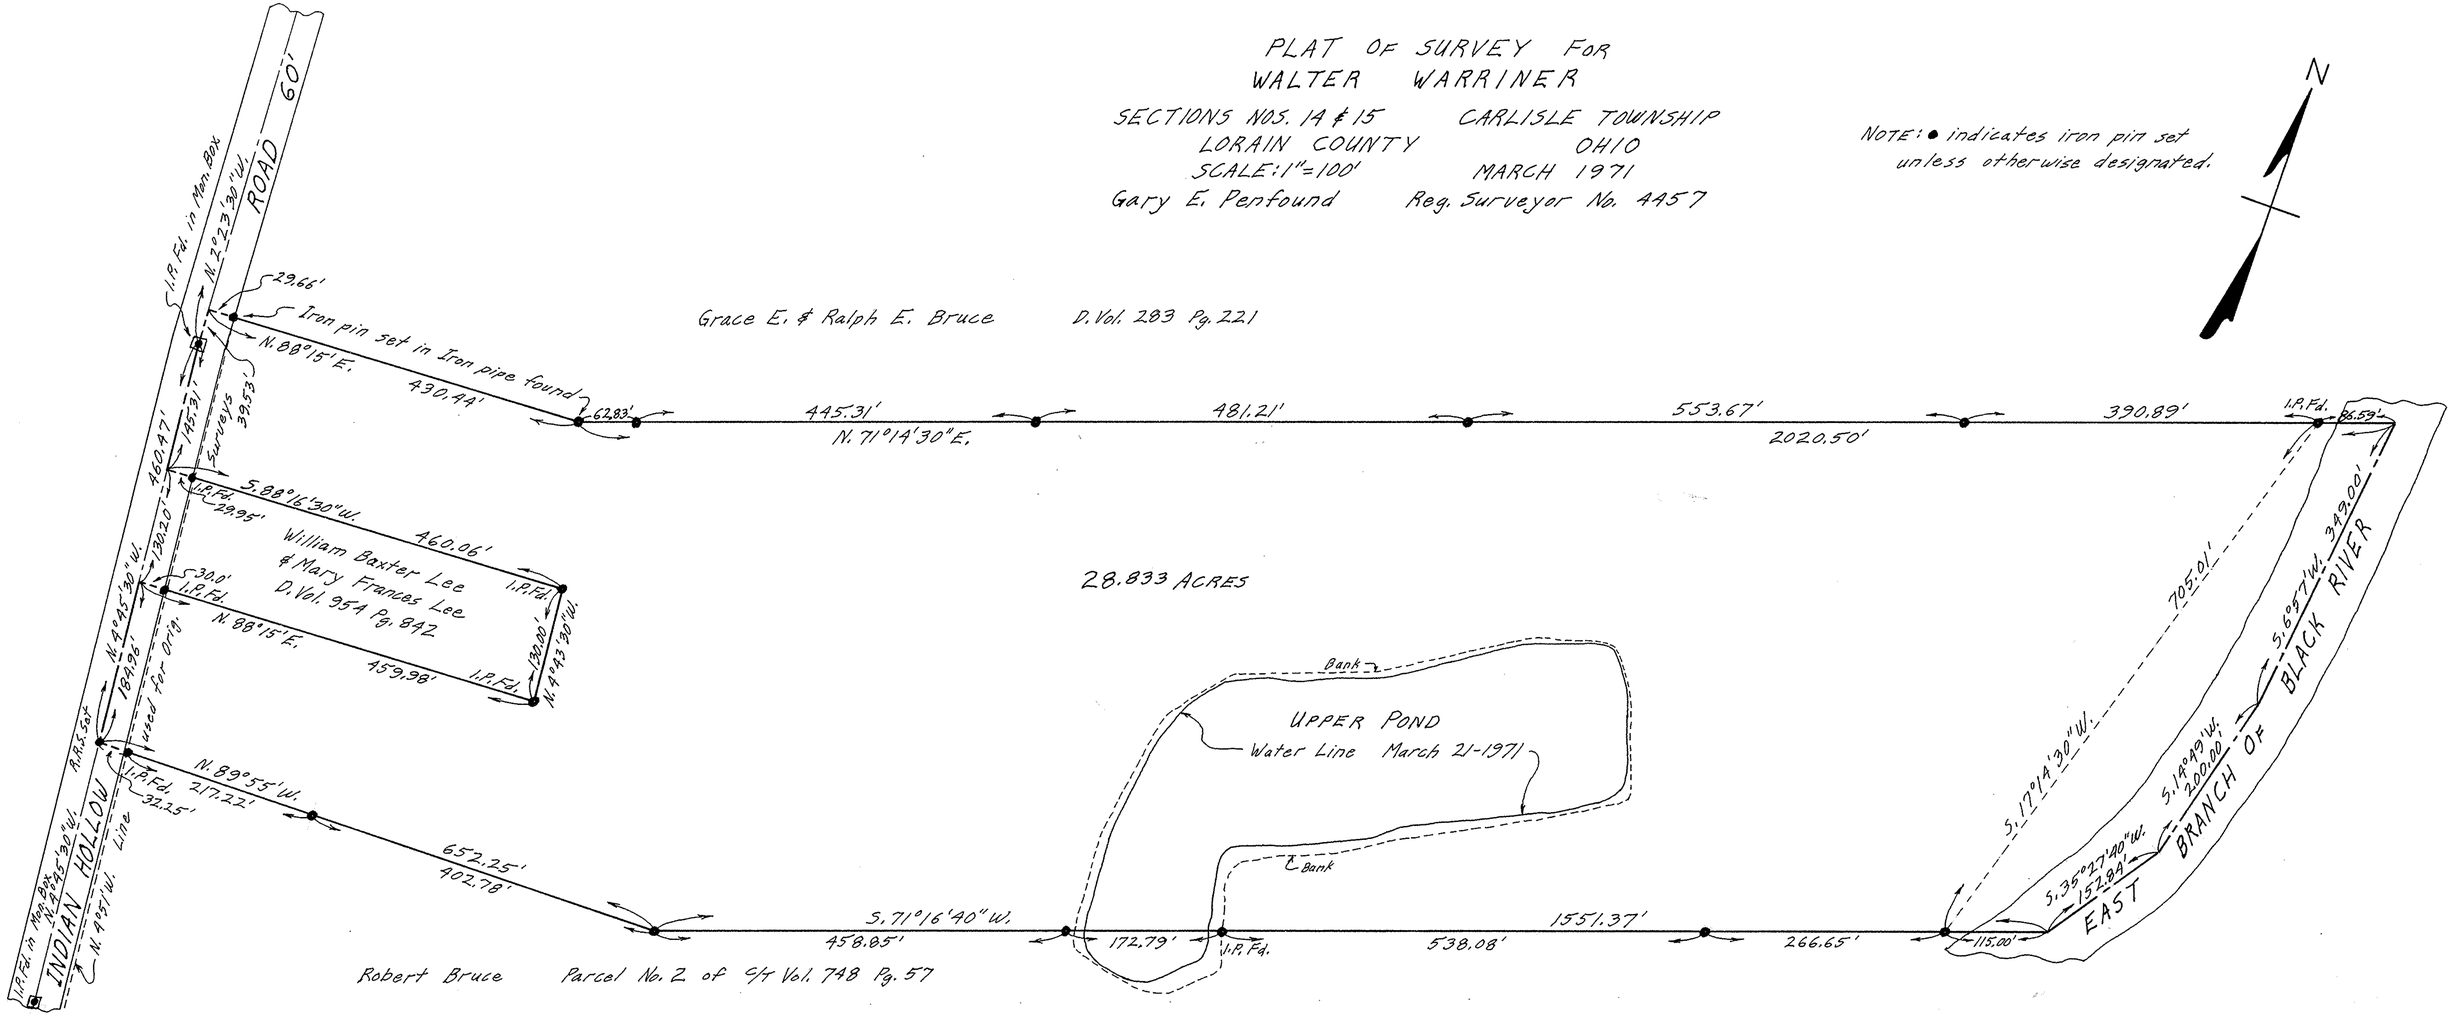

10-00-014,015