NOTE: ● indicates iron pin previously set unless otherwise designated.

MAP OF SURVEY OF SUB-LOT NO. 1
ROBSON ROAD SUBDIVISION (PROPOSED)

PART OF SECTION NO. 6 - CARLISLE TWP.
LORAIN COUNTY OHIO
SCALE: 1" = 30' OCTOBER 9-1969 5:45 P.M.
Gary E. Penfound REG. SURVEYOR NO. 4457

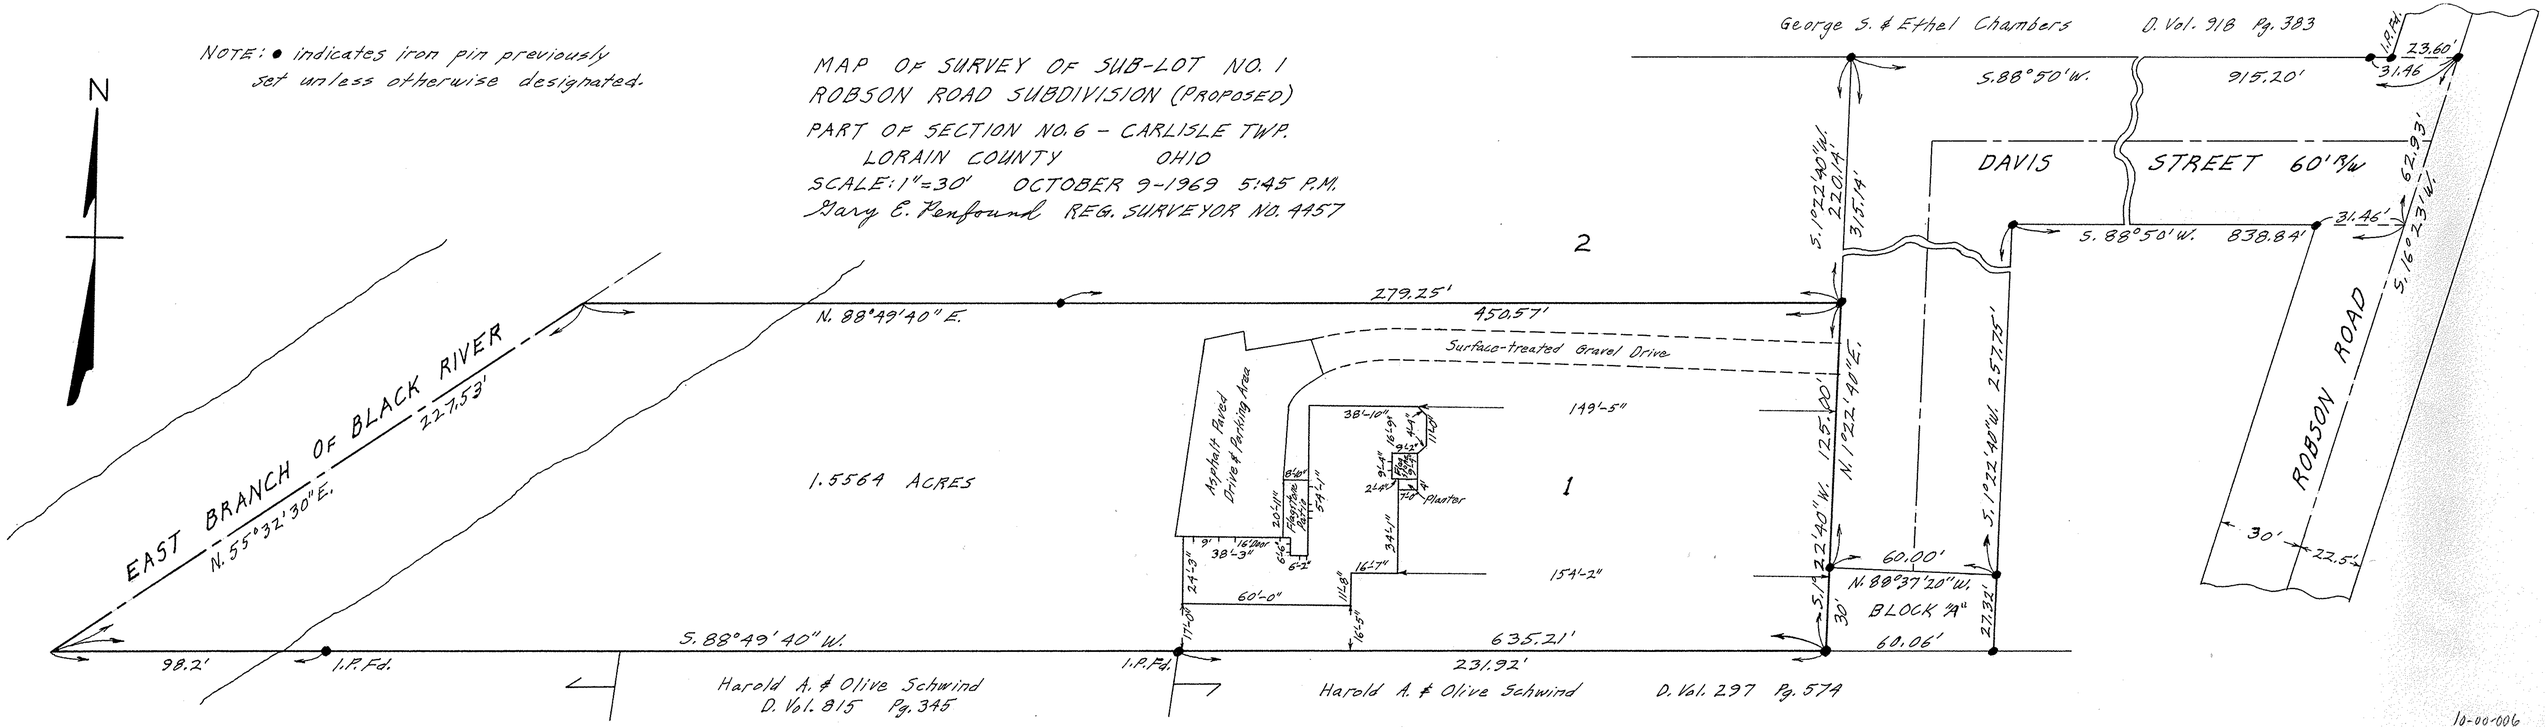

10-00-006