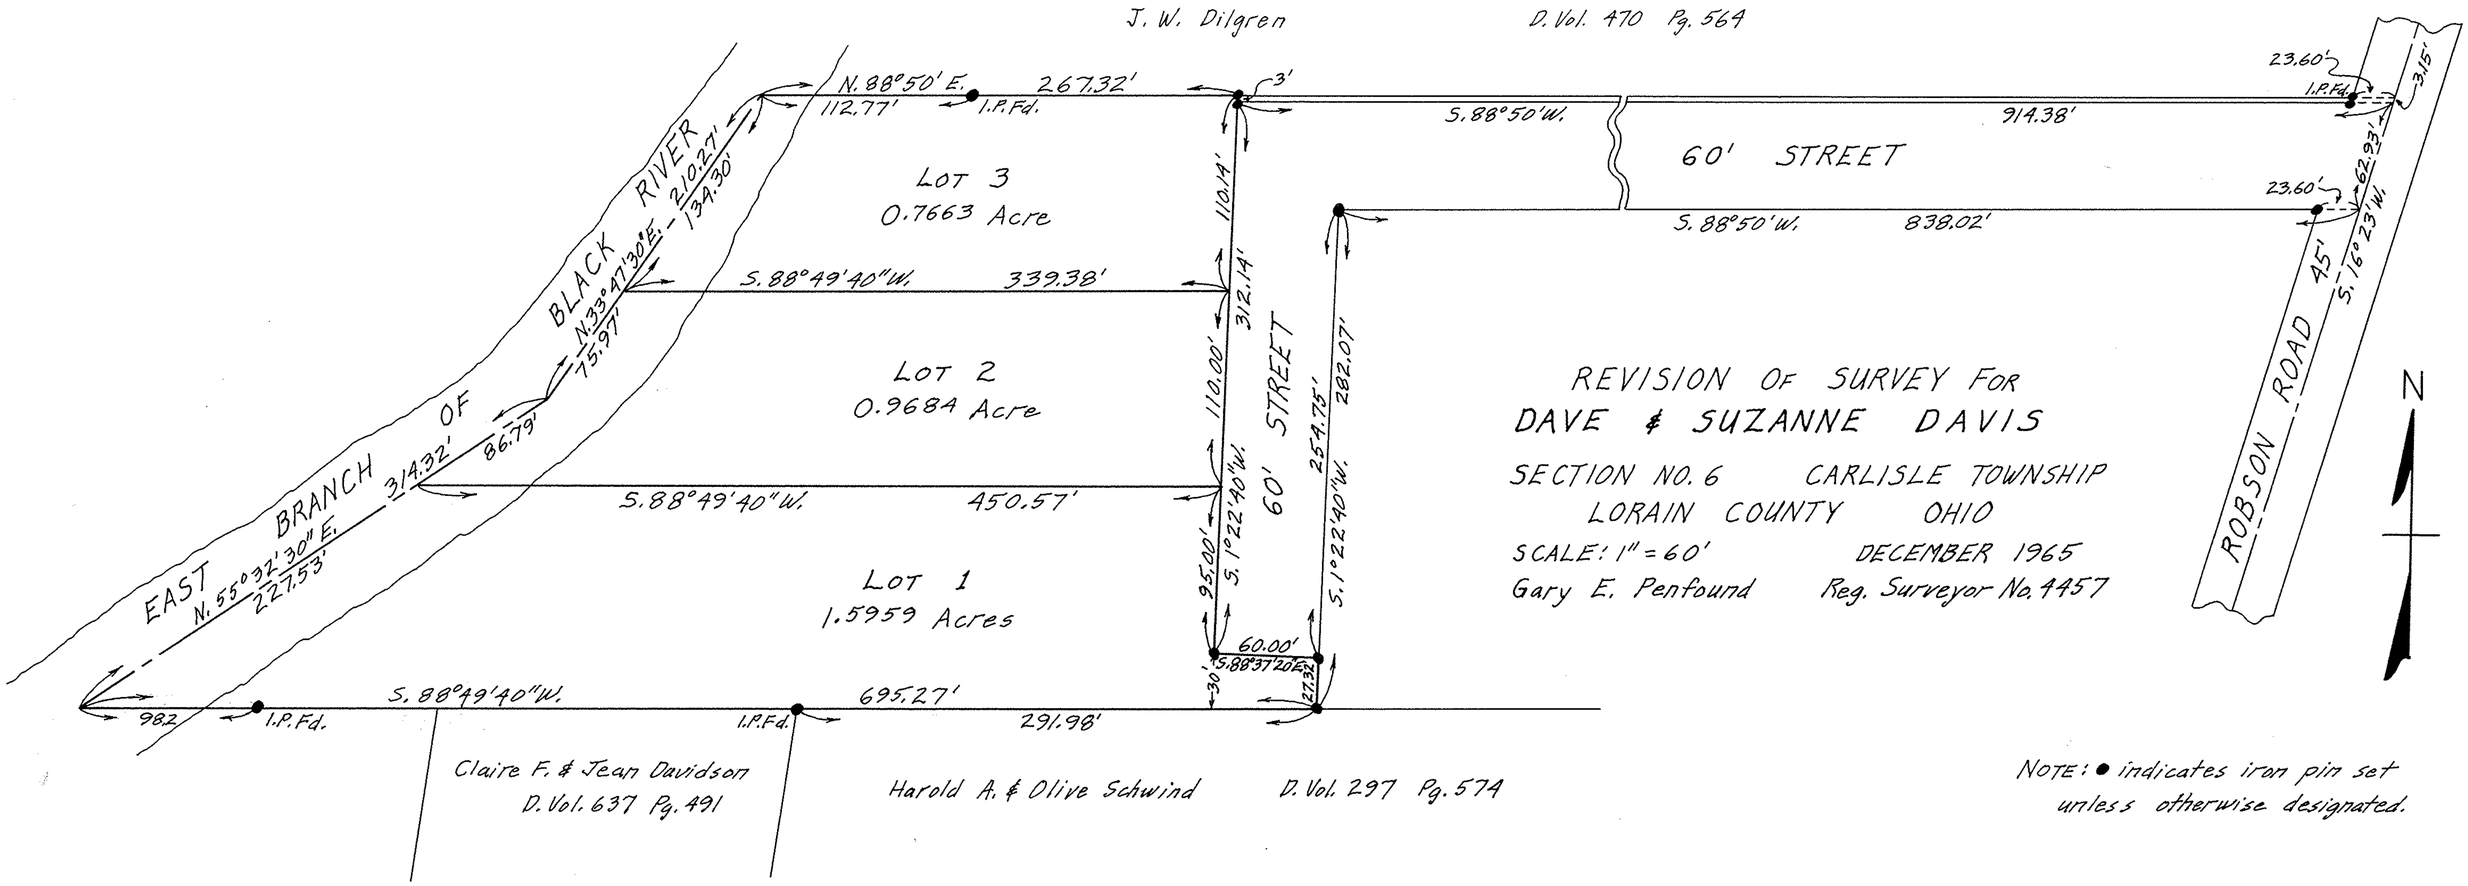
J. W. Dilgren
D. Vol. 470 Pg. 564
N. 88°50' E.
267.32'
112.77'
I.P.Fd.
3'
S. 88°50' W.
914.38'
23.60'
I.P.Fd.
3.15'
60' STREET
23.60'
62.93'
S. 88°50' W.
838.02'
S. 16°23' W.
ROBSON ROAD 45'
LOT 3
0.7663 Acre
110.14'
S. 88°49'40" W.
339.38'
312.14'
BLACK RIVER
N. 33°47'30" E. - 210.27'
134.30'
75.97'
86.79'
LOT 2
0.9684 Acre
110.00'
60' STREET
282.07'
254.75'
REVISION OF SURVEY FOR
DAVE & SUZANNE DAVIS
SECTION NO. 6 CARLISLE TOWNSHIP
LORAIN COUNTY OHIO
SCALE: 1" = 60' DECEMBER 1965
Gary E. Penfound Reg. Surveyor No. 4457
N
EAST BRANCH OF
314.32'
N. 55°32' 30" E.
227.53'
S. 88°49'40" W.
450.57'
S. 1°22'40" W.
95.00'
S. 1°22'40" W.
LOT 1
1.5959 Acres
60.00'
S. 88°37'20" E.
30'
27.32'
S. 88°49'40" W.
695.27'
98.2
I.P.Fd.
I.P.Fd.
291.98'
Claire F. & Jean Davidson
D. Vol. 637 Pg. 491
Harold A. & Olive Schwind
D. Vol. 297 Pg. 574
NOTE: ● indicates iron pin set
unless otherwise designated.

10-00-006