PLAT OF SURVEY FOR
WILBUR A. & RUTH SHUSTER
SECTION 6 CARLISLE TOWNSHIP
LORAIN COUNTY OHIO
SCALE: 1" = 60' AUGUST 25-1960

Gary E. Penfound Reg. Surveyor No. 4957

REVISED FOR REN M. KENNELLY – Nov. 6, 1967

NOTE: ● indicates iron pin set unless otherwise designated.

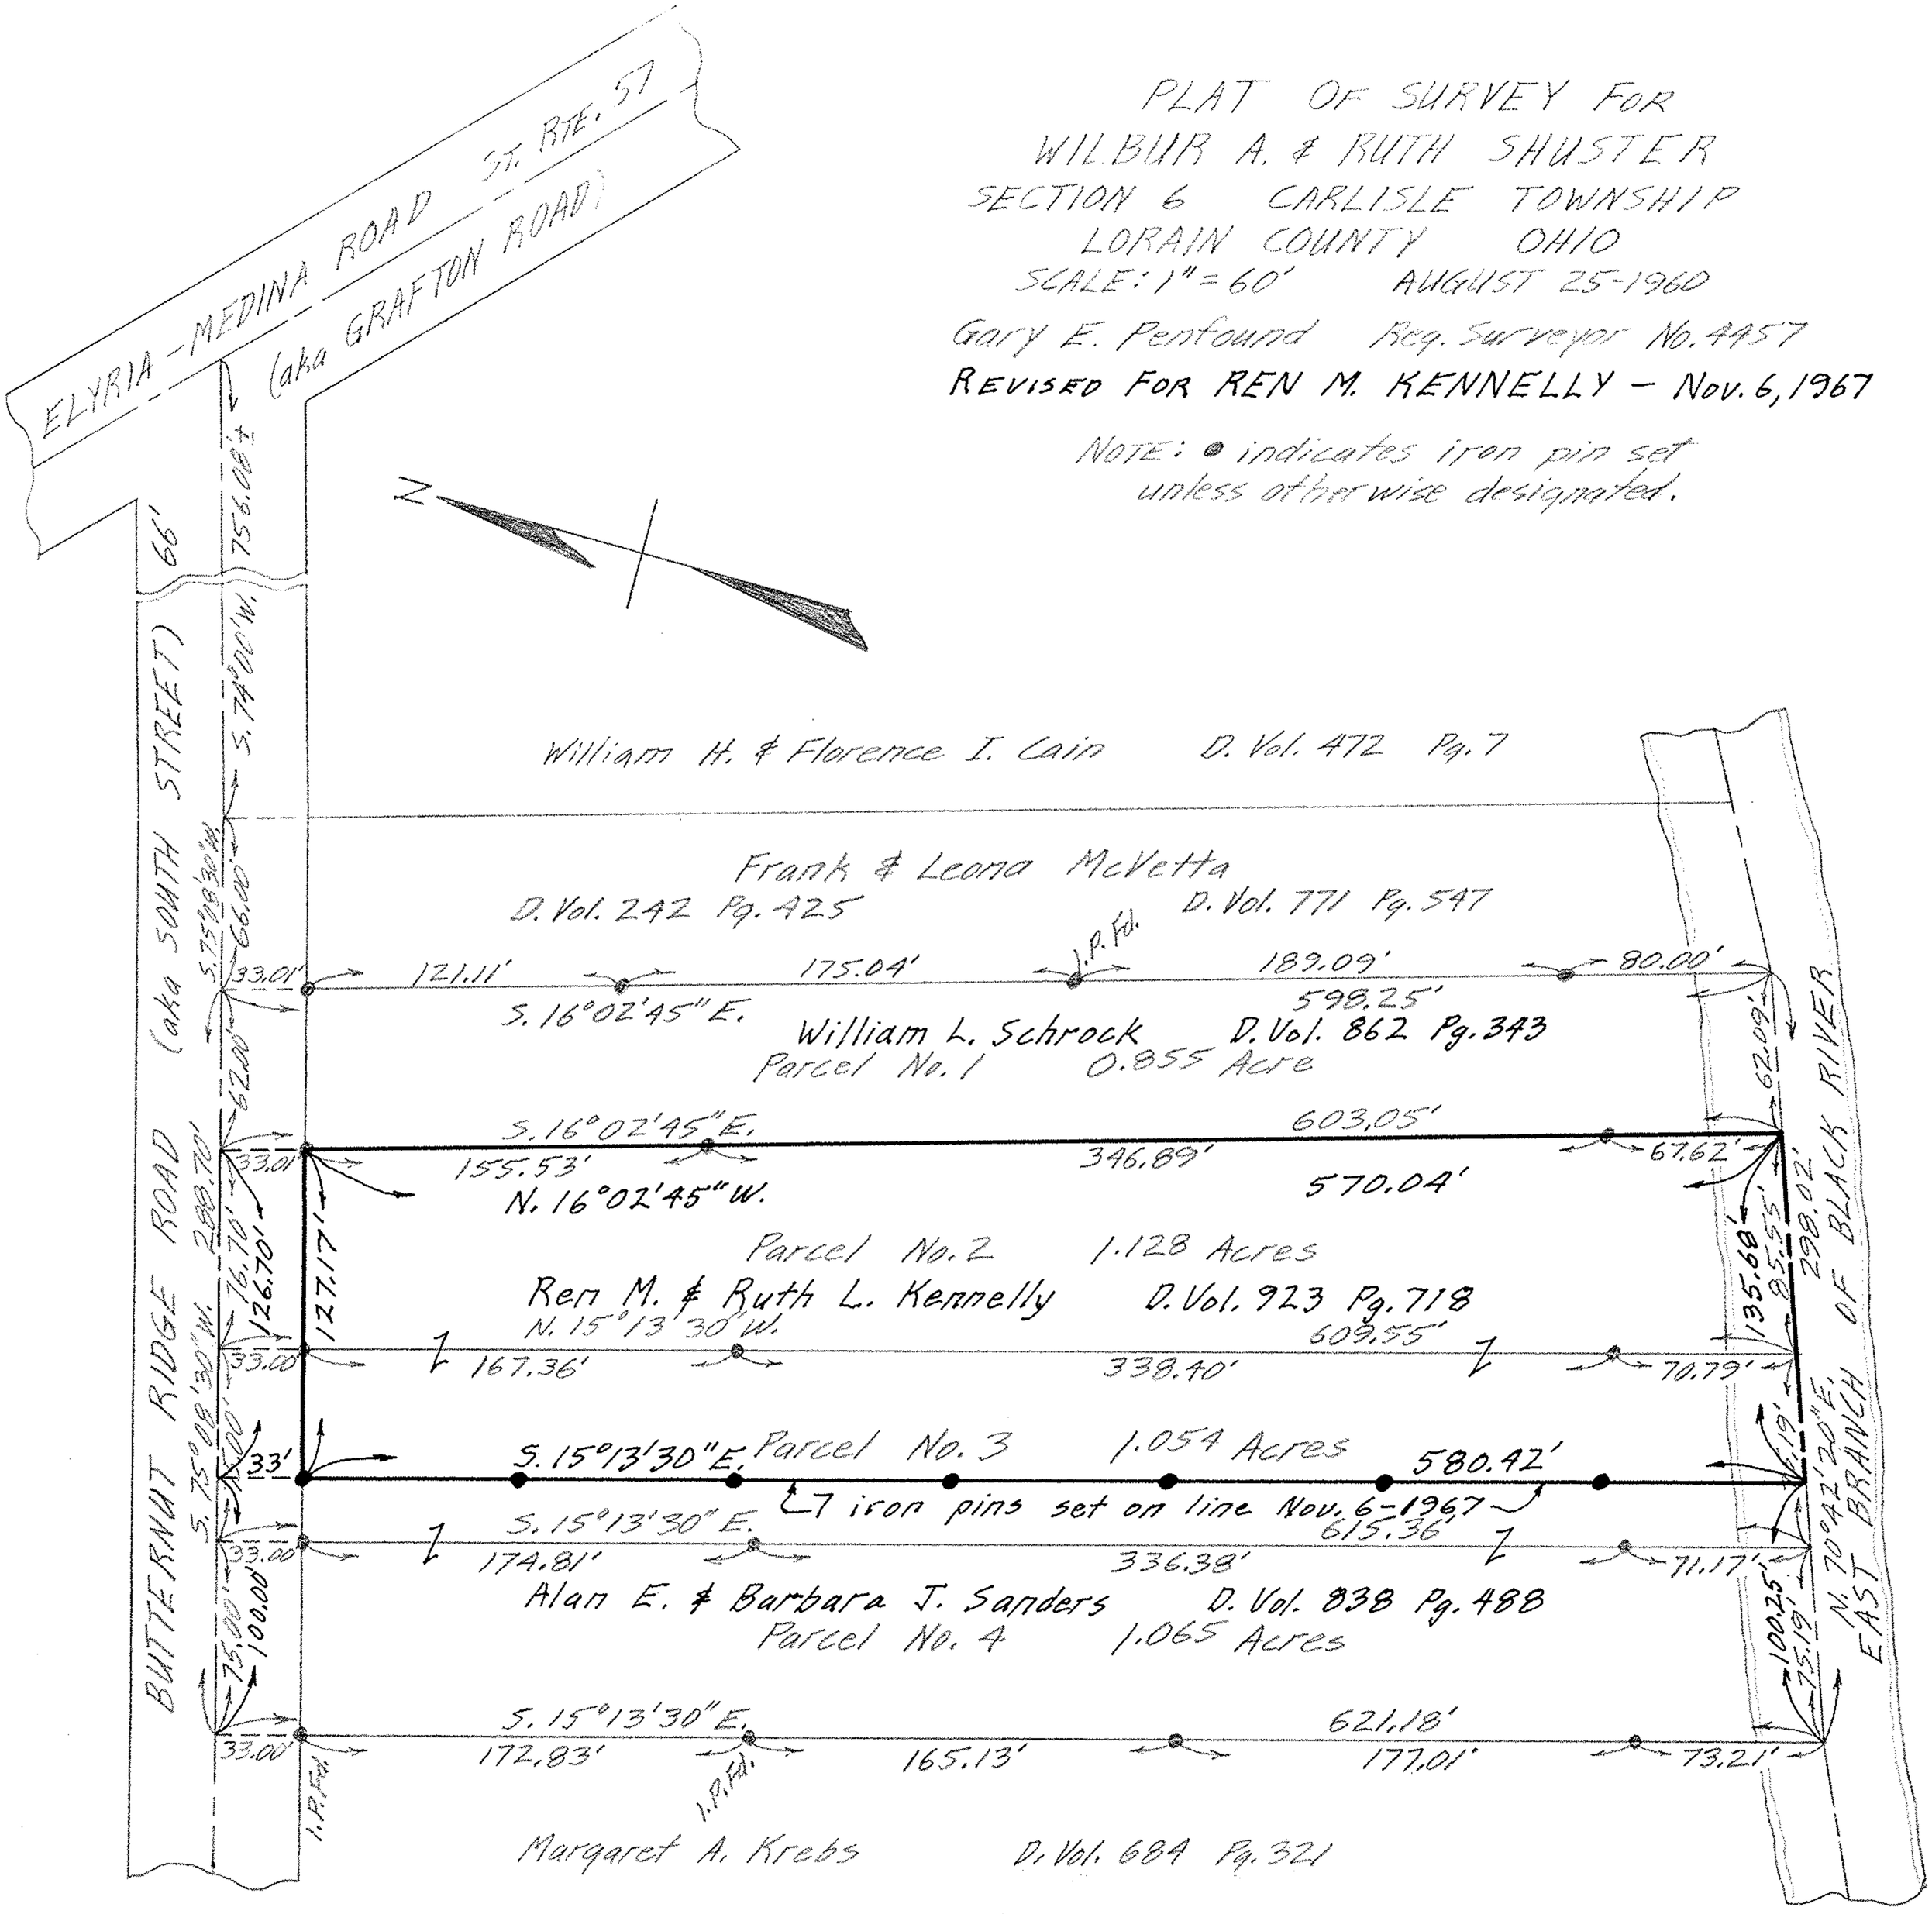

10-00-006