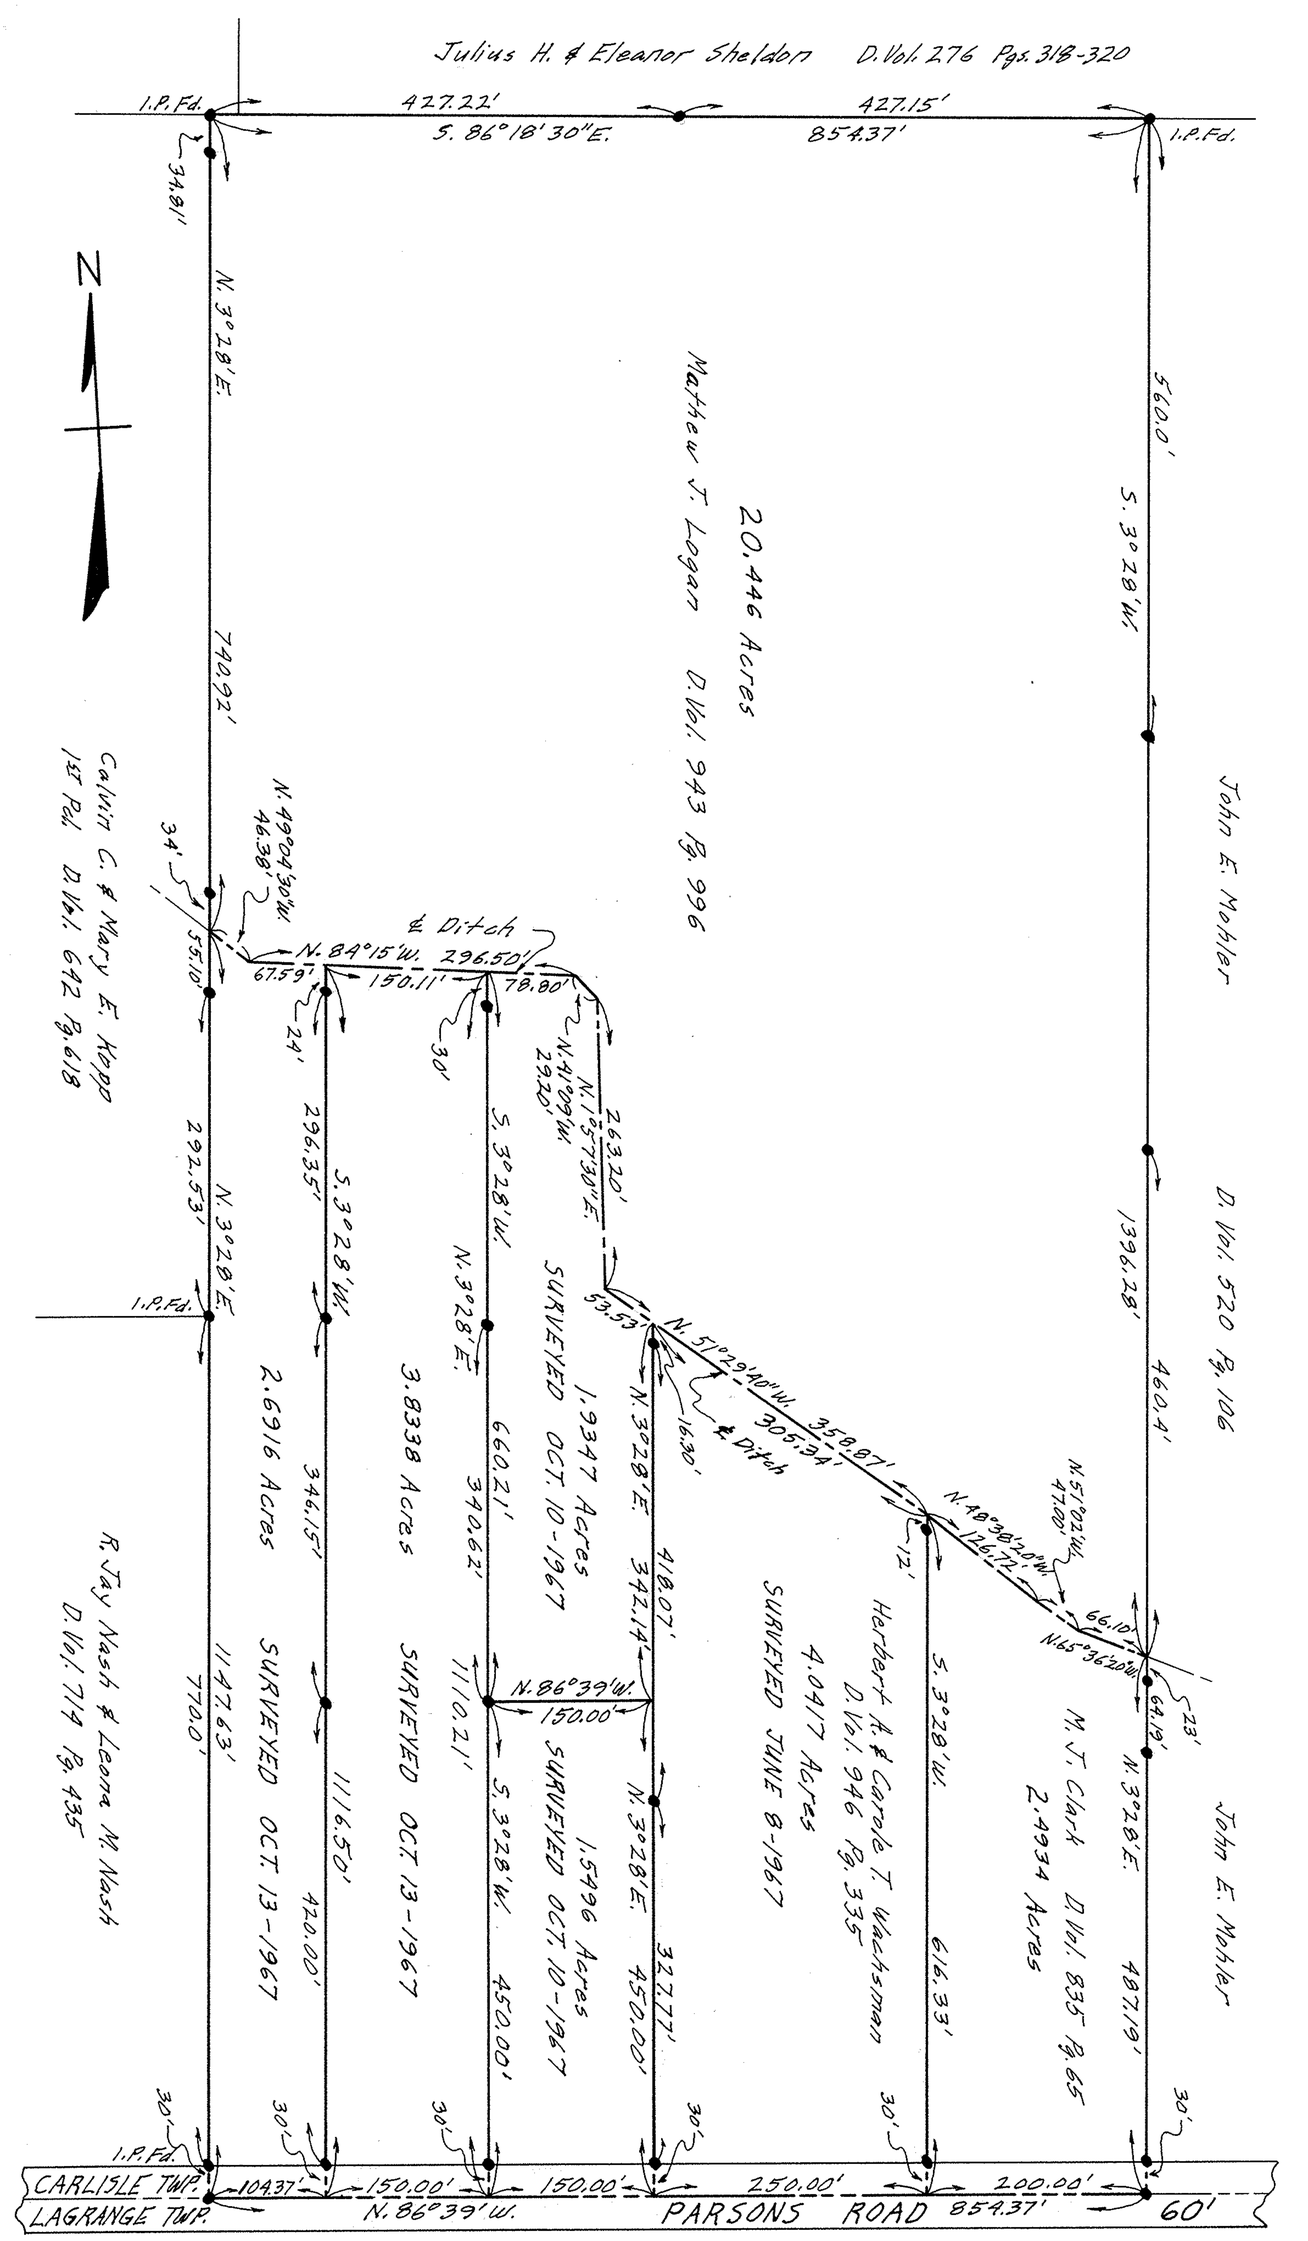

PLAT OF SURVEYS FOR
KENNETH W. HEBEBRAND
SECTION NO. 24 CARLISLE TWP.
LORAIN COUNTY OHIO
SCALE: 1" = 100' APRIL 1967
Gary E. Penfound Reg. Surveyor No. 4957

NOTE: ● indicates iron pin set unless otherwise designated.

10-00-024