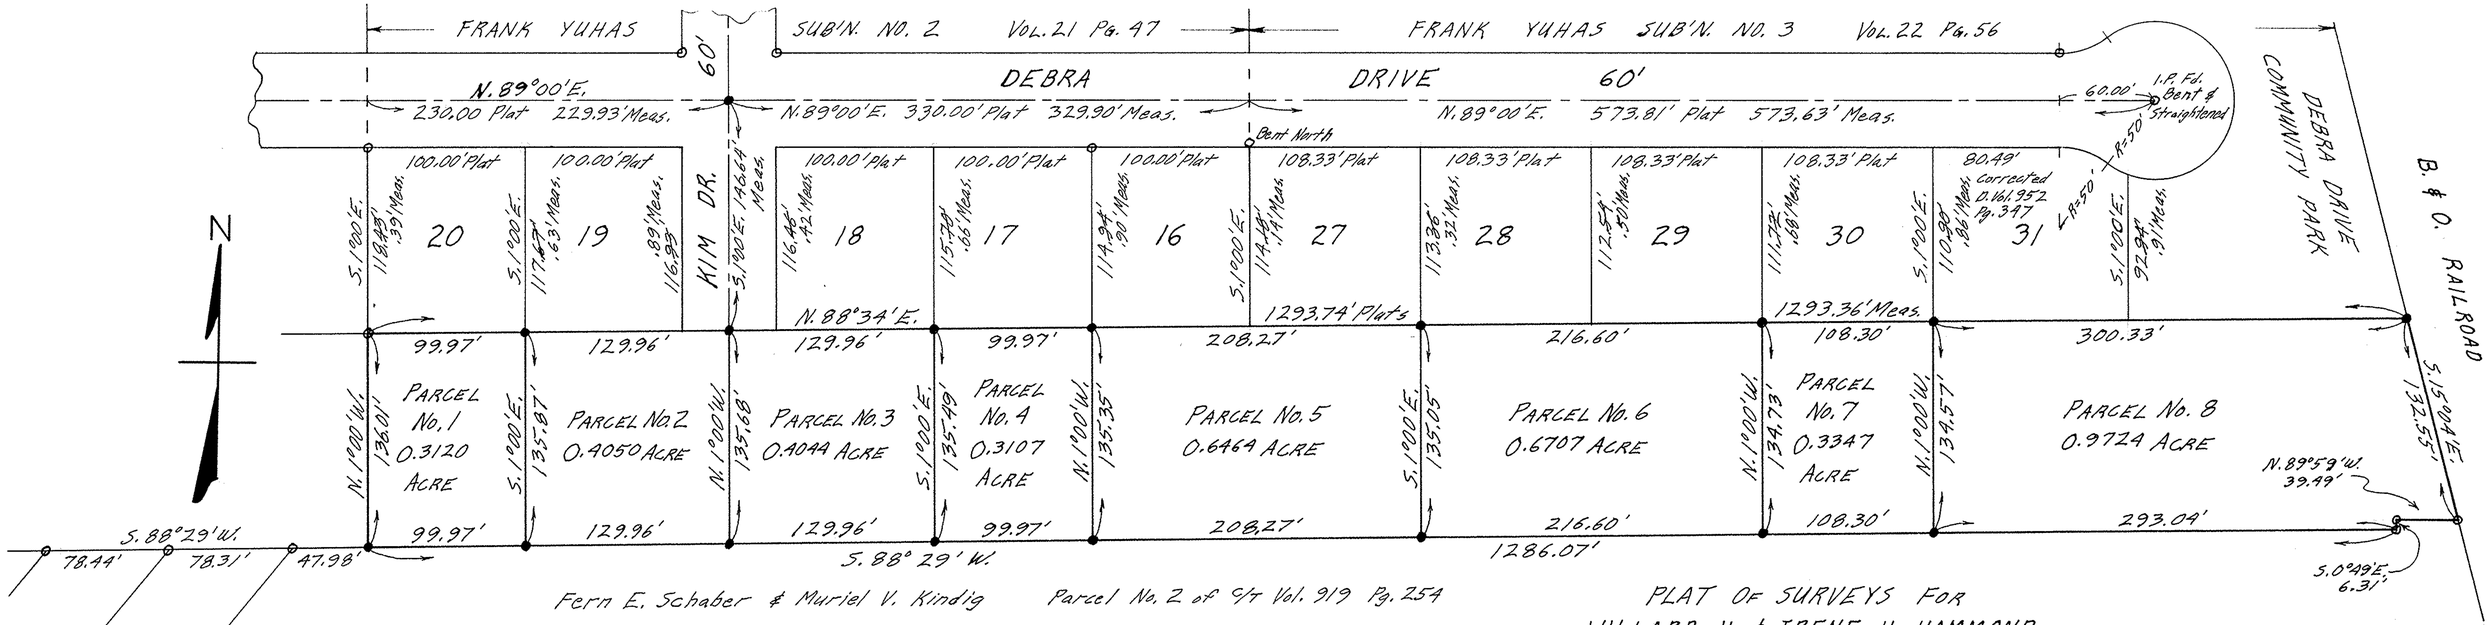

Fern E. Schaber & Muriel V. Kindig Parcel No. 2 of S/T Vol. 919 Pg. 254

NOTES: O indicates iron pin found and used.
● indicates iron pin set.
A shortage of 0.03' per 100' was found to exist in Subdivisions as orginally surveyed and monumented.

PLAT OF SURVEYS FOR
WILLARD H. & IRENE H. HAMMOND
DIVISION OF 4.056 ACRES IN ORIGINAL LOT NO. 8
BRACE TRACT ELYRIA TOWNSHIP
LORAIN COUNTY OHIO
SCALE: 1" = 60' OCTOBER 1970
Gary E. Penfound Reg. Surveyor No. 4457

06-23-008