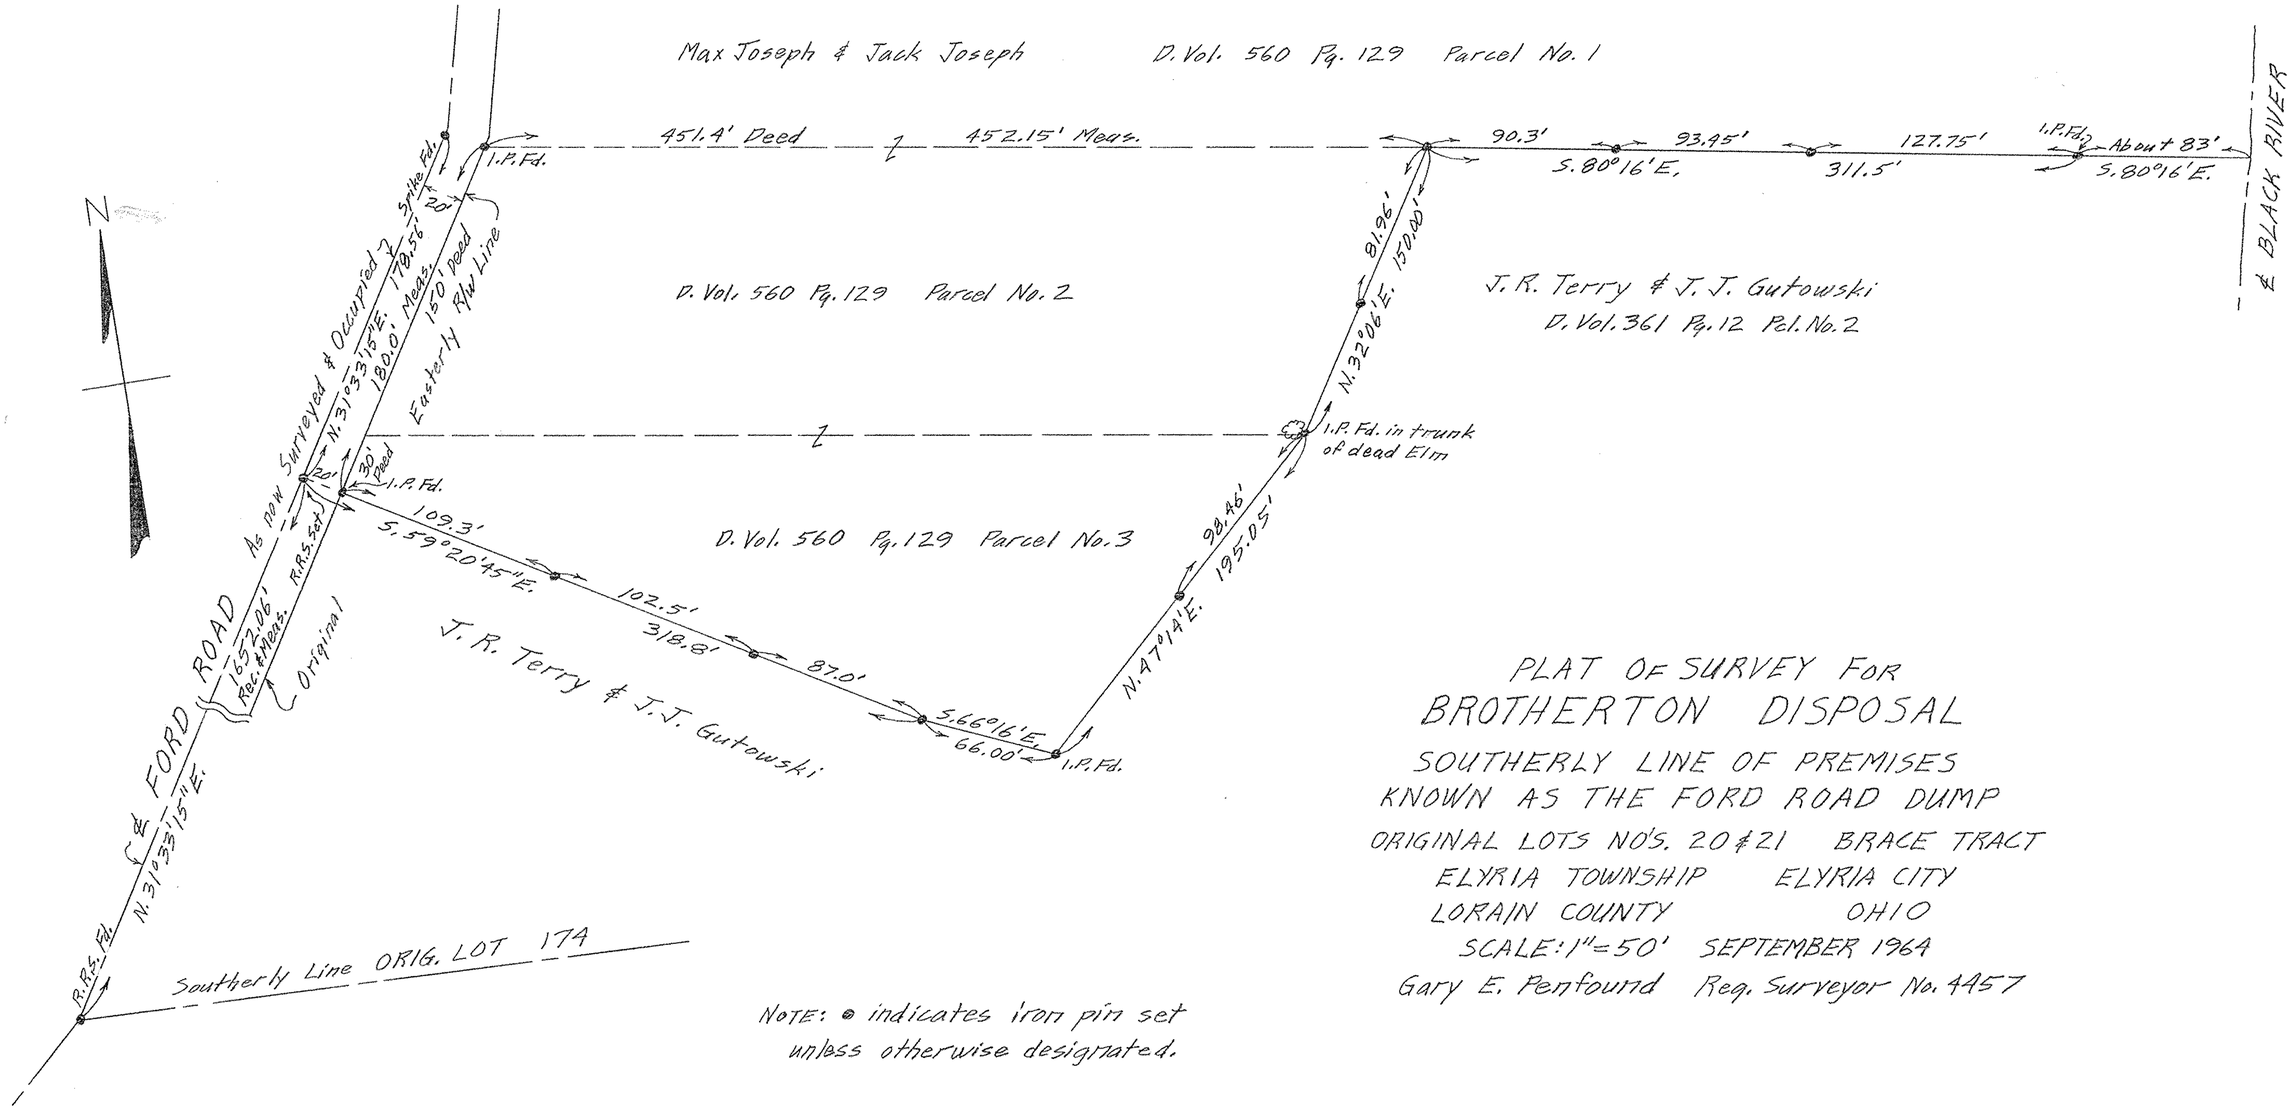

PLAT OF SURVEY FOR BROTHERTON DISPOSAL

SOUTHERLY LINE OF PREMISES
KNOWN AS THE FORD ROAD DUMP

ORIGINAL LOTS NO'S. 20 & 21 BRACE TRACT
ELYRIA TOWNSHIP ELYRIA CITY
LORAIN COUNTY OHIO
SCALE: 1" = 50' SEPTEMBER 1964
Gary E. Penfound Reg. Surveyor No. 4457

NOTE: ⊙ indicates iron pin set unless otherwise designated.

06-23-020,201