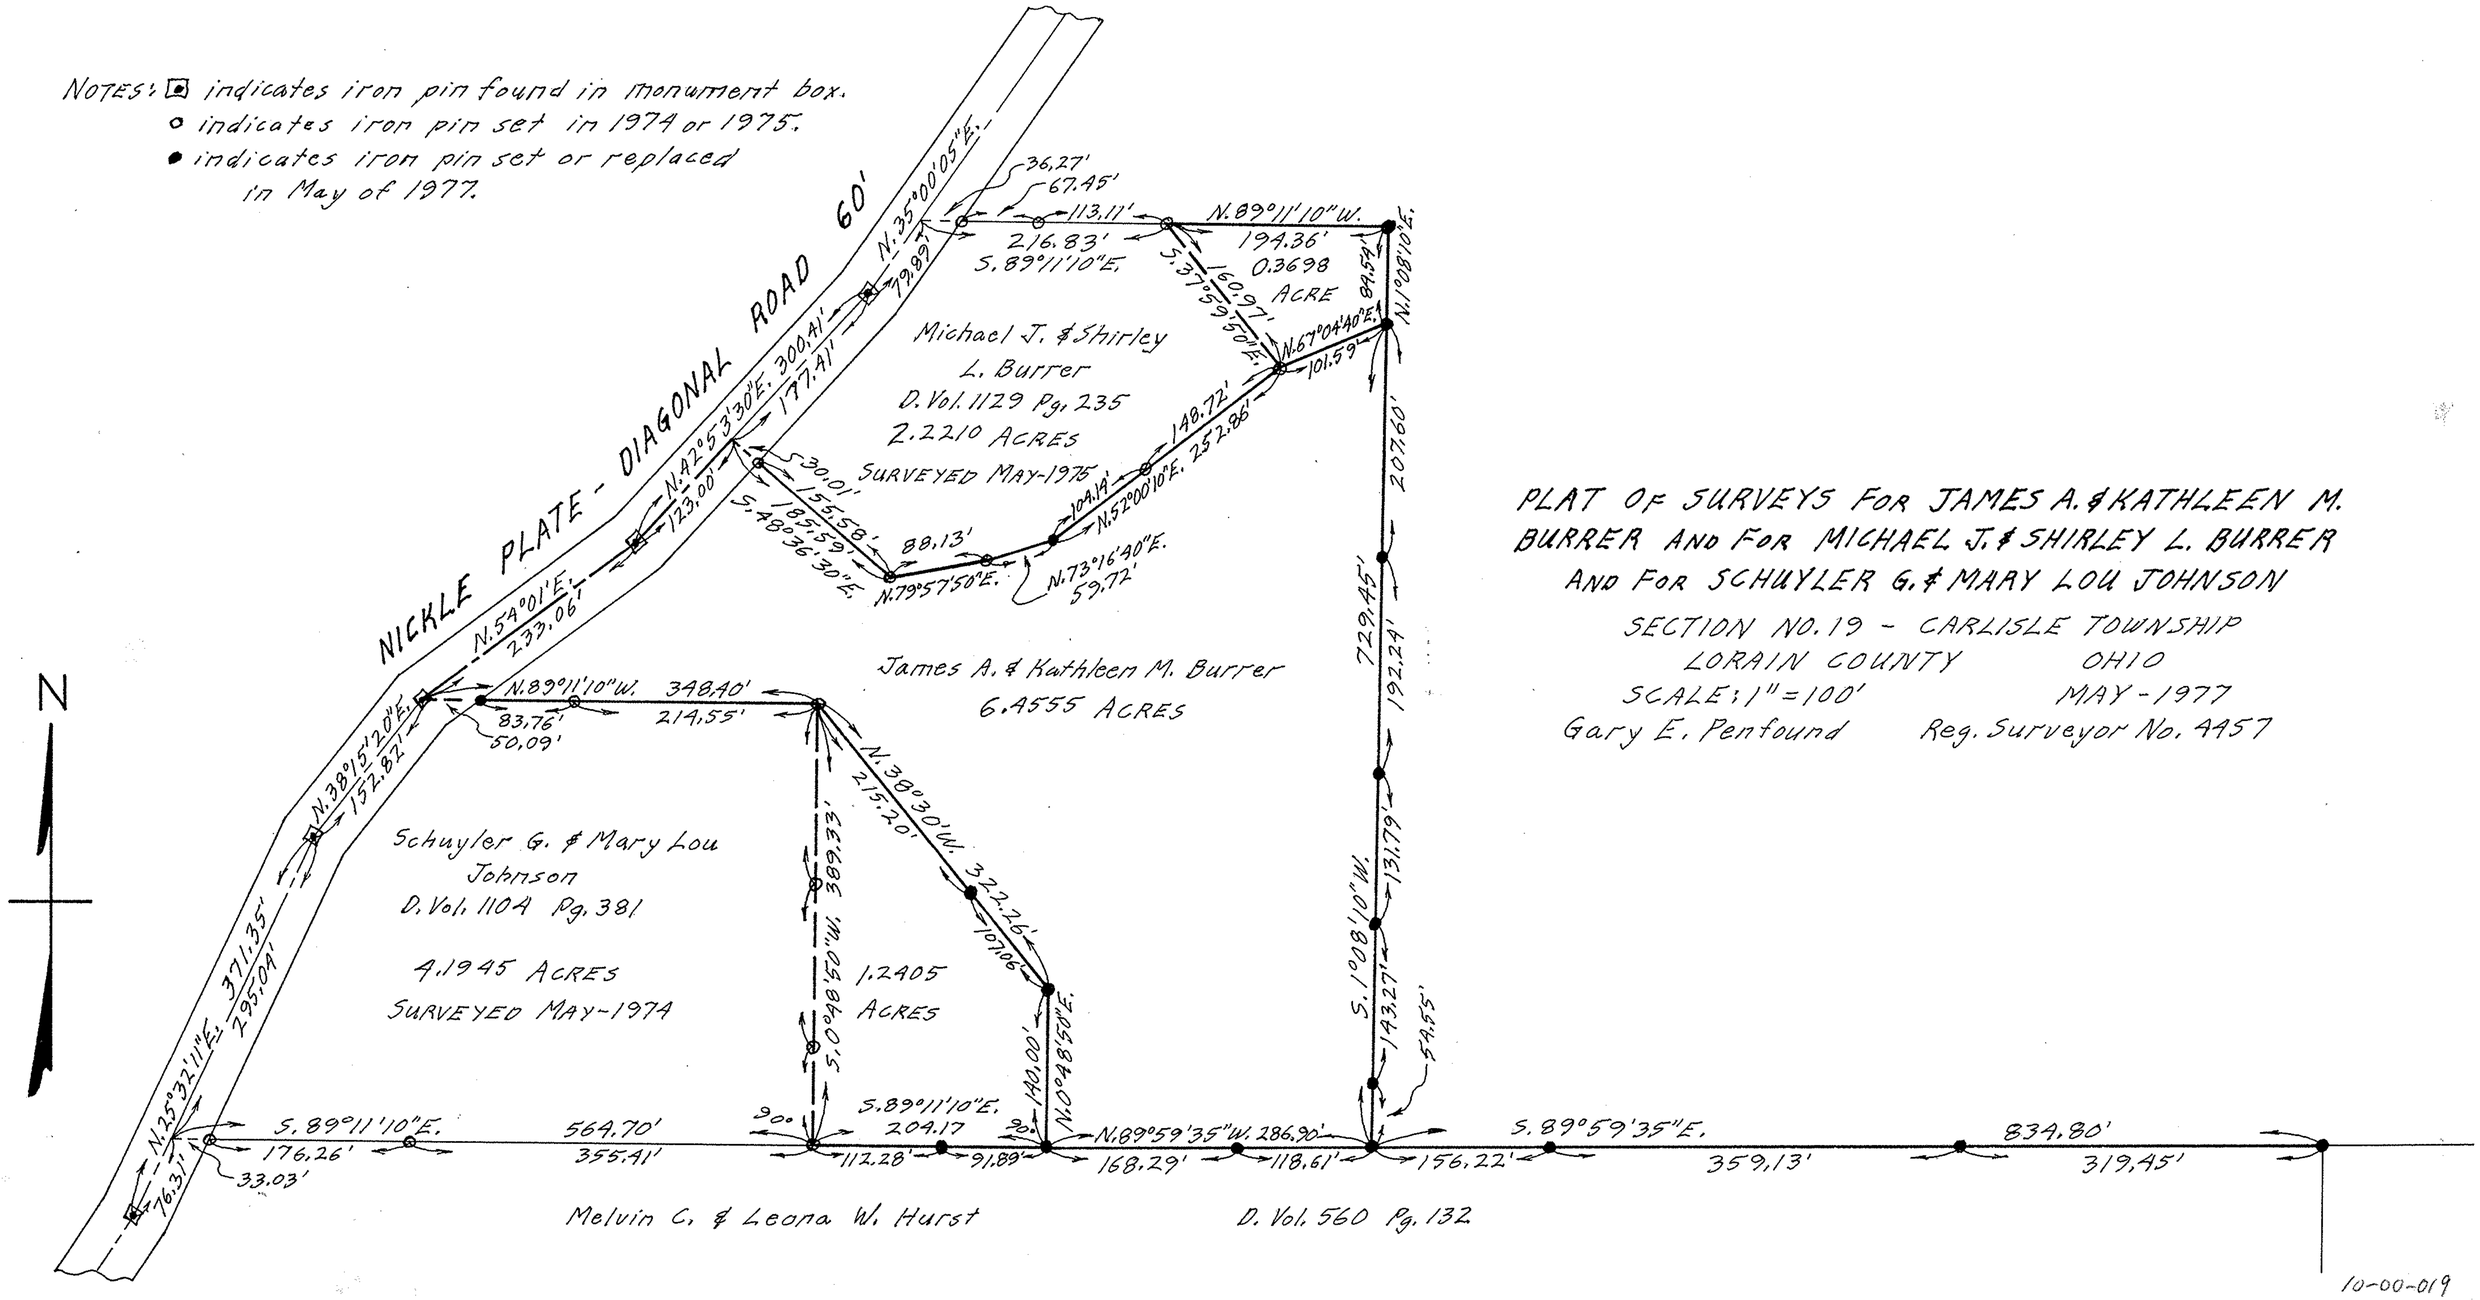
NOTES: ⊡ indicates iron pin found in monument box.
o indicates iron pin set in 1974 or 1975.
• indicates iron pin set or replaced in May of 1977.
NICKLE PLATE - DIAGONAL ROAD 60'
N. 35°00'05"E. 79.89'
36.27'
67.45'
113.11'
216.83'
S. 89°11'10"E.
N. 89°11'10"W.
194.36'
0.3698 ACRE
S. 37°59'50"E. 160.97'
N. 1°08'10"E. 89.54'
N. 67°04'40"E. 101.59'
Michael J. & Shirley L. Burrer
D. Vol. 1129 Pg. 235
2.2210 ACRES
SURVEYED MAY-1975
N. 42°53'30"E. 300.41'
177.41'
123.00'
30.01'
155.58'
S. 48°36'30"E. 185.59'
88.13'
N. 79°57'50"E.
104.14'
N. 52°00'10"E. 252.86'
148.72'
N. 73°16'40"E. 59.72'
207.60'
729.45'
192.24'
131.79'
143.27'
S. 1°08'10"W.
54.55'
N. 54°01'E. 233.06'
James A. & Kathleen M. Burrer
6.4555 ACRES
N. 89°11'10"W. 348.40'
83.76'
214.55'
50.09'
N. 38°15'20"E. 152.82'
N. 38°30'W. 215.20'
322.26'
107.06'
Schuyler G. & Mary Lou Johnson
D. Vol. 110A Pg. 381
4.1945 ACRES
SURVEYED MAY-1974
389.33'
S. 0°48'50"W.
1.2405 ACRES
140.00'
N. 0°48'50"E.
N. 25°32'11"E. 371.35'
295.09'
76.31'
S. 89°11'10"E.
176.26'
33.03'
564.70'
355.41'
90°
S. 89°11'10"E.
209.17'
112.28'
91.89'
90°
N. 89°59'35"W. 286.90'
168.29'
118.61'
S. 89°59'35"E.
156.22'
359.13'
834.80'
319.45'
Melvin C. & Leona W. Hurst
D. Vol. 560 Pg. 132
N
PLAT OF SURVEYS FOR JAMES A. & KATHLEEN M. BURRER AND FOR MICHAEL J. & SHIRLEY L. BURRER AND FOR SCHUYLER G. & MARY LOU JOHNSON
SECTION NO. 19 - CARLISLE TOWNSHIP
LORAIN COUNTY OHIO
SCALE: 1" = 100' MAY - 1977
Gary E. Penfound Reg. Surveyor No. 4457
10-00-019