


Nicholas Horvath  
D. Vol. 340 PG 385 Feb 13-1945

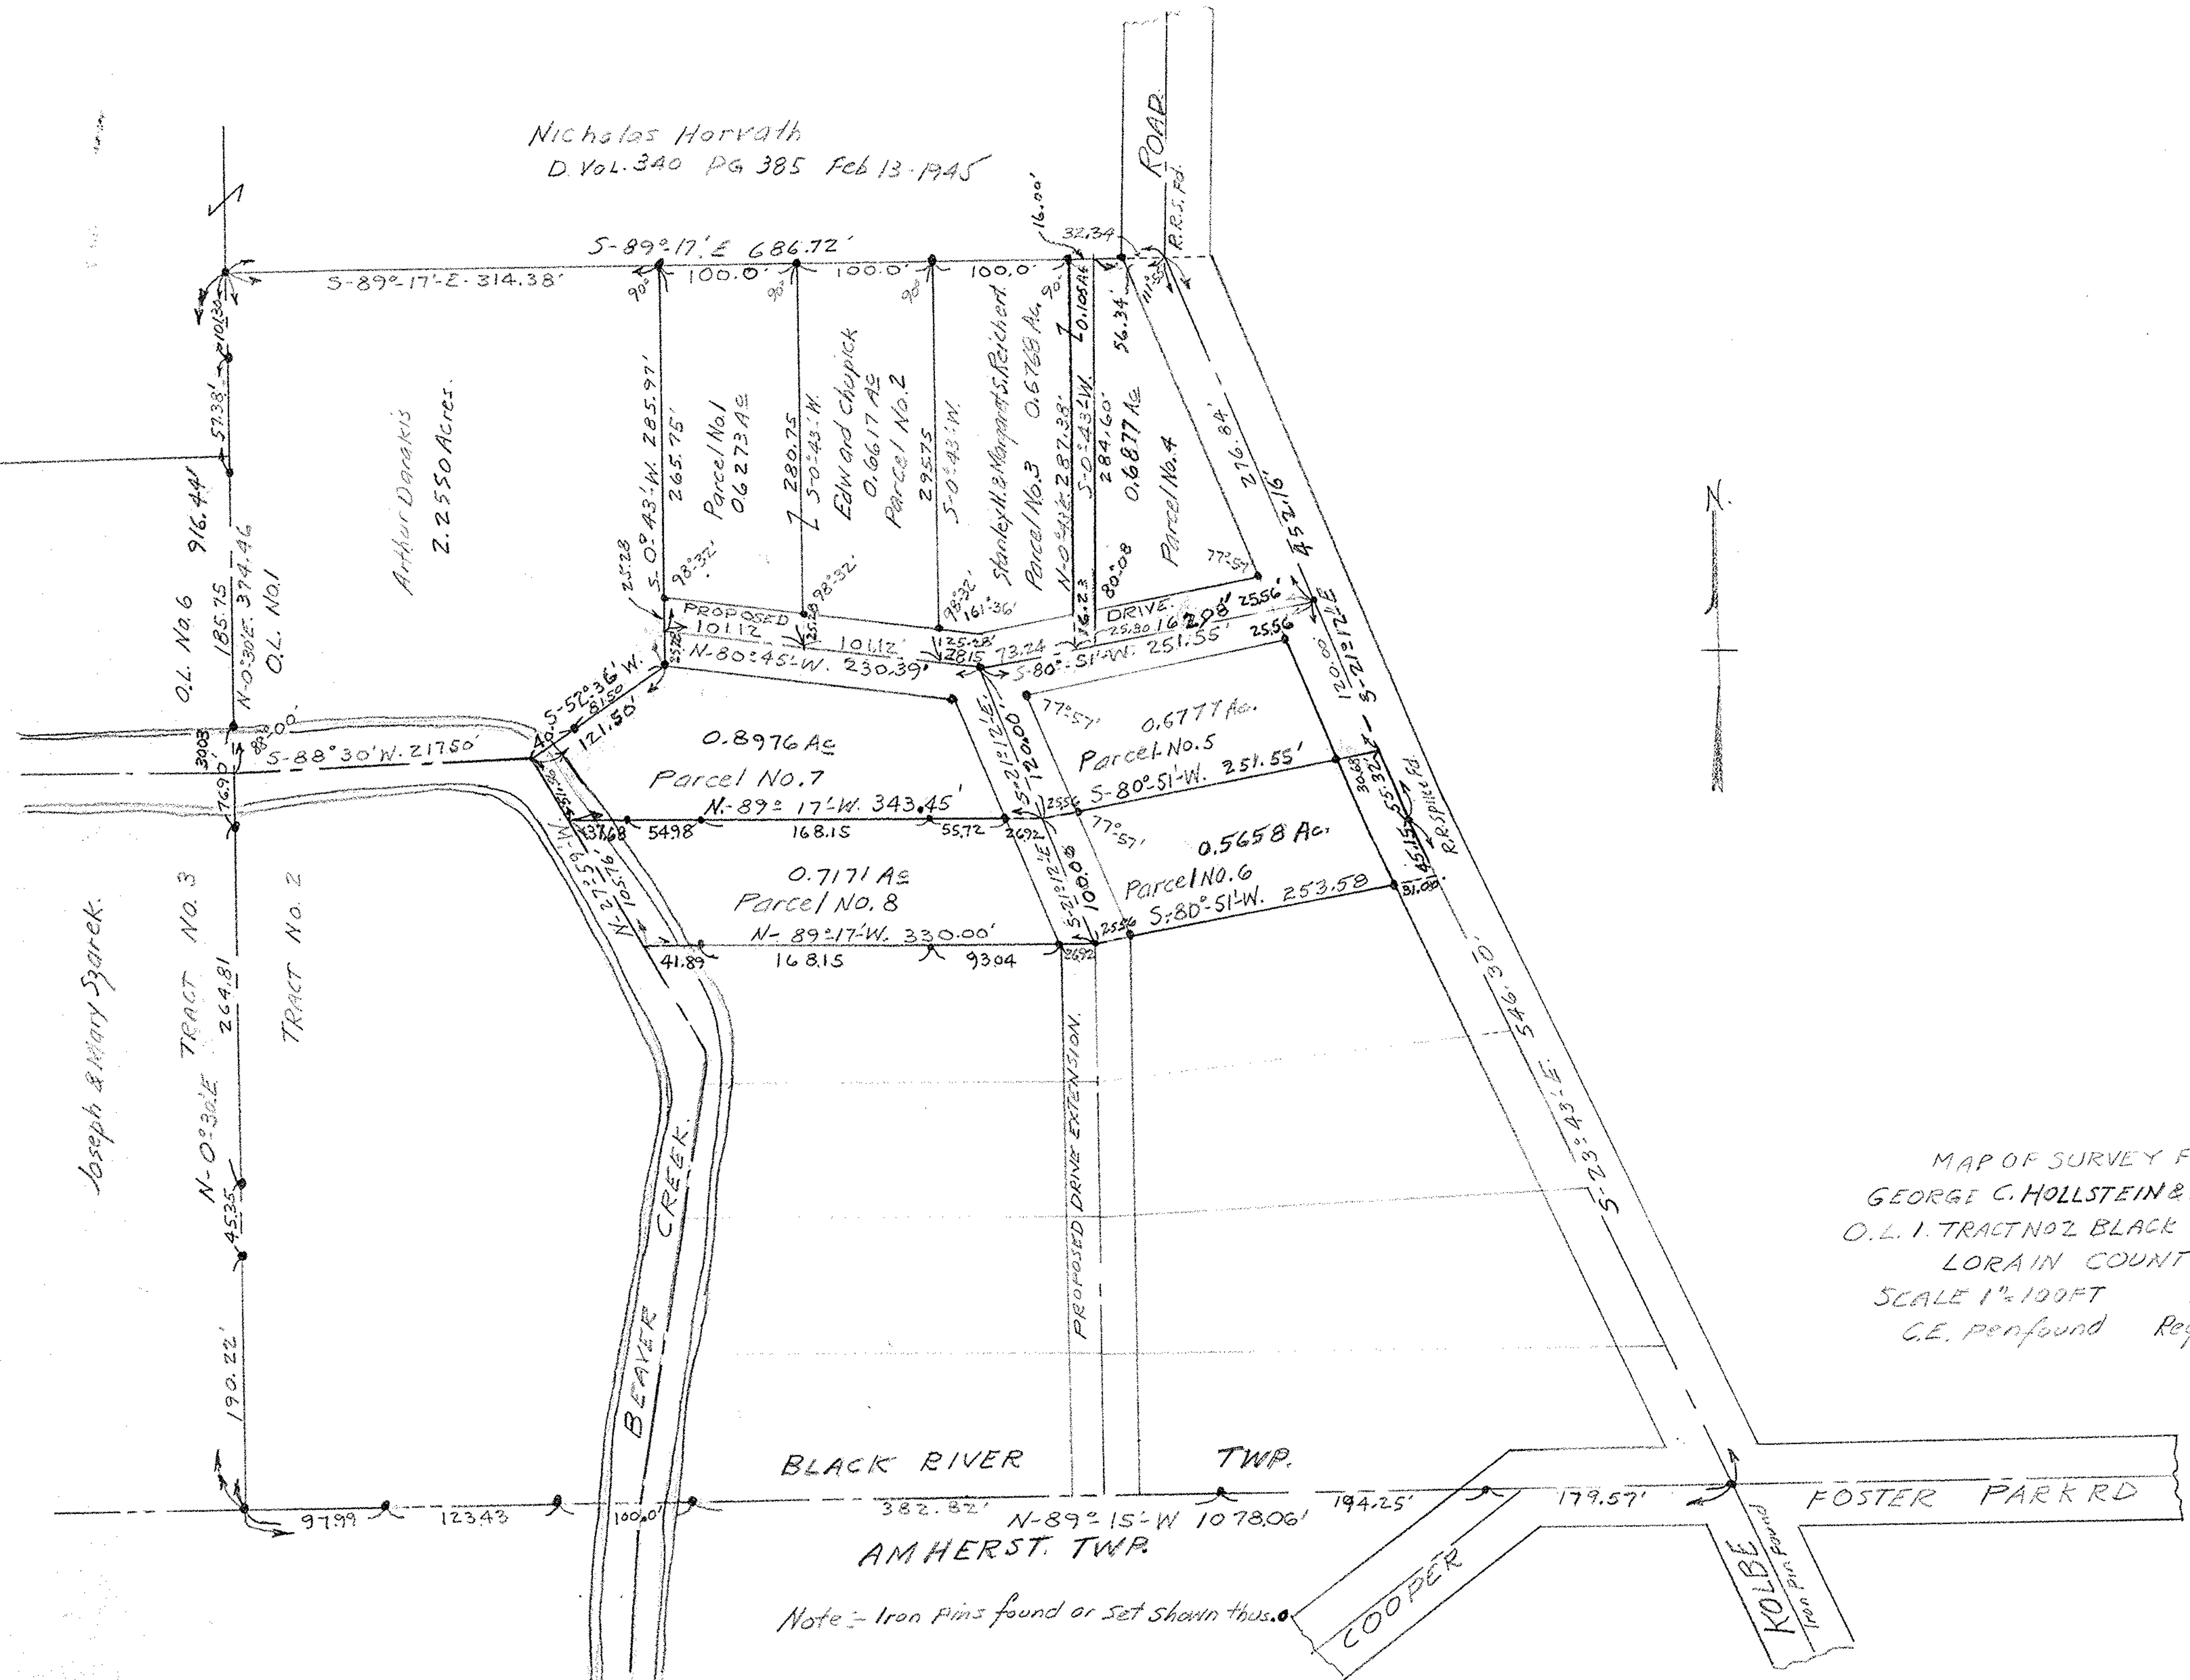

MAP OF SURVEY FOR  
 GEORGE C. HOLLSTEIN & ARTHUR DARAKIS  
 O.L. 1. TRACT NO. 2 BLACK RIVER TOWNSHIP  
 LORAIN COUNTY OHIO.  
 SCALE 1"=100 FT July 12-1950  
 C.E. Penfound Registered Surveyor

Note - Iron Pins found or Set shown thus.