


Minnie Handrosch D. Vol. 935 Pg. 245 Nov. 11, 1942

Minnie Handrosch

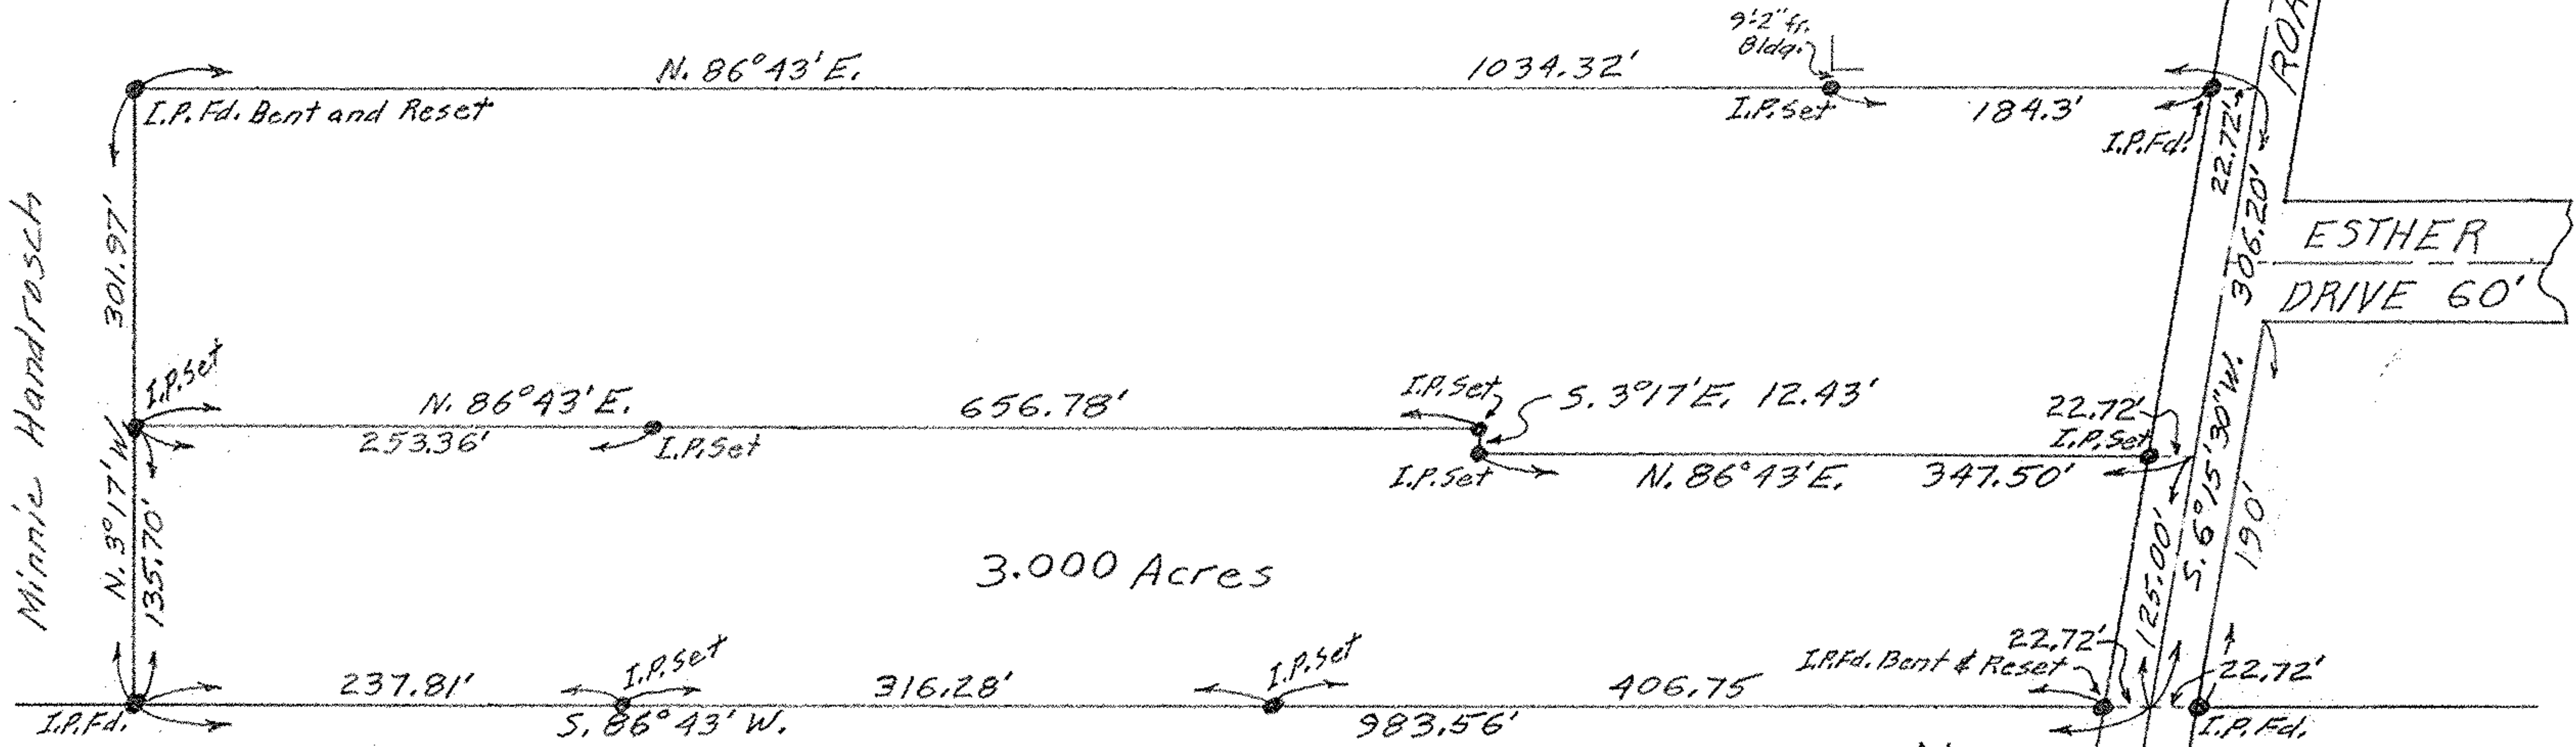

3.000 Acres

Agnes E. Christensen D. Vol. 603 Pg. 251

PLAT OF SURVEY FOR ANNA MARTHA HAMMERSTROM
SECTION 15 CARLISLE TOWNSHIP
LORAIN COUNTY - OHIO

SCALE: 1" = 100' MAY 26, 1958
GARY E. PENFOUND REG. SURVEYOR