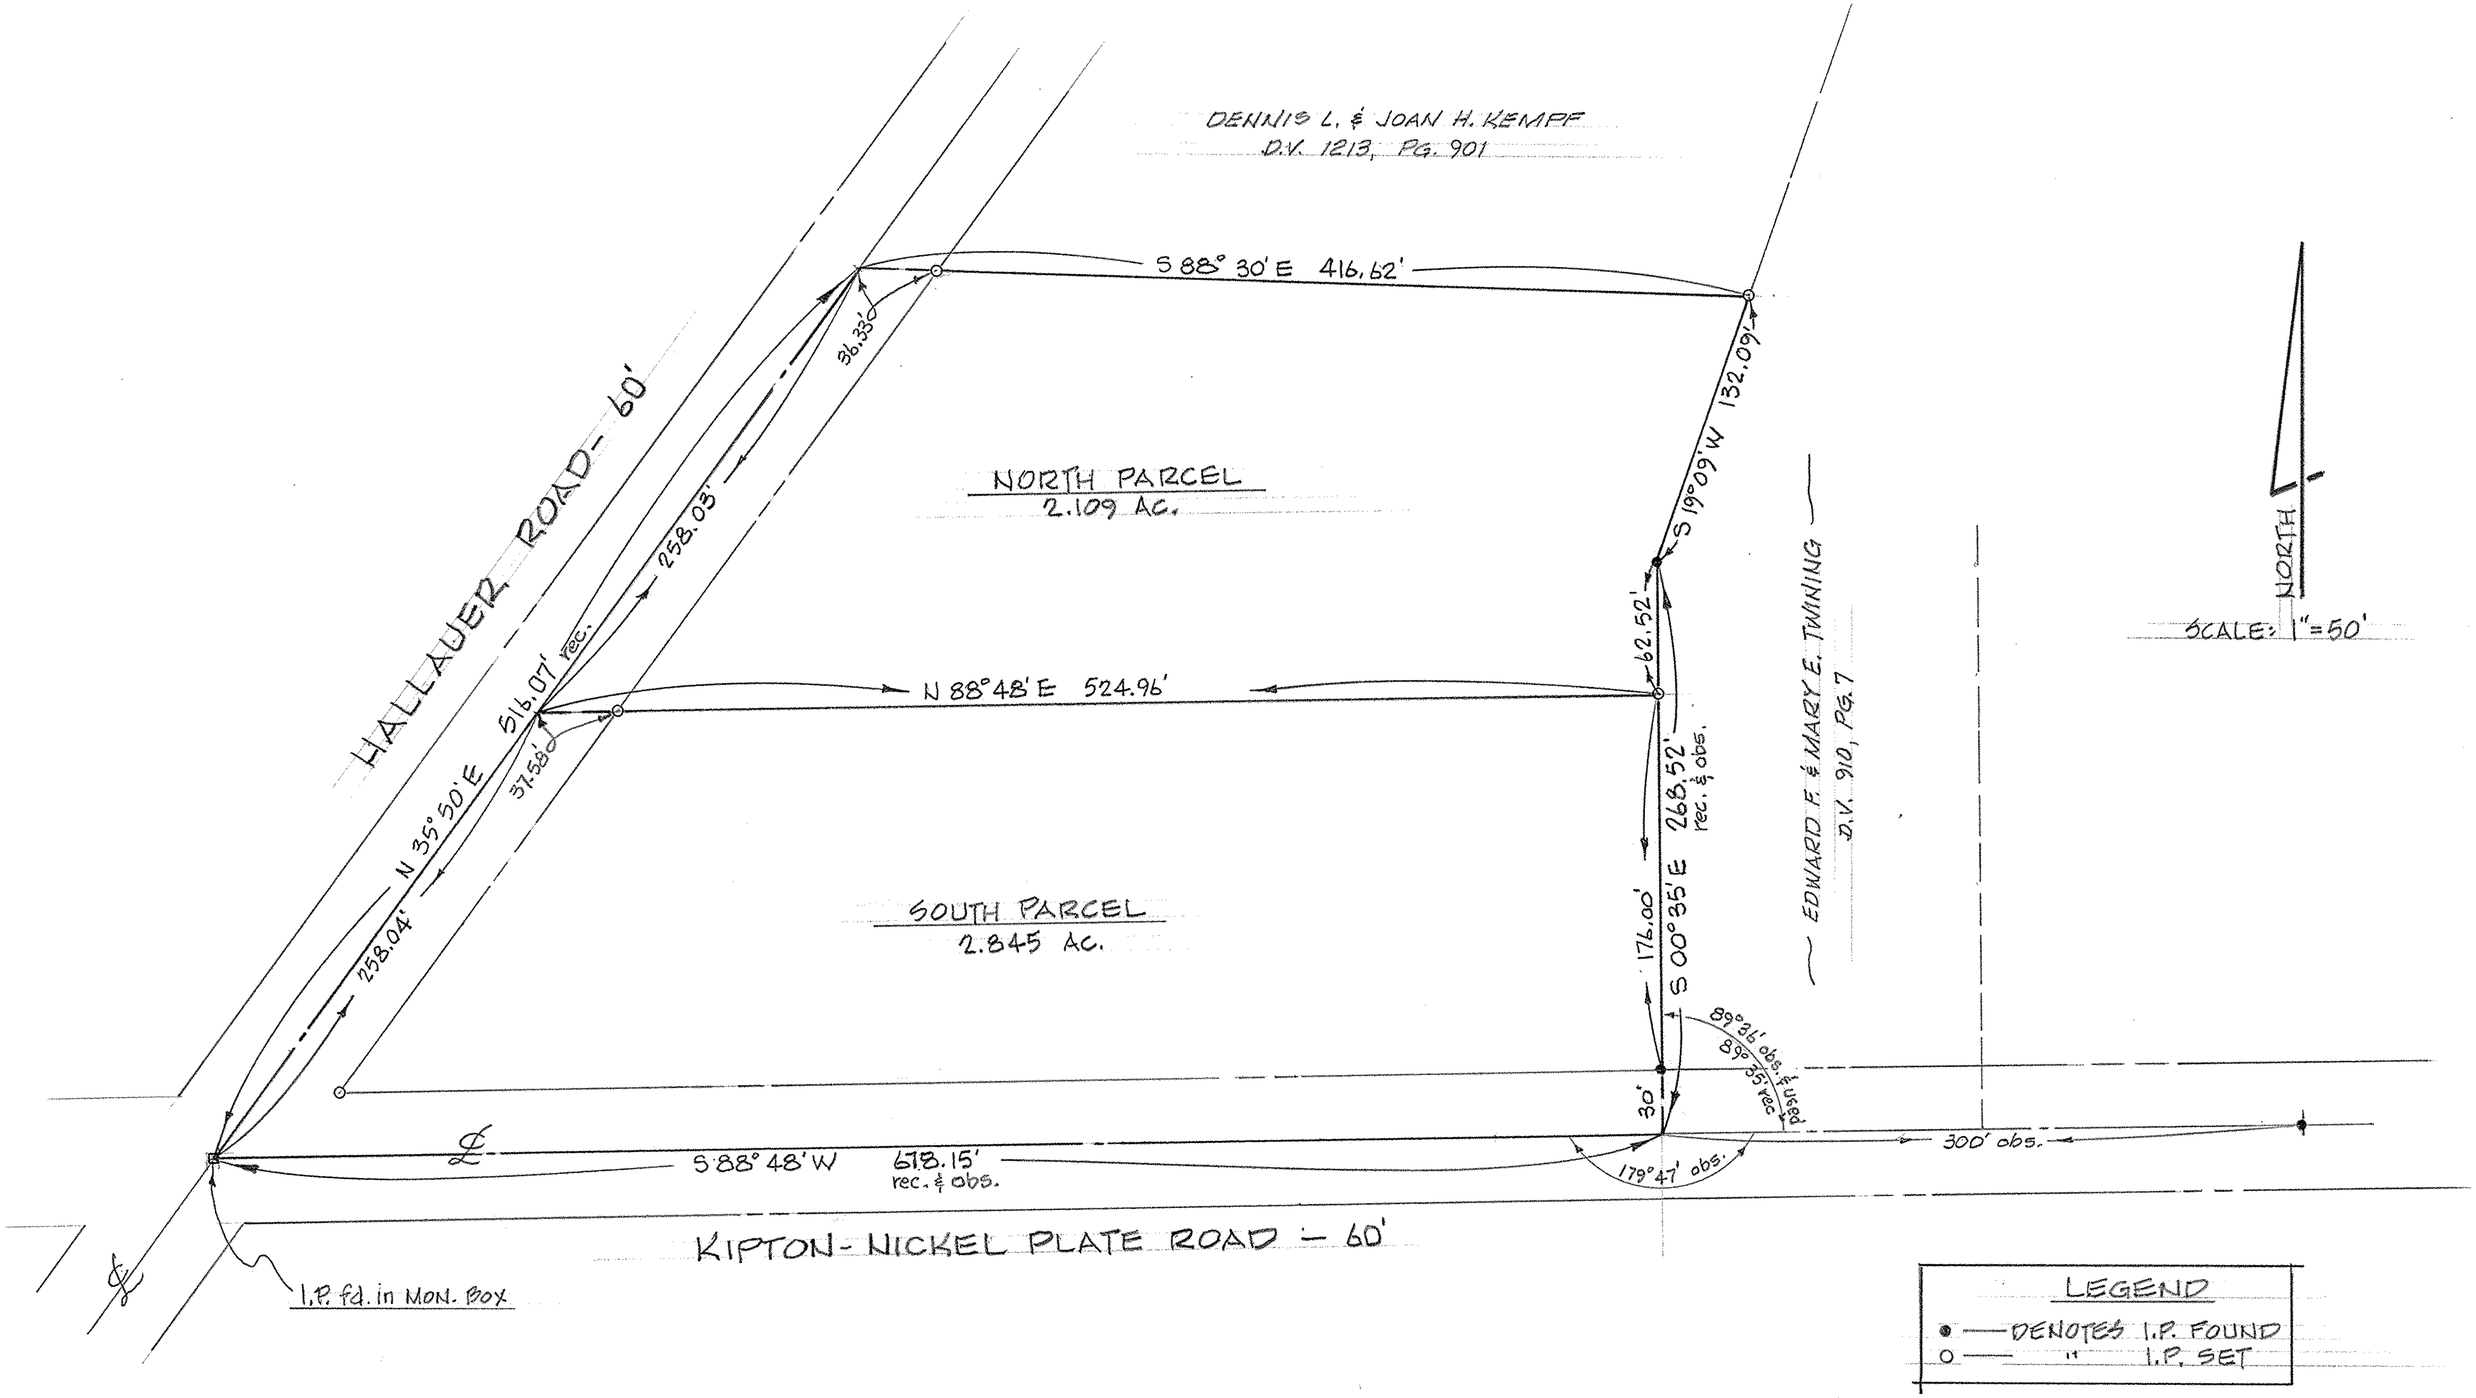

MAP of PROPOSED PARCEL SPLIT

PREPARED FOR HENRY J. FREAS

PART of ORIGINAL PITTSFIELD TOWNSHIP LOT No. 17
TOWNSHIP of PITTSFIELD, LORAIN COUNTY, OHIO

McGLINCHY & ASSOCIATES INC.
PROFESSIONAL ENGINEER & SURVEYORS
110 MIDDLE AVE. ELYRIA OHIO
JULY, 1983 #837915