


IDA N. TASSI
D.V. 1247, Pgs. 506 & 507

JEANIE M. REYNOLDS
D.V. 1114, Pg. 185

EDWIN & VIVIAN BUTLER
D.V. 1321, Pg. 756

ELYRIA TELEPHONE CO.
D.V. 920, Pg. 660

WILMER K. & JEANNE M. GREEN
D.V. 1241, Pg. 783

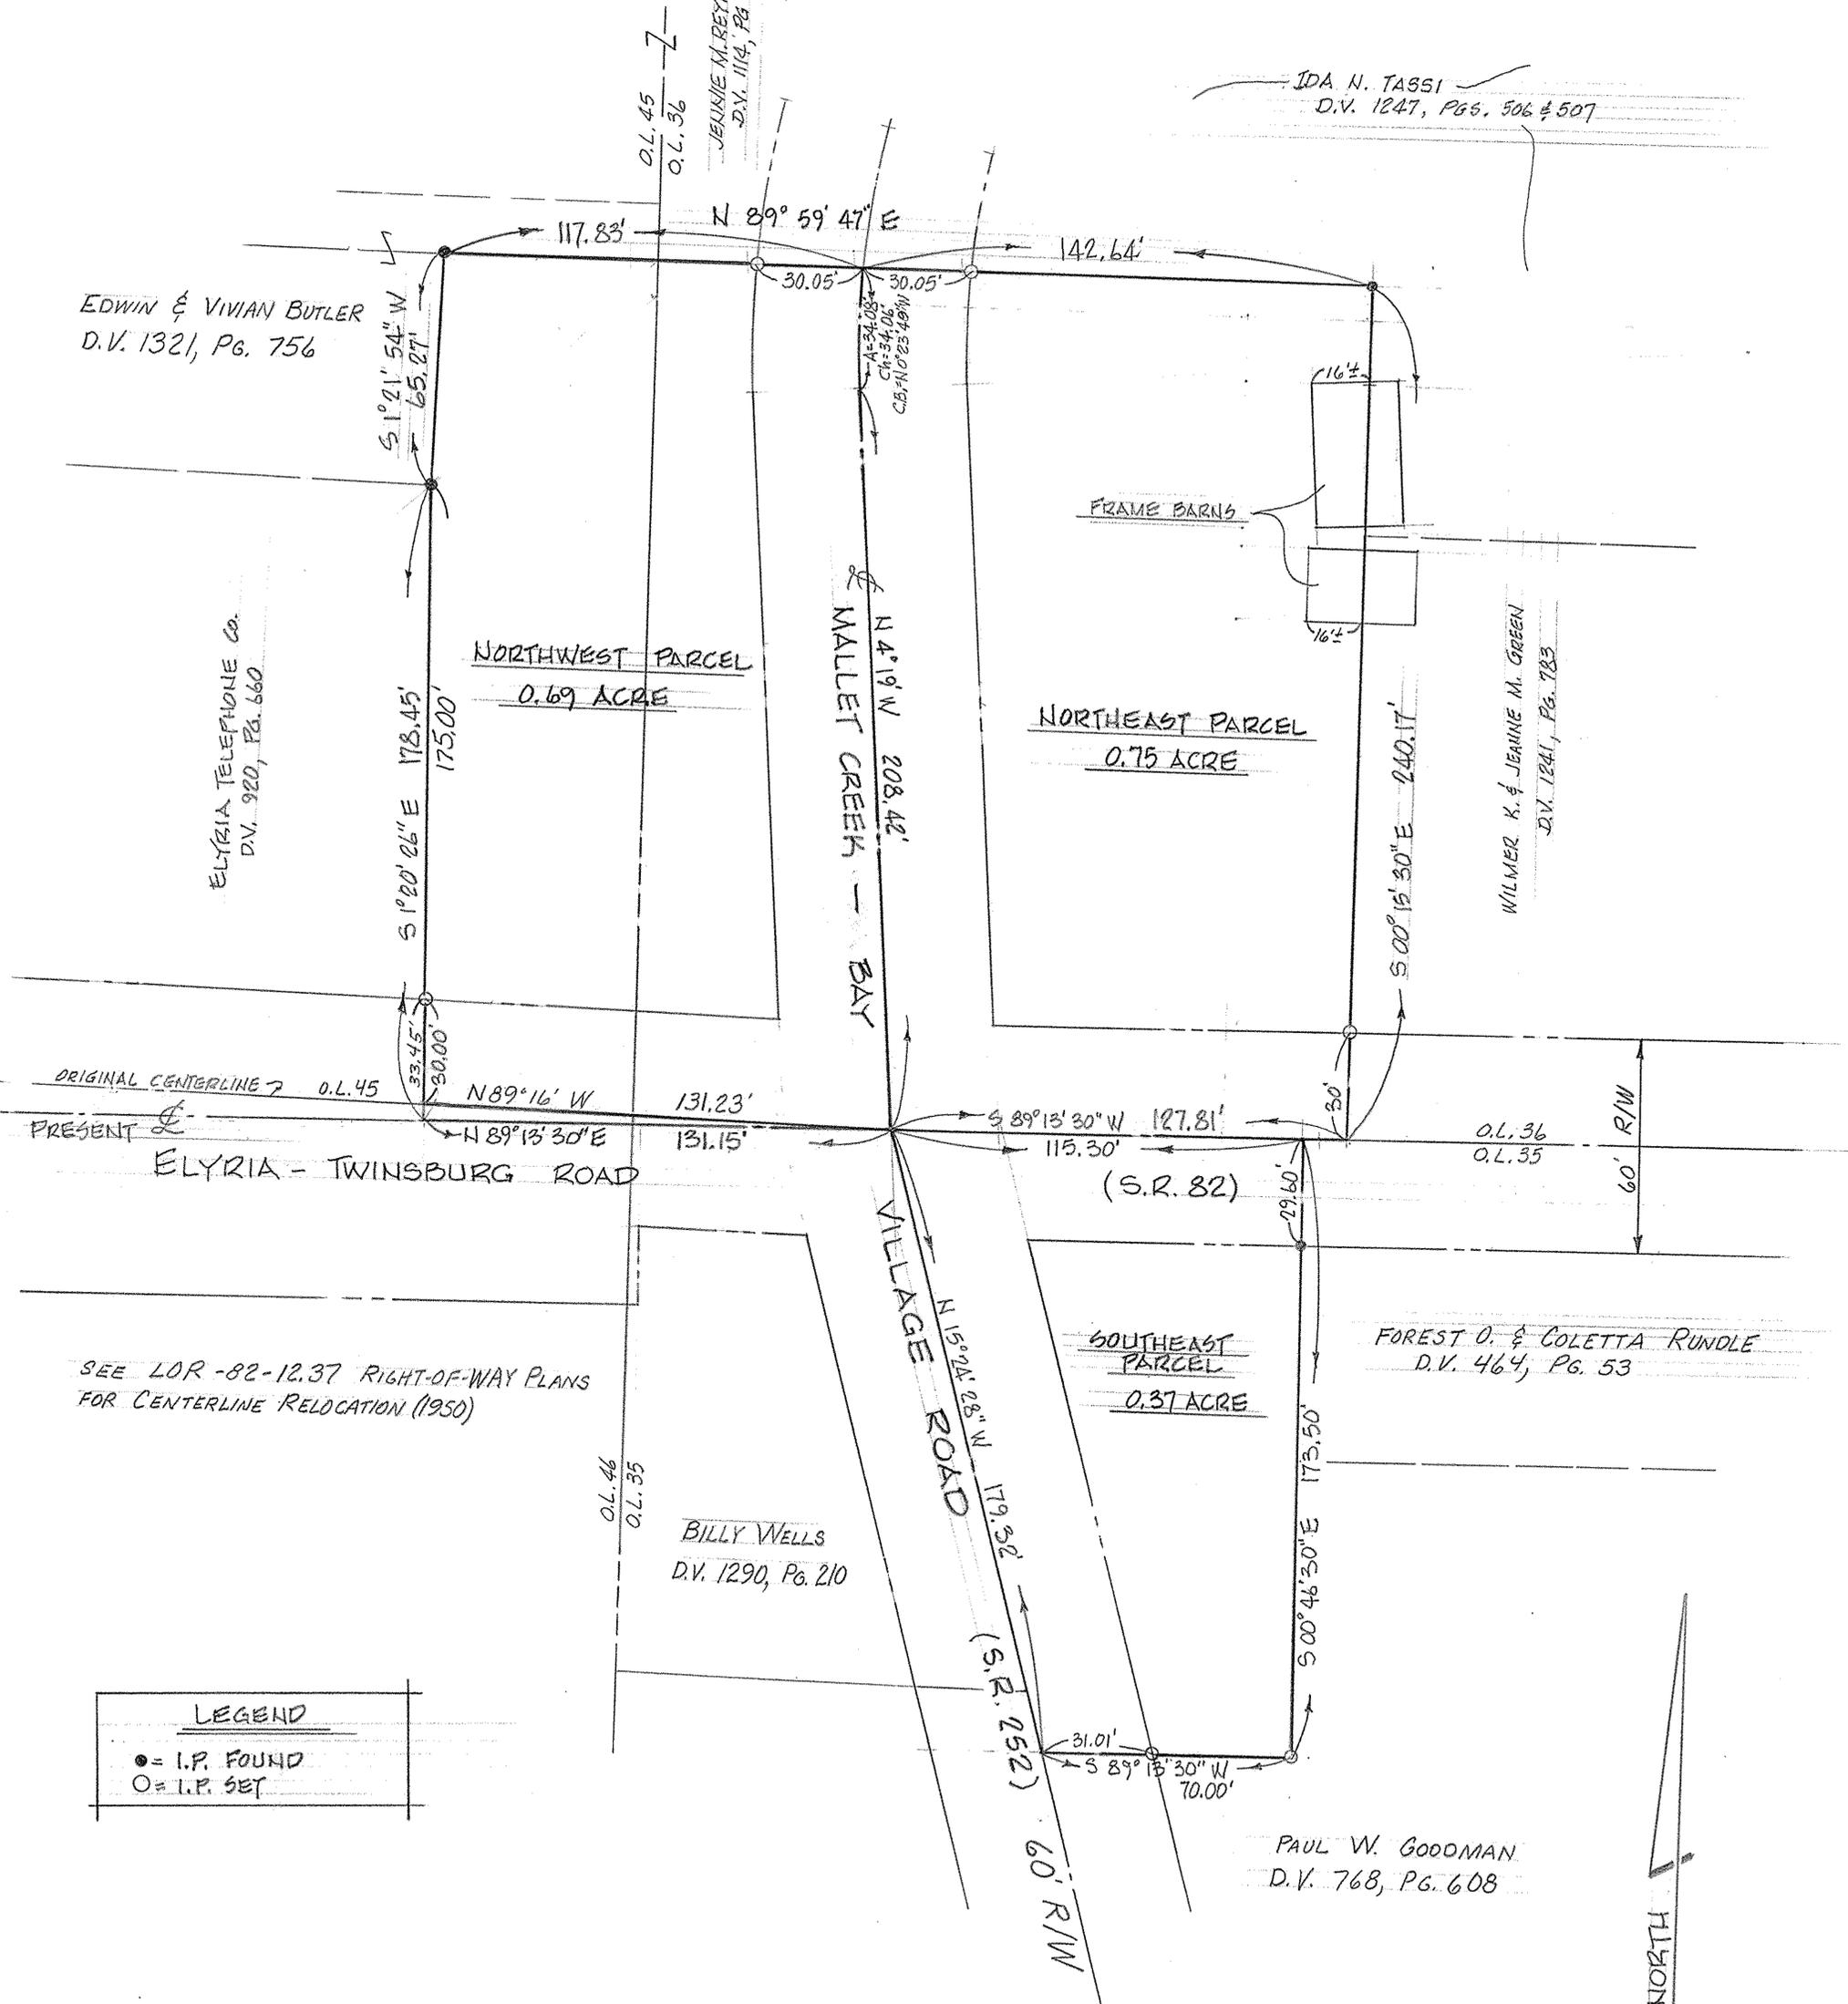

SEE LOR-82-12.37 RIGHT-OF-WAY PLANS
FOR CENTERLINE RELOCATION (1950)

FOREST O. & COLETTA RUNDLE
D.V. 464, Pg. 53

BILLY WELLS
D.V. 1290, Pg. 210

PAUL W. GOODMAN
D.V. 768, Pg. 608

MAP of BOUNDARY SURVEY

PREPARED FOR COLUMBIA TOWNSHIP TRUSTEES

PARTS of ORIGINAL COLUMBIA TWP. LOT Nos. 35, 36 & 45
TOWNSHIP of COLUMBIA, LORAIN COUNTY, OHIO

SCALE: 1" = 30'

McGLINCHY & ASSOCIATES INC.
PROFESSIONAL ENGINEER & SURVEYORS
110 1/2 MIDDLE AVE. ELYRIA, OHIO
JUNE, 1984 #848340