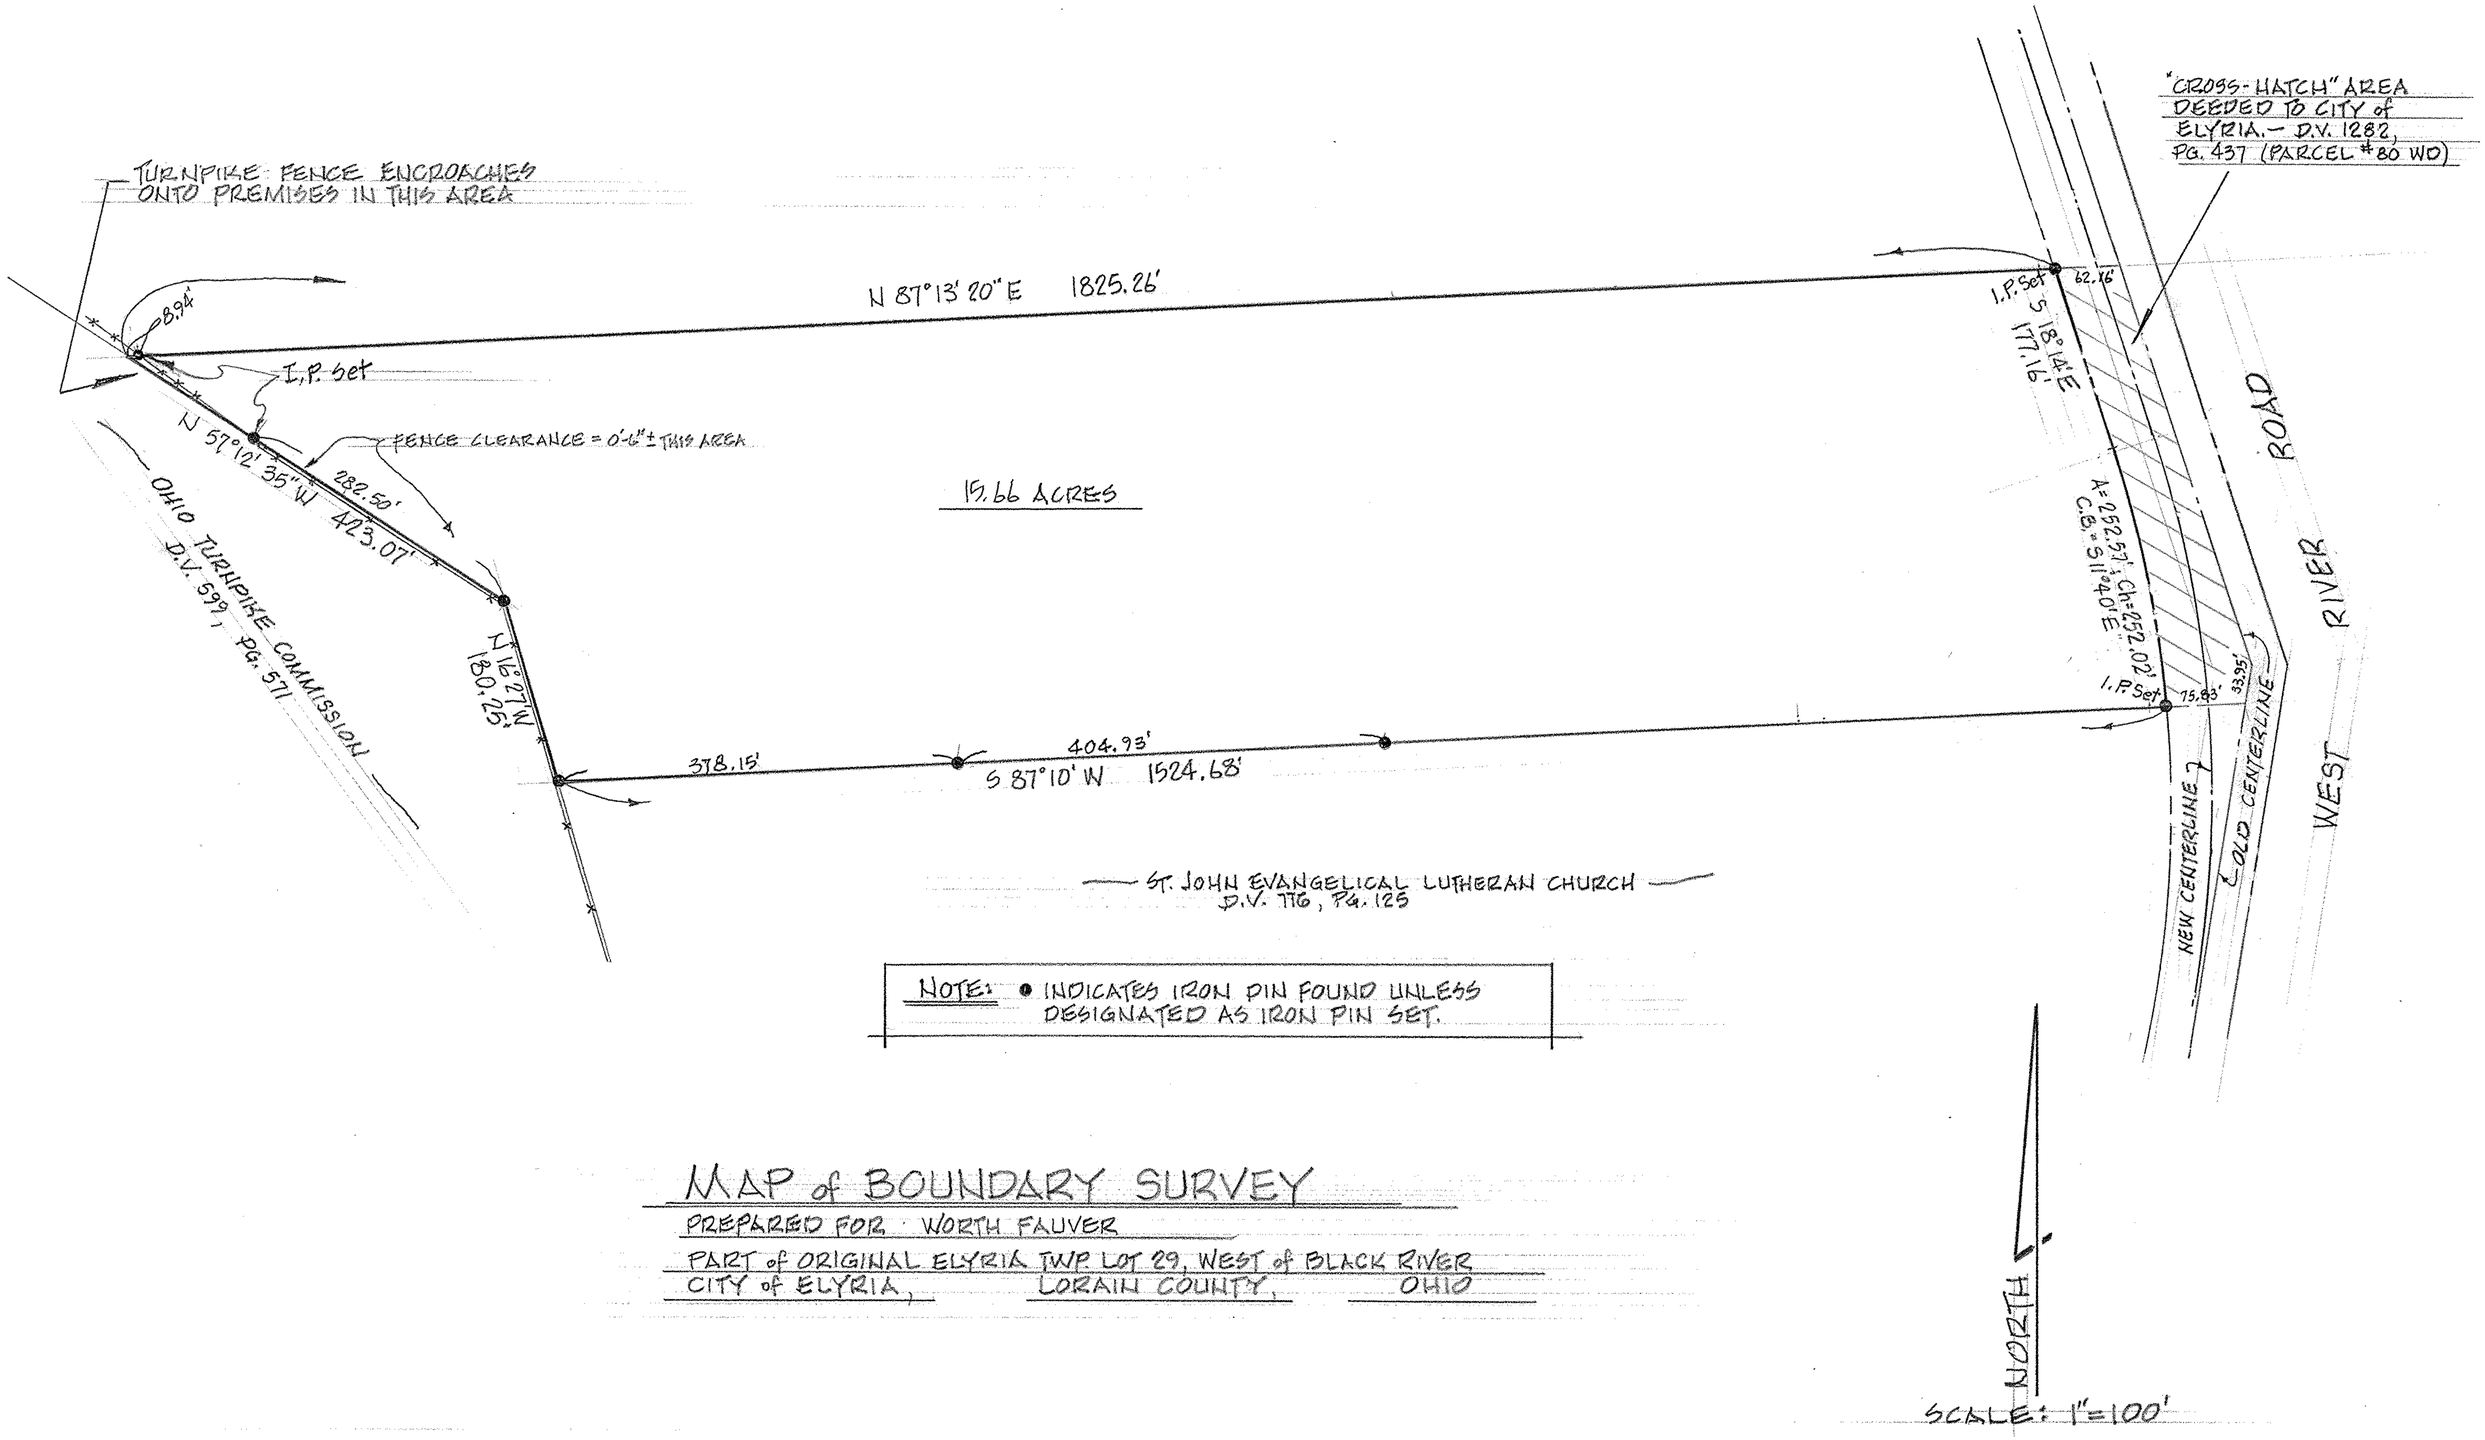

NOTE: ● INDICATES IRON PIN FOUND UNLESS DESIGNATED AS IRON PIN SET.

MAP of BOUNDARY SURVEY

PREPARED FOR WORTH FAUVER

PART of ORIGINAL ELYRIA TWP LOT 29, WEST of BLACK RIVER

CITY of ELYRIA, LORAIN COUNTY, OHIO

McGLINCHY and ASSOCIATES INC.
PROFESSIONAL ENGINEER and SURVEYORS
110½ MIDDLE AVE ELYRIA, OHIO
AUGUST, 1984 #848486