


PART OF ORIGINAL CARLISLE TWP. SECTION No. 19
TOWNSHIP of CARLISLE, LORAIN COUNTY, OHIO


MAP of SURVEY
PREPARED FOR BONNIE COX


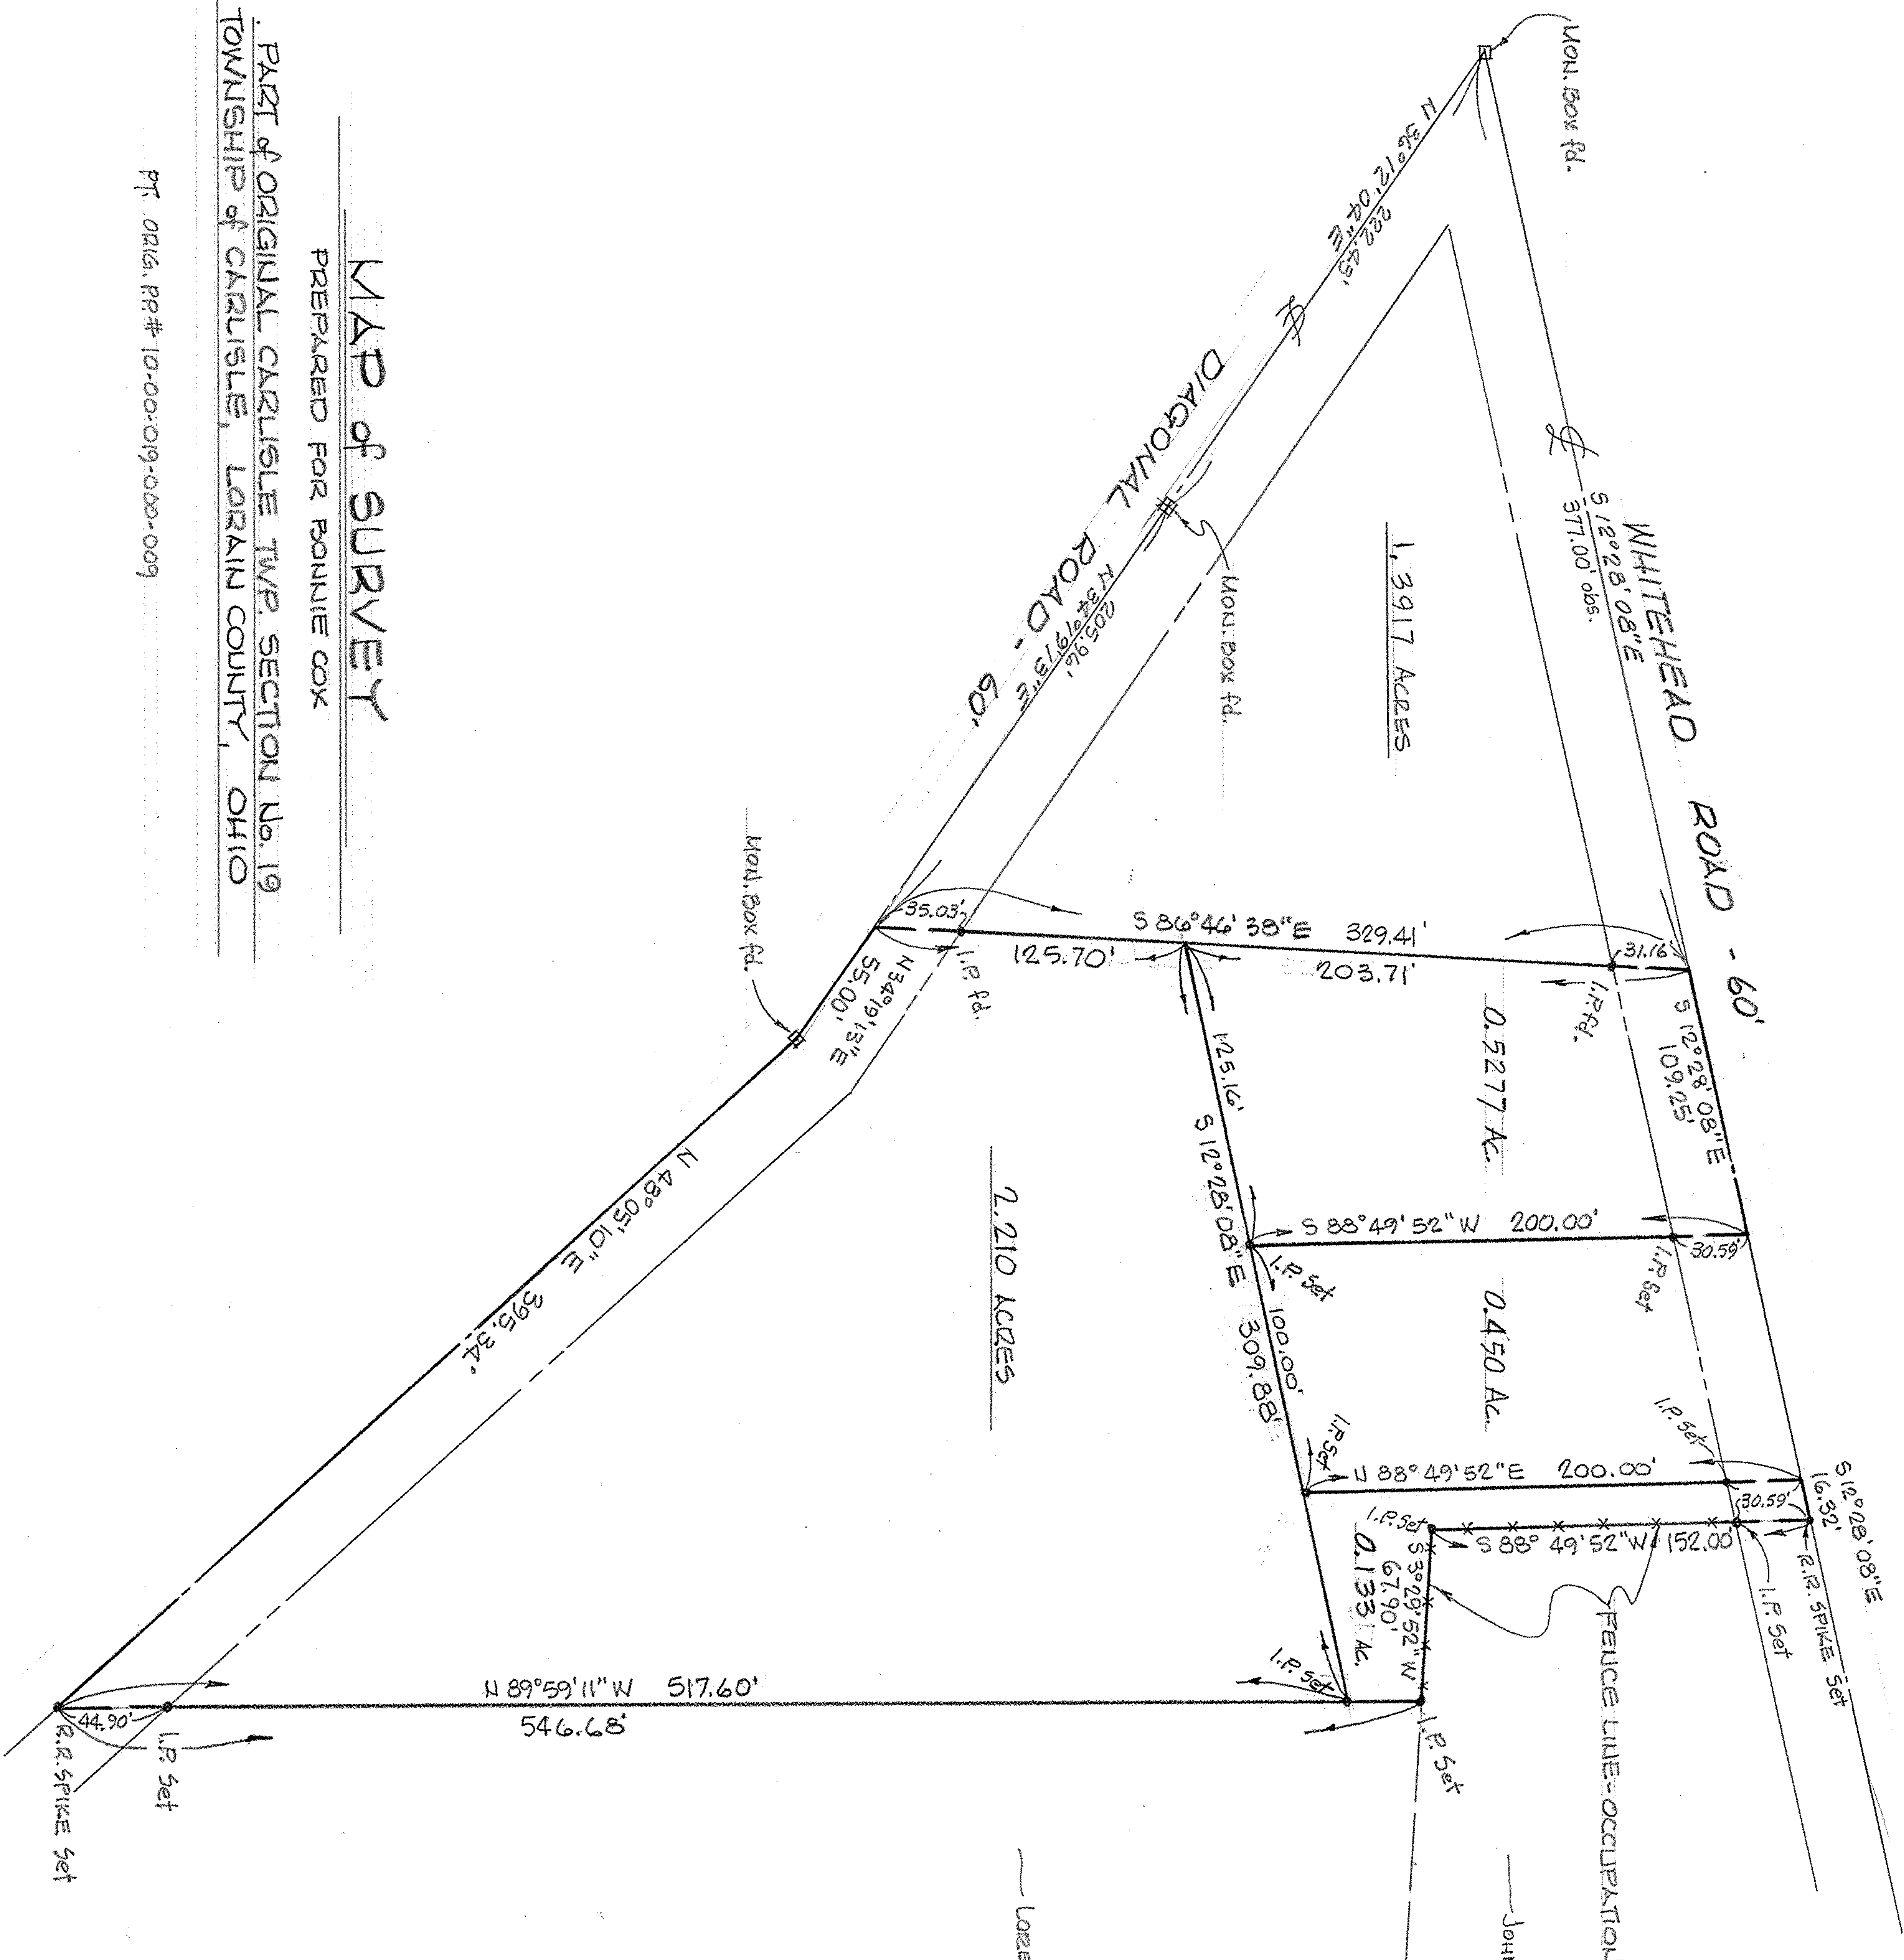

— LORETTA A. & JANE M. DART —

— JOHN & JACOB BOUSEK —

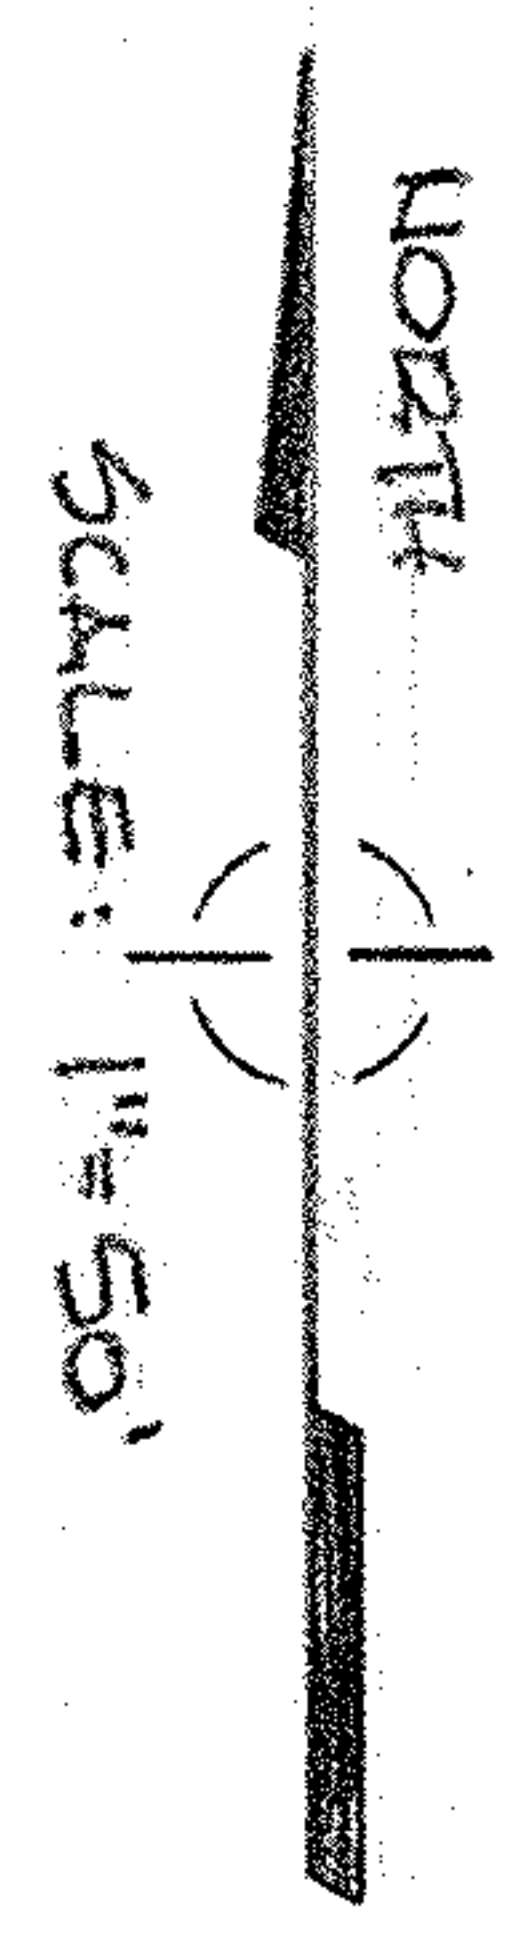

McGLINCHY and ASSOCIATES INC.
PROFESSIONAL ENGINEER and SURVEYORS
110 1/2 MIDDLE AVE. ELYRIA OHIO
DECEMBER, 1980 # 782905-A
REV. 10-29-80
REV. 12-30-80 AC