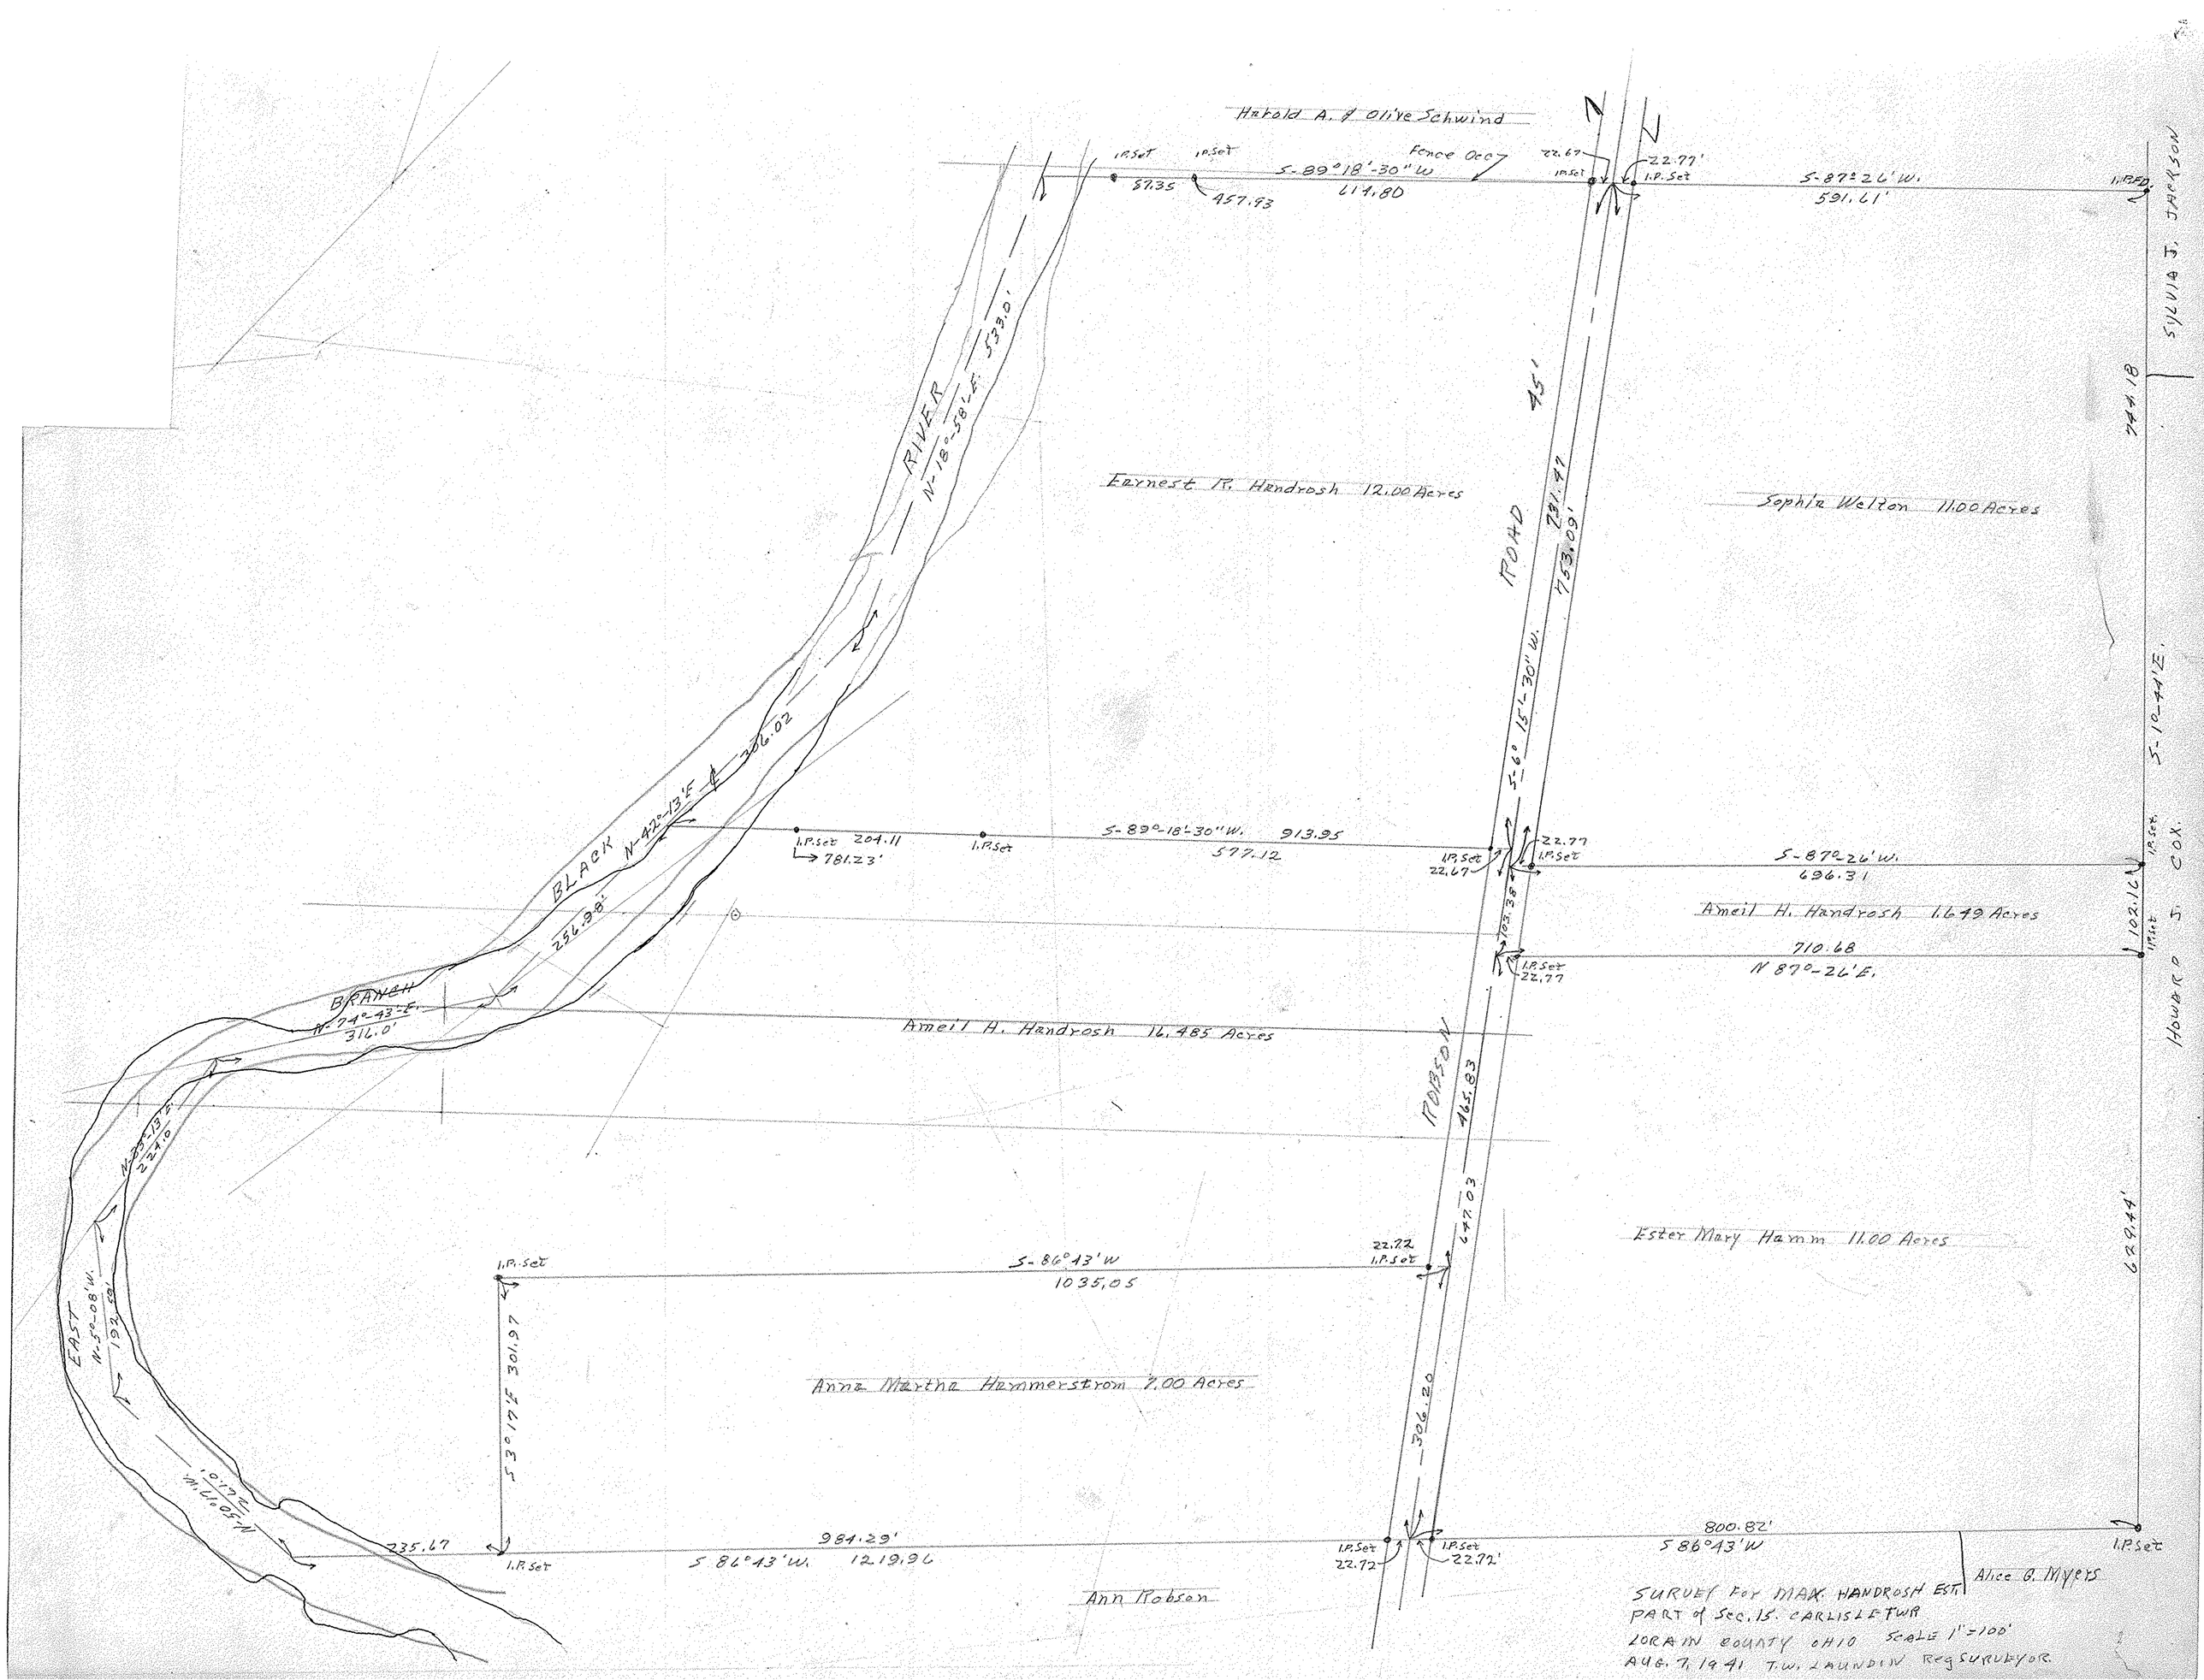
Harold A. & Olive Schwind
I.P. Set
I.P. Set
Fence Occ
S-89°18'-30" W
87.35
457.93
114.80
22.67
22.77'
I.P. Set
I.P. Set
S-87°26' W.
591.61'
I.P. Set
744.18
RIVER
N-18°-58' E. 533.01'
Earnest R. Hendrosh 12.00 Acres
ROAD
45'
Sophie Welton 11.00 Acres
S-6° 15'-30" W.
781.41
453.09'
BLACK
N-42°-13' E
326.02
I.P. Set
204.11
781.23'
I.P. Set
S-89°-18'-30" W.
913.95
577.12
I.P. Set
22.67
I.P. Set
22.77
S-87°26' W.
696.31
Ameil H. Hendrosh 1.649 Acres
103.38
710.68
N 87°-26' E.
I.P. Set
22.77
I.P. Set
102.16
I.P. Set
S. 10-44' E.
HOWARD COX
BRANCH
N-74°-43' E.
316.0'
Ameil H. Hendrosh 16.485 Acres
TOBSON
465.83
N-39°-13' E
224.0
EAST
N-50°-08' W.
192.60'
I.P. Set
S-86°13' W
1035.05
22.22
I.P. Set
647.03
Ester Mary Hamm 11.00 Acres
629.44'
S 30°17'-E 301.97
Anna Martha Hammerstrom 7.00 Acres
306.20
10.17
N-50°17' W.
N-40°05' W
235.67
I.P. Set
984.29'
S 86°43' W.
1219.96
I.P. Set
22.72
I.P. Set
22.72'
800.82'
S 86°43' W
I.P. Set
Alice G. Myers
Ann Robson
SURVEY For MAX HANDROSH EST
PART of SEC. 15. CARLISLE TWP
LORAIN COUNTY OHIO SCALE 1" = 100'
AUG. 7, 1941 T.W. LAUNDIN Reg SURVEYOR