


John B. Wensink  
D. Vol. 116 Pg. 390 April 30-1910



Christina Ingram  
Vol. 560 Pg 562 Dec. 30-1952

James Ingram  
7.6389 Ac

Meadow View A114.  
Vol. 12 Pg. 7 Plat Record

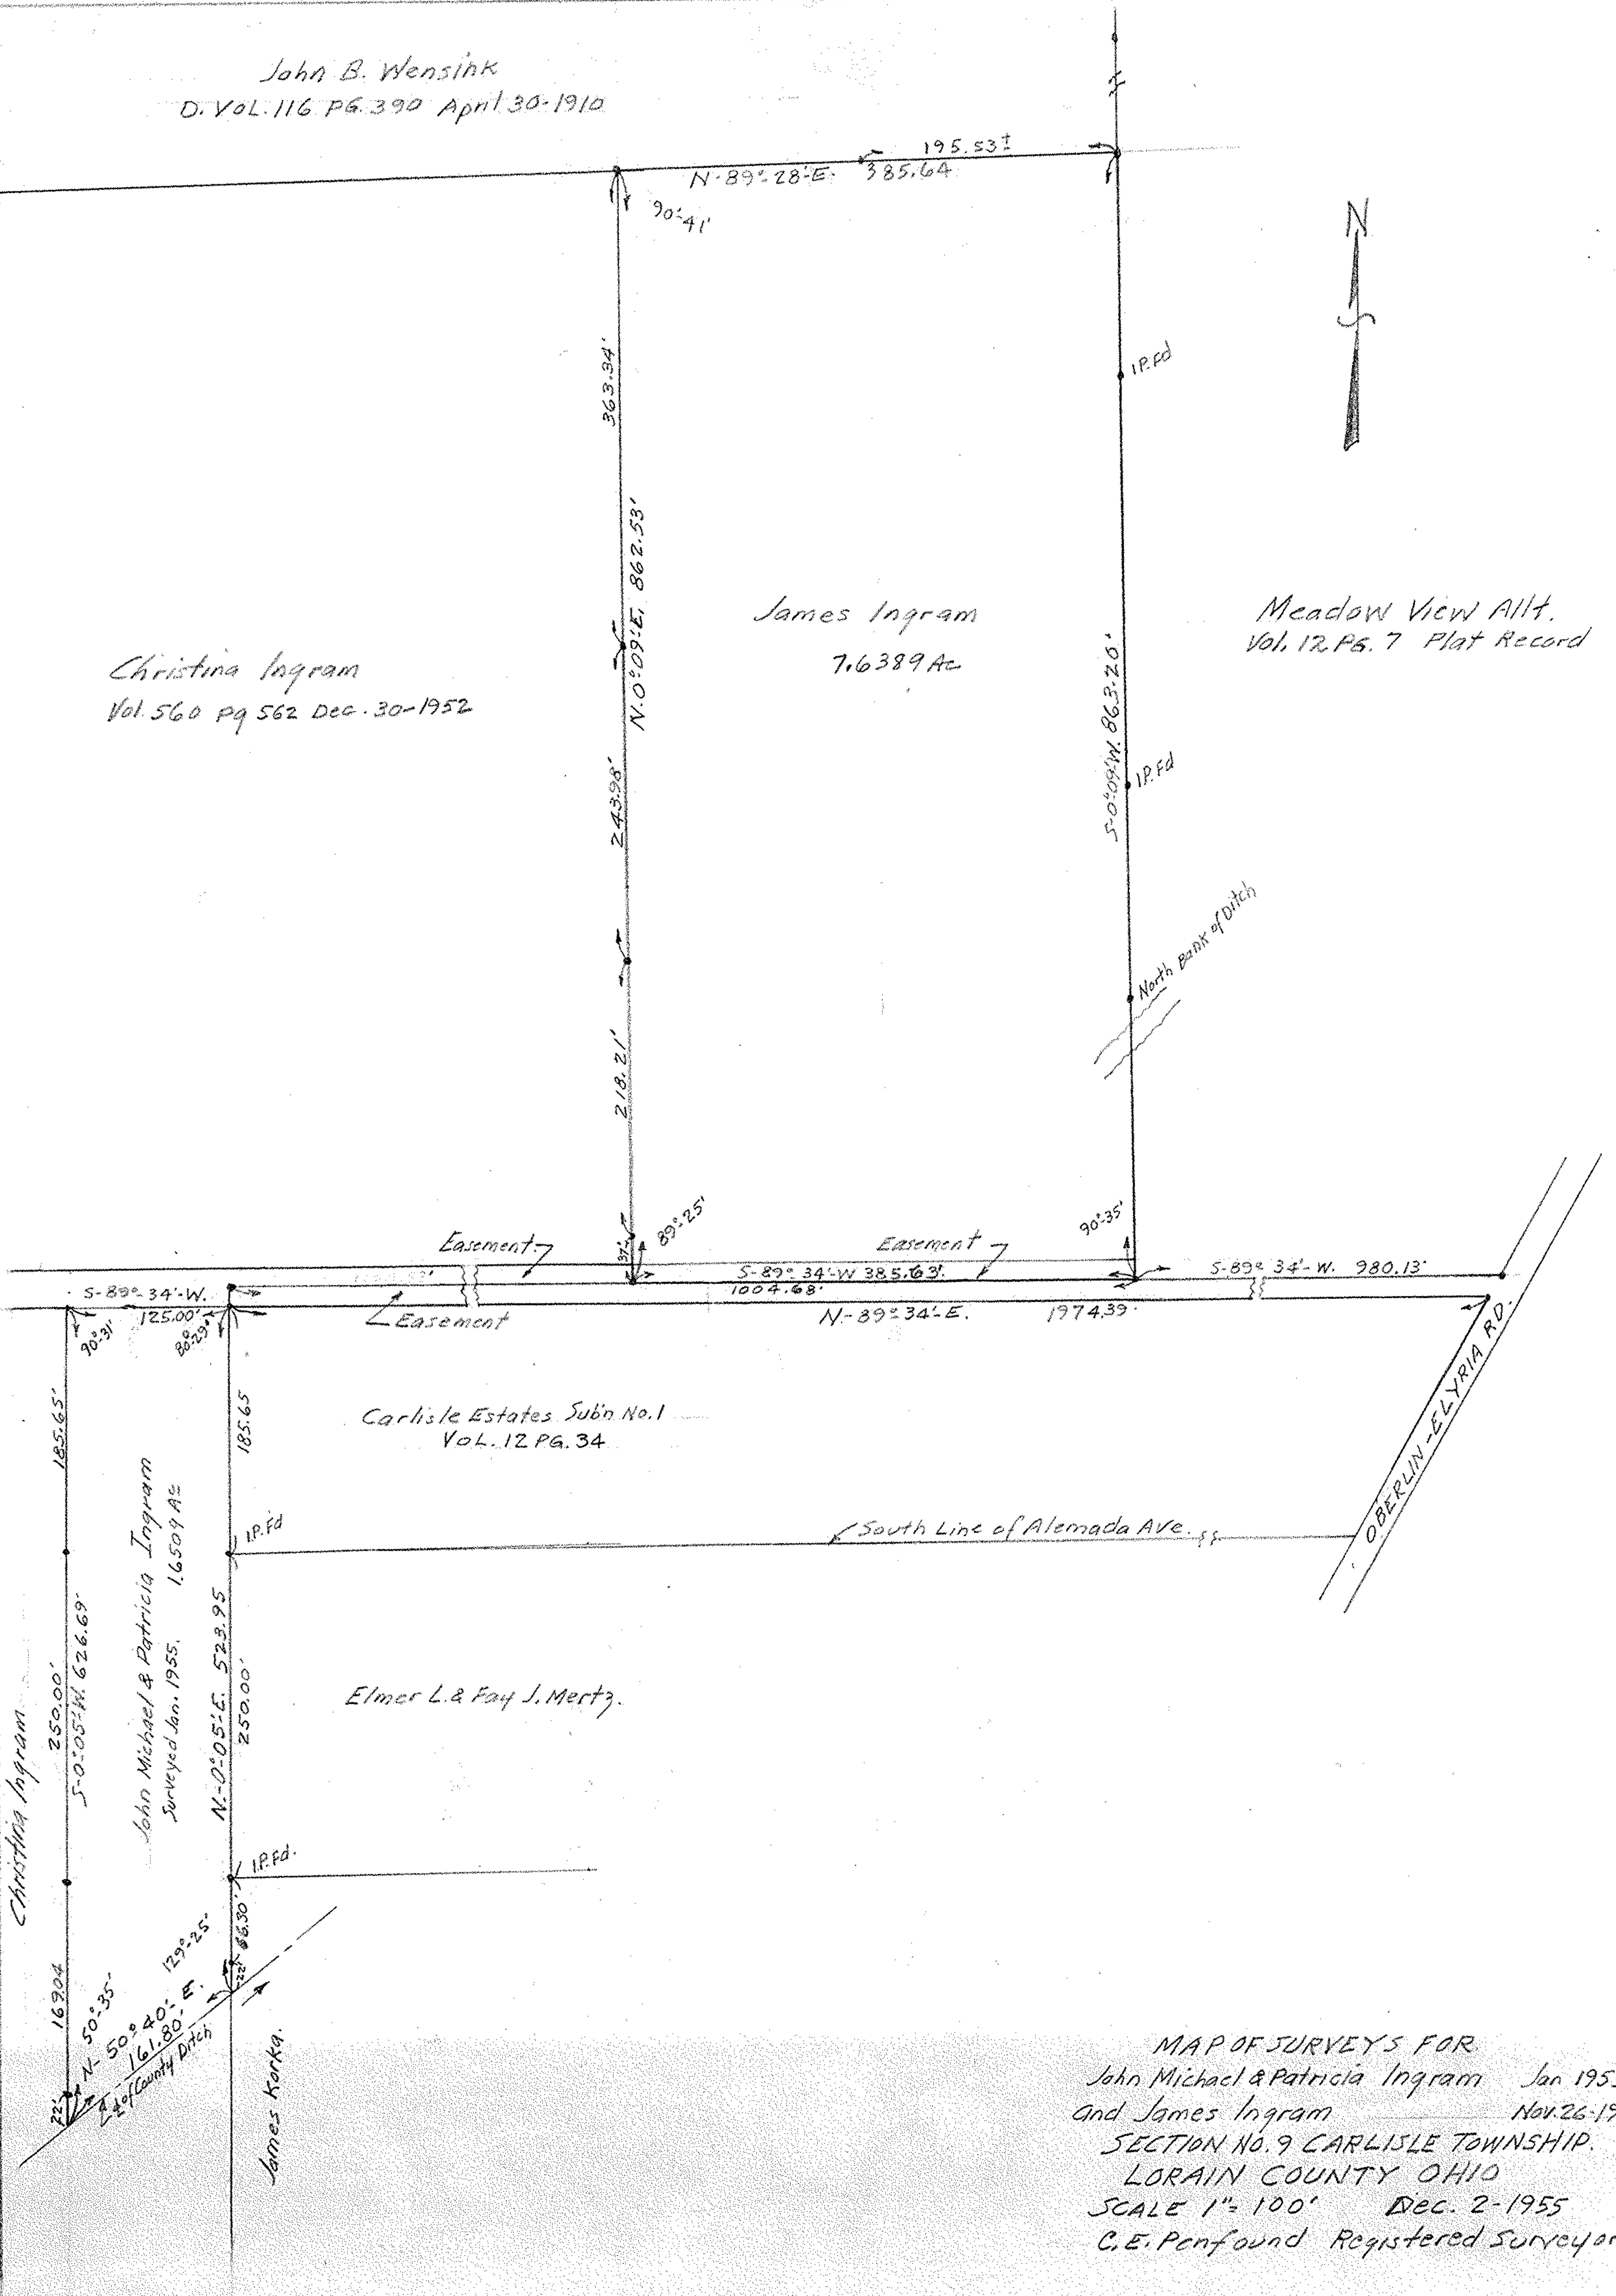

Carlisle Estates Subn No. 1  
Vol. 12 Pg. 34

Elmer L. & Fay J. Mertz

Christina Ingram

John Michael & Patricia Ingram  
Surveyed Jan. 1955. 1.6509 Ac

James Korka

MAP OF SURVEYS FOR  
John Michael & Patricia Ingram Jan 1955  
and James Ingram Nov. 26-1955  
SECTION NO. 9 CARLISLE TOWNSHIP.  
LORAIN COUNTY OHIO  
SCALE 1" = 100' Dec. 2-1955  
C.E. Penfound Registered Surveyor