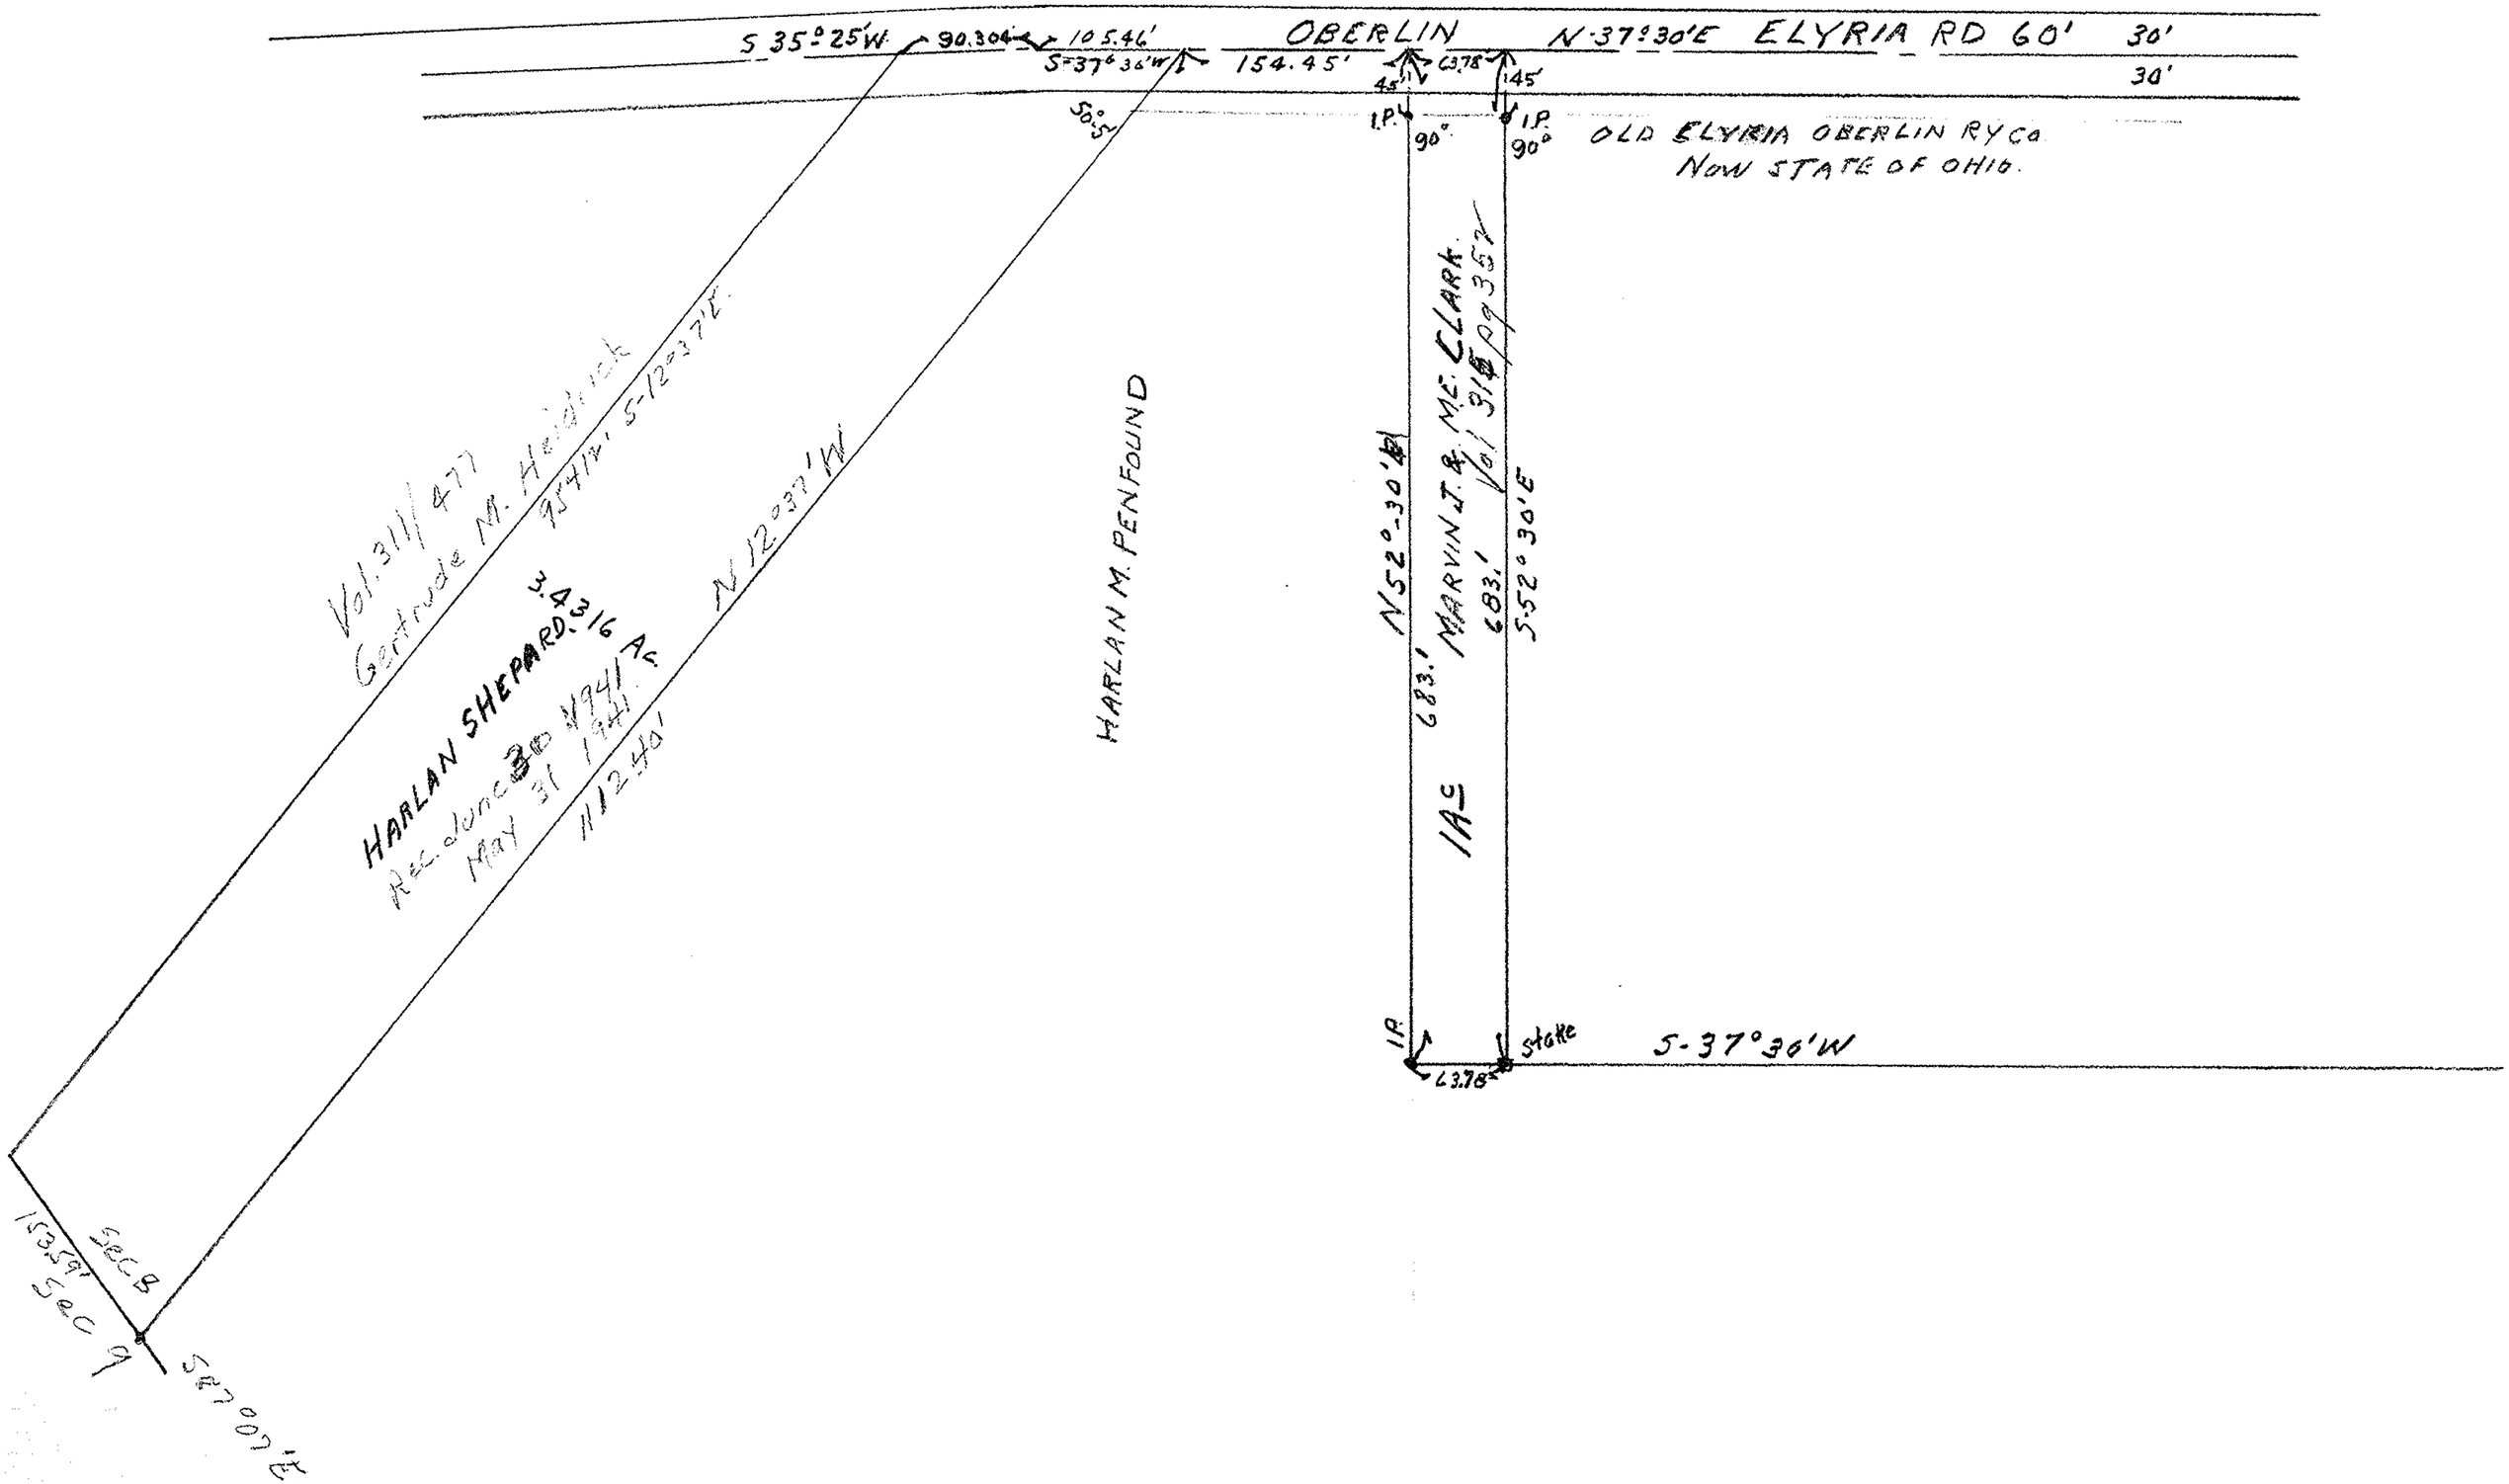

S 35°25'W
90.304
105.46'
S-37°36'W
OBERLIN
154.45'
N-37°30'E
ELYRIA RD 60'
30'
30'
45'
63.78
45'
I.P.
90°
I.P.
90°
OLD ELYRIA OBERLIN RY Co
NOW STATE OF OHIO.
50°5'
Vol. 311/477
Gertrude M. Heidrick
9541'
S-12°37'E.
HARLAN SHEPARD
3.4316 Ac.
Rec. June 30 1941
May 31 1941
N 12°37'W
N 12°40'
HARLAN M. PENFOUND
N 52°-30'W
683.'
MARVIN J. & M.E. CLARK
Vol 315 pg 352
683.'
S-52°30'E
1Ac
I.P.
63.78
stake
S-37°36'W
153.59'
Sec B
Sec 9
S87°00'E.

10-00-008