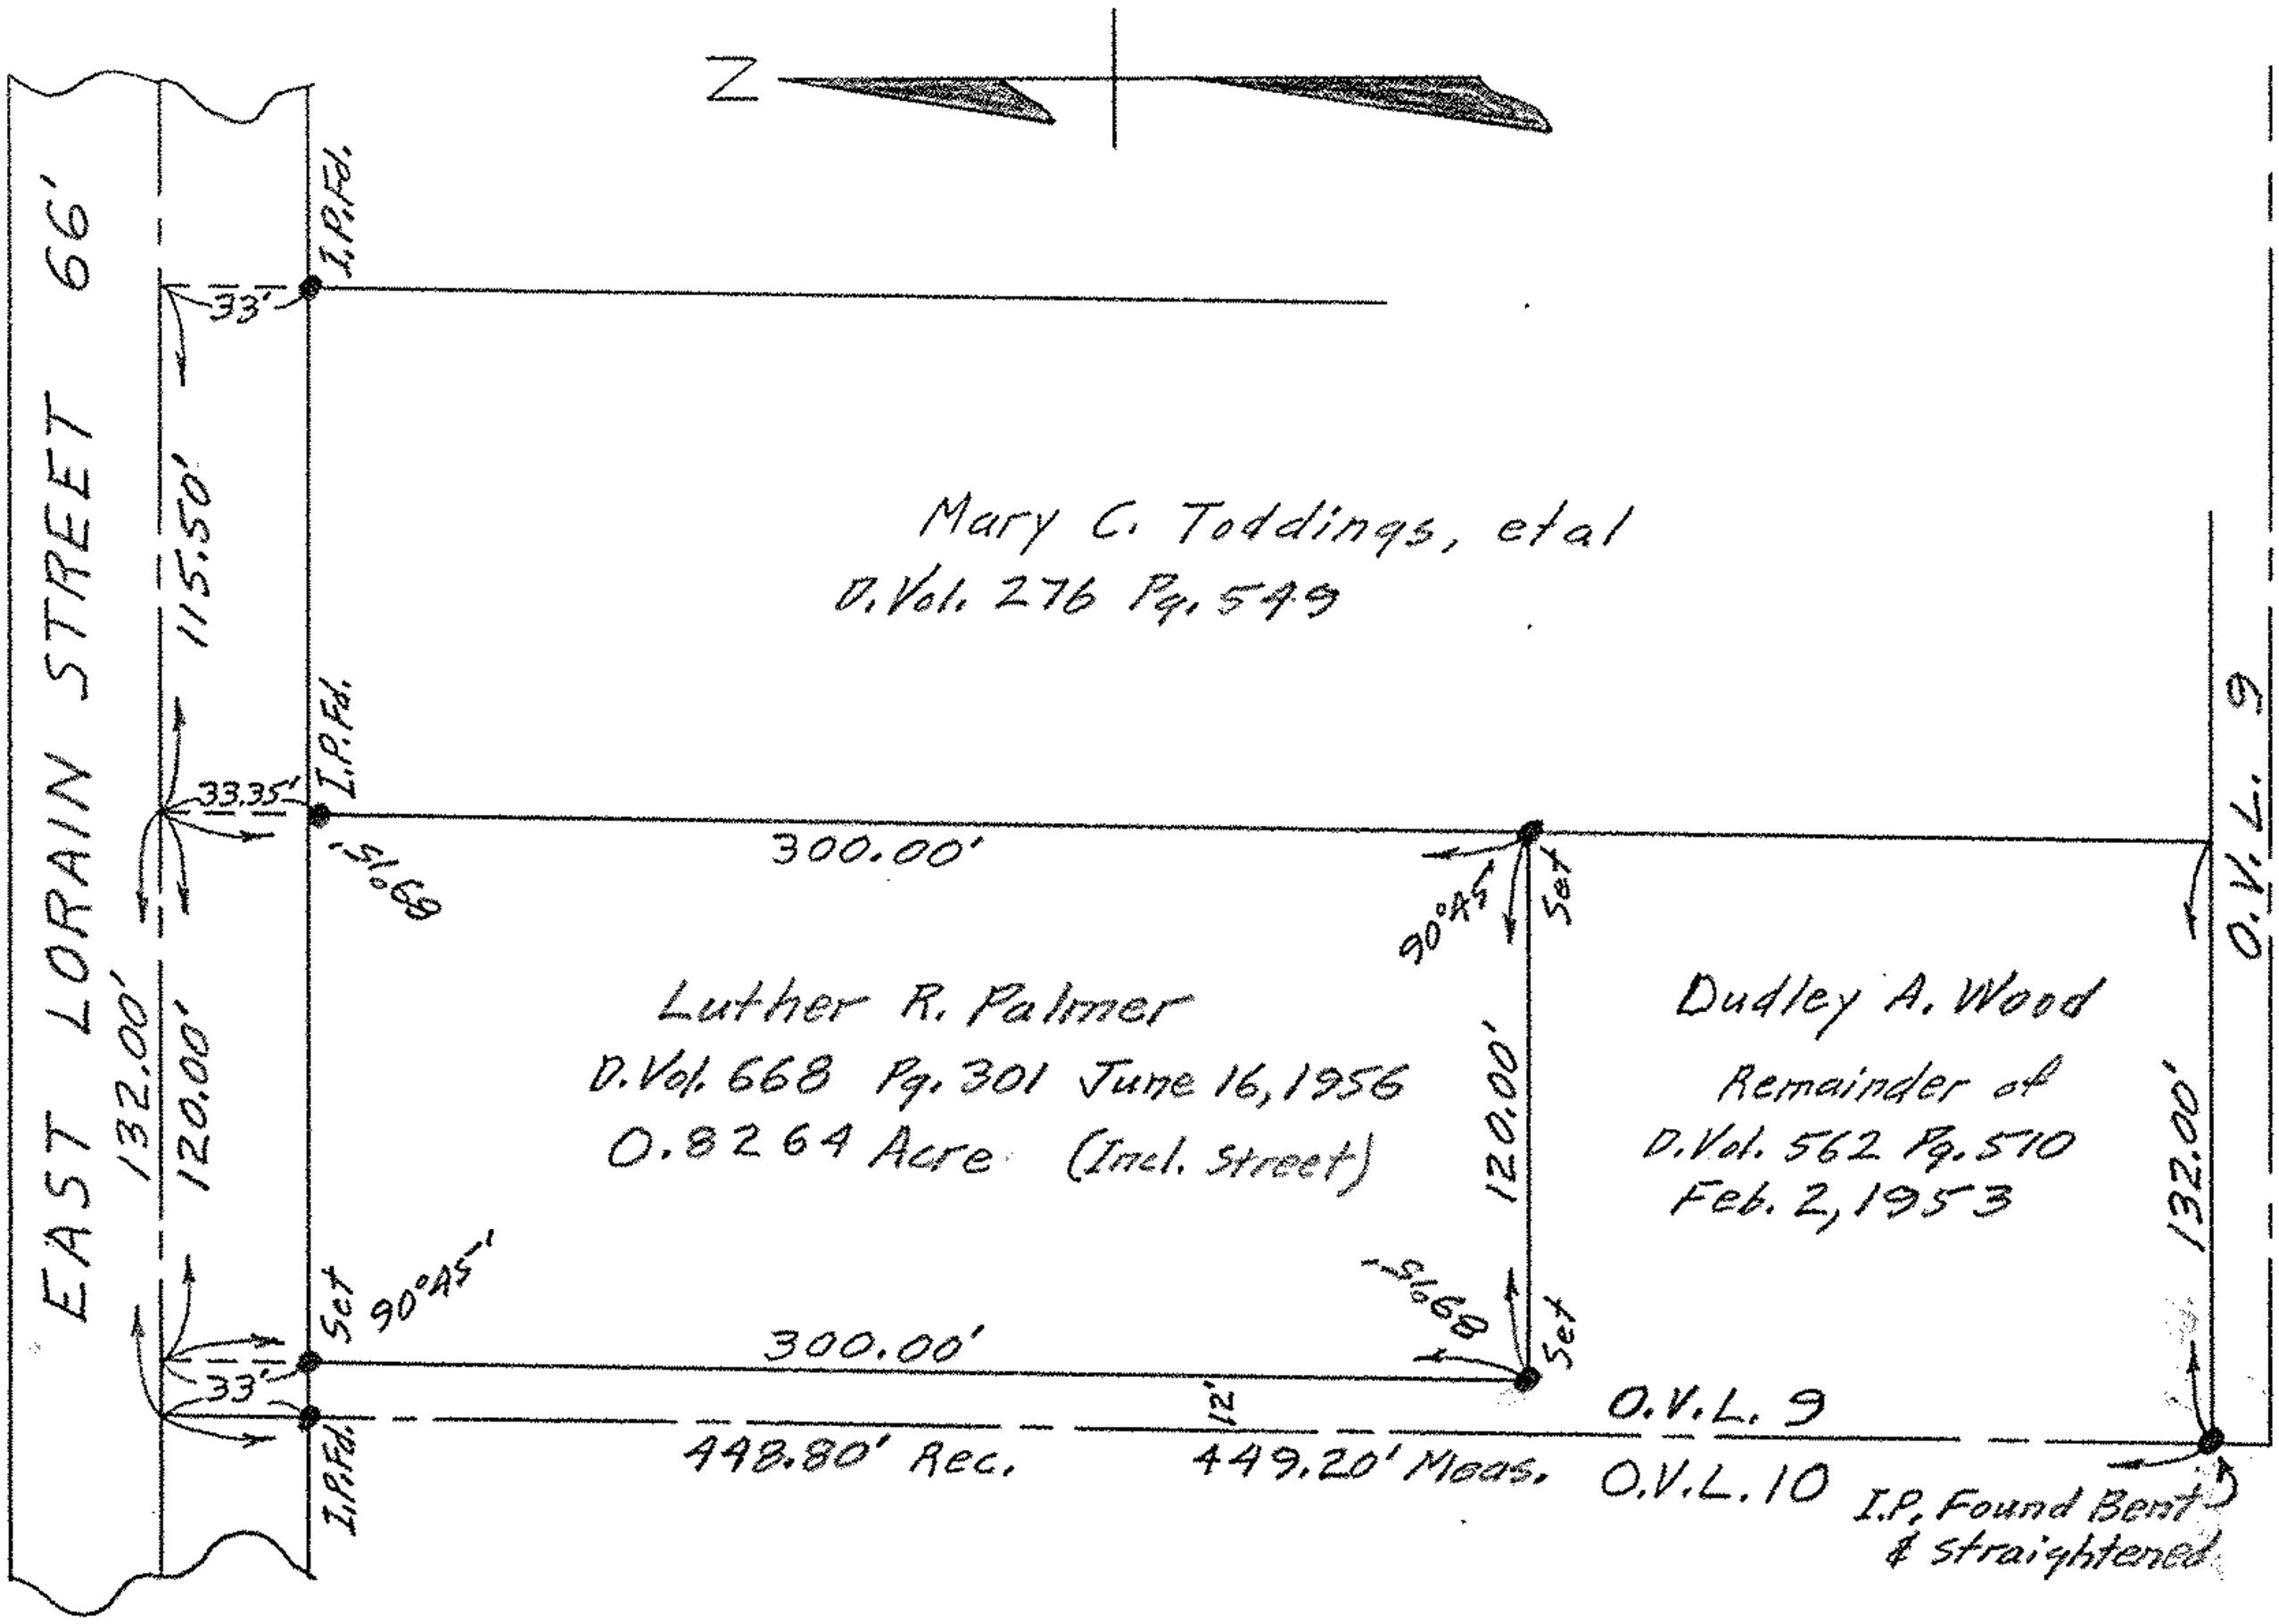

PLAT OF SURVEY FOR LUTHER R. PALMER
ORIGINAL VILLAGE LOT No. 9 - OBERLIN CITY
ORIGINAL LOT No. 86 - RUSSIA TOWNSHIP
LORAIN COUNTY - OHIO
SCALE: 1" = 60' MAY 3, 1957
C.E. Penfound Registered Surveyor
NOTE: Iron pins found or set shown thus: ●