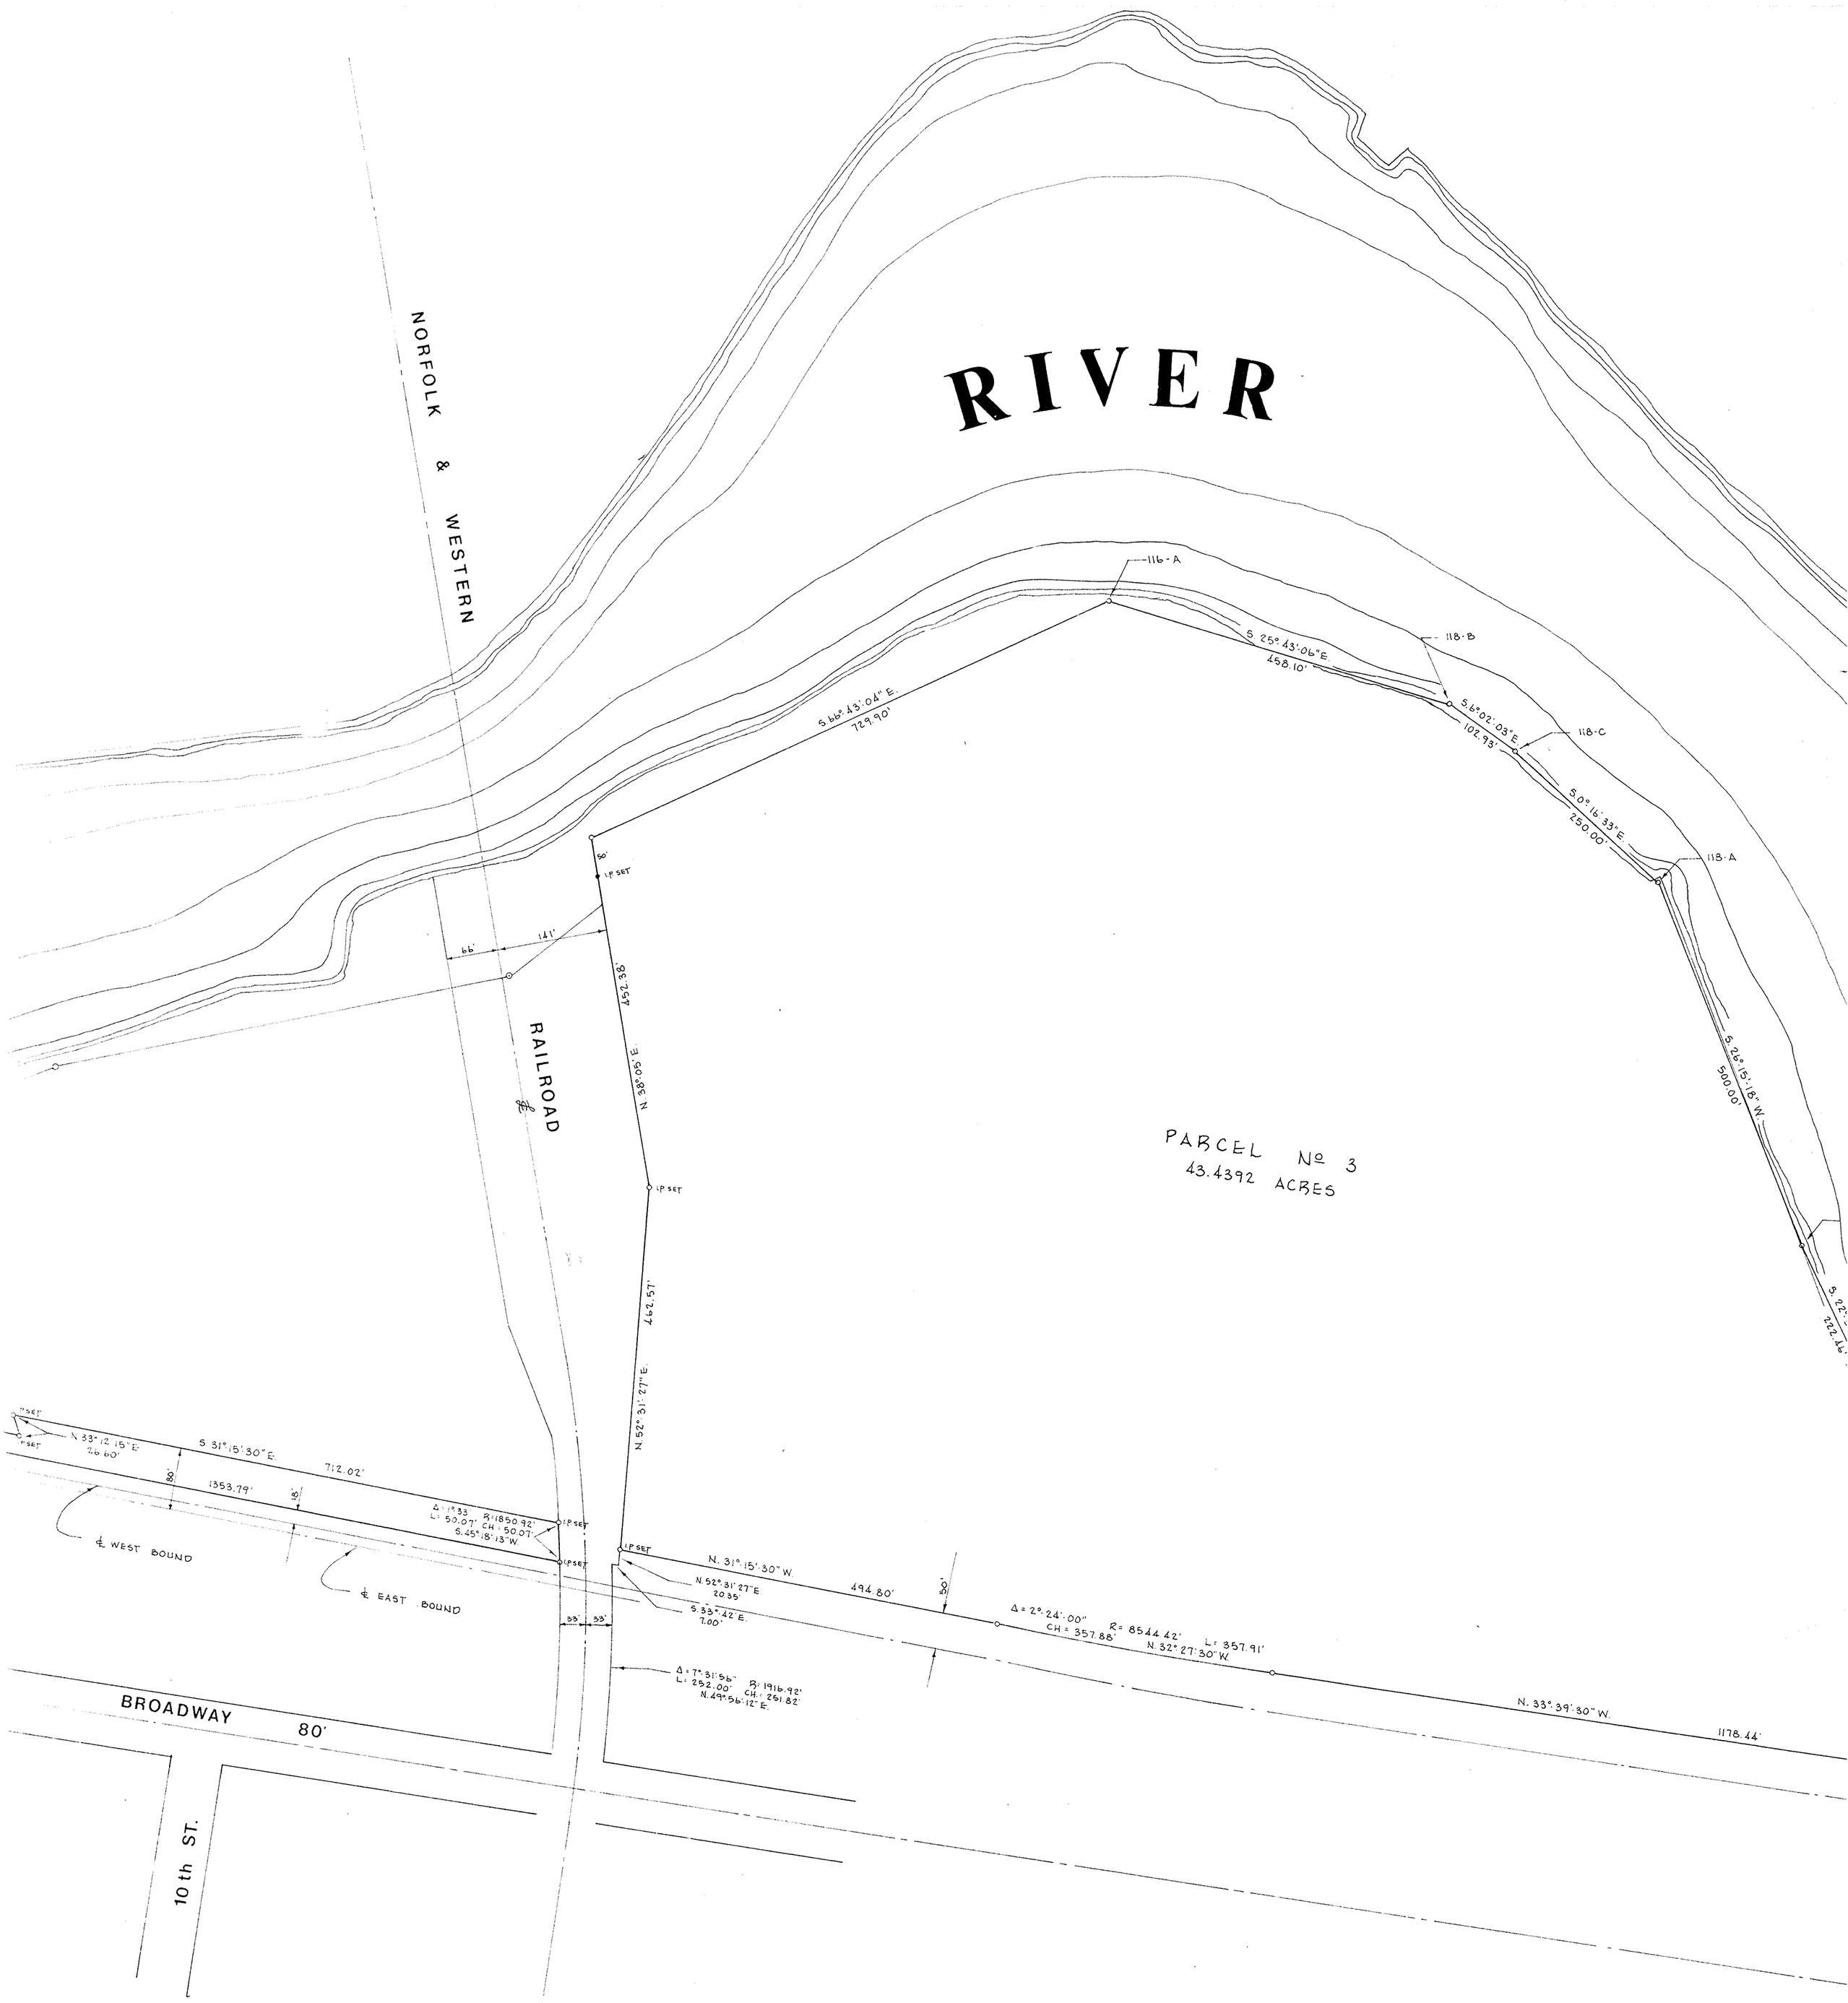

WE DO HEREBY CERTIFY THAT WE HAVE SURVEYED THE PREMISES AND PREPARED THE ATTACHED PLAT AND THAT SAID PLAT IS CORRECT.

BY:

RODGER G. SIMON
REGISTERED SURVEYOR NO. 5101
LAUNDON · SIMON · CAHL & ASSOC.

REVISED AUG 19 '80
REVISED 3-24-80