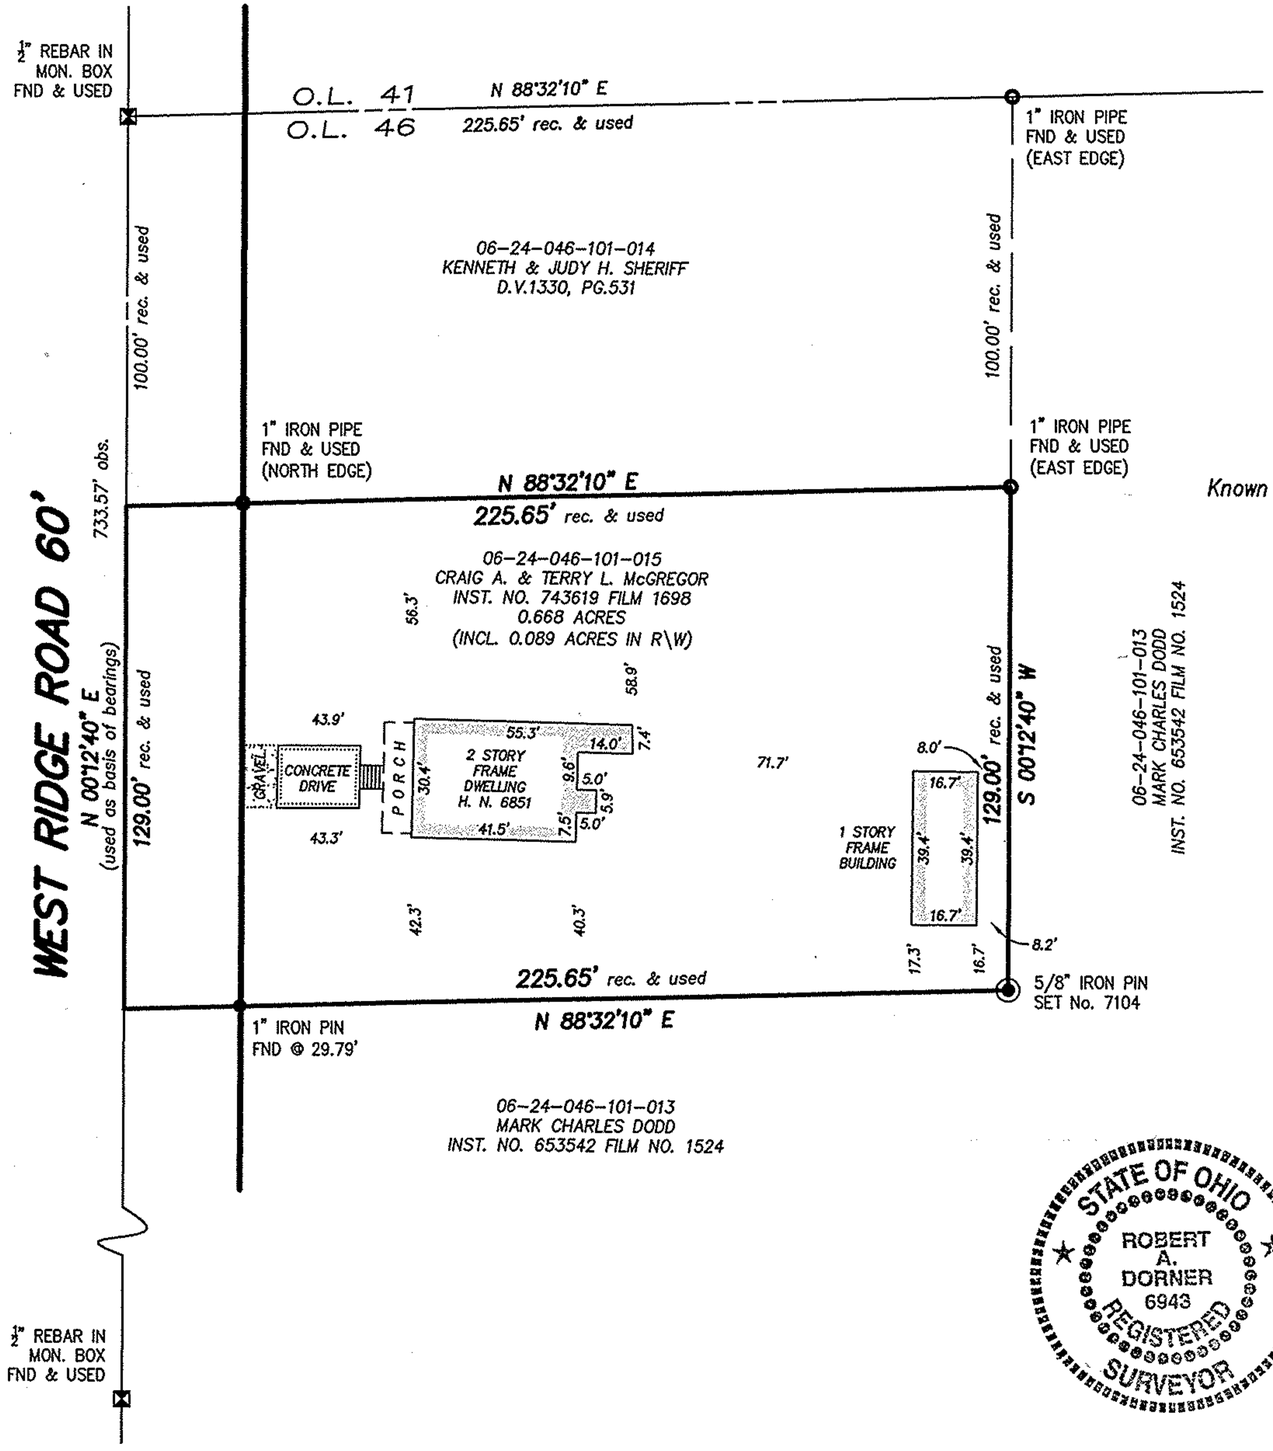

NORTH

GRAPHIC SCALE

40 0 20 40 80

(IN FEET)

1 inch = 40 ft.

MAP OF SURVEY

for

6851 WEST RIDGE ROAD

Known as being part of Original Elyria Township Lot No. 46, West of the Black River, now situated in the

TOWNSHIP OF ELYRIA

COUNTY OF LORAIN — STATE OF OHIO

by

McSTEEN & ASSOCIATES, INC.

ENGINEERS & SURVEYORS

1415 East 286th Street

Wickliffe, Ohio 44092

(440) 585-9800

The basis of bearings for this survey is North 00°-12'-40" East, as the centerline of West Ridge Road, as evidenced by monuments found, and is the same bearing as found on a Map of Survey dated October, 1983, by Norman Hura, Registered Surveyor No. 5208. Distances are given in feet and decimal parts thereof. All iron pins shown as set are 30" long 5/8" rebar with an identification cap stamped "McSTEEN 7104".

STATE OF OHIO ROBERT A. DORNER 6943 REGISTERED SURVEYOR

Robert A. Dorner 8/07/06

ROBERT A. DORNER REG. PROF. SURV. No. 6943

Job No.: 06-265

Survey Date: August 2, 2006