06-02207
15-00-035-000-269 270

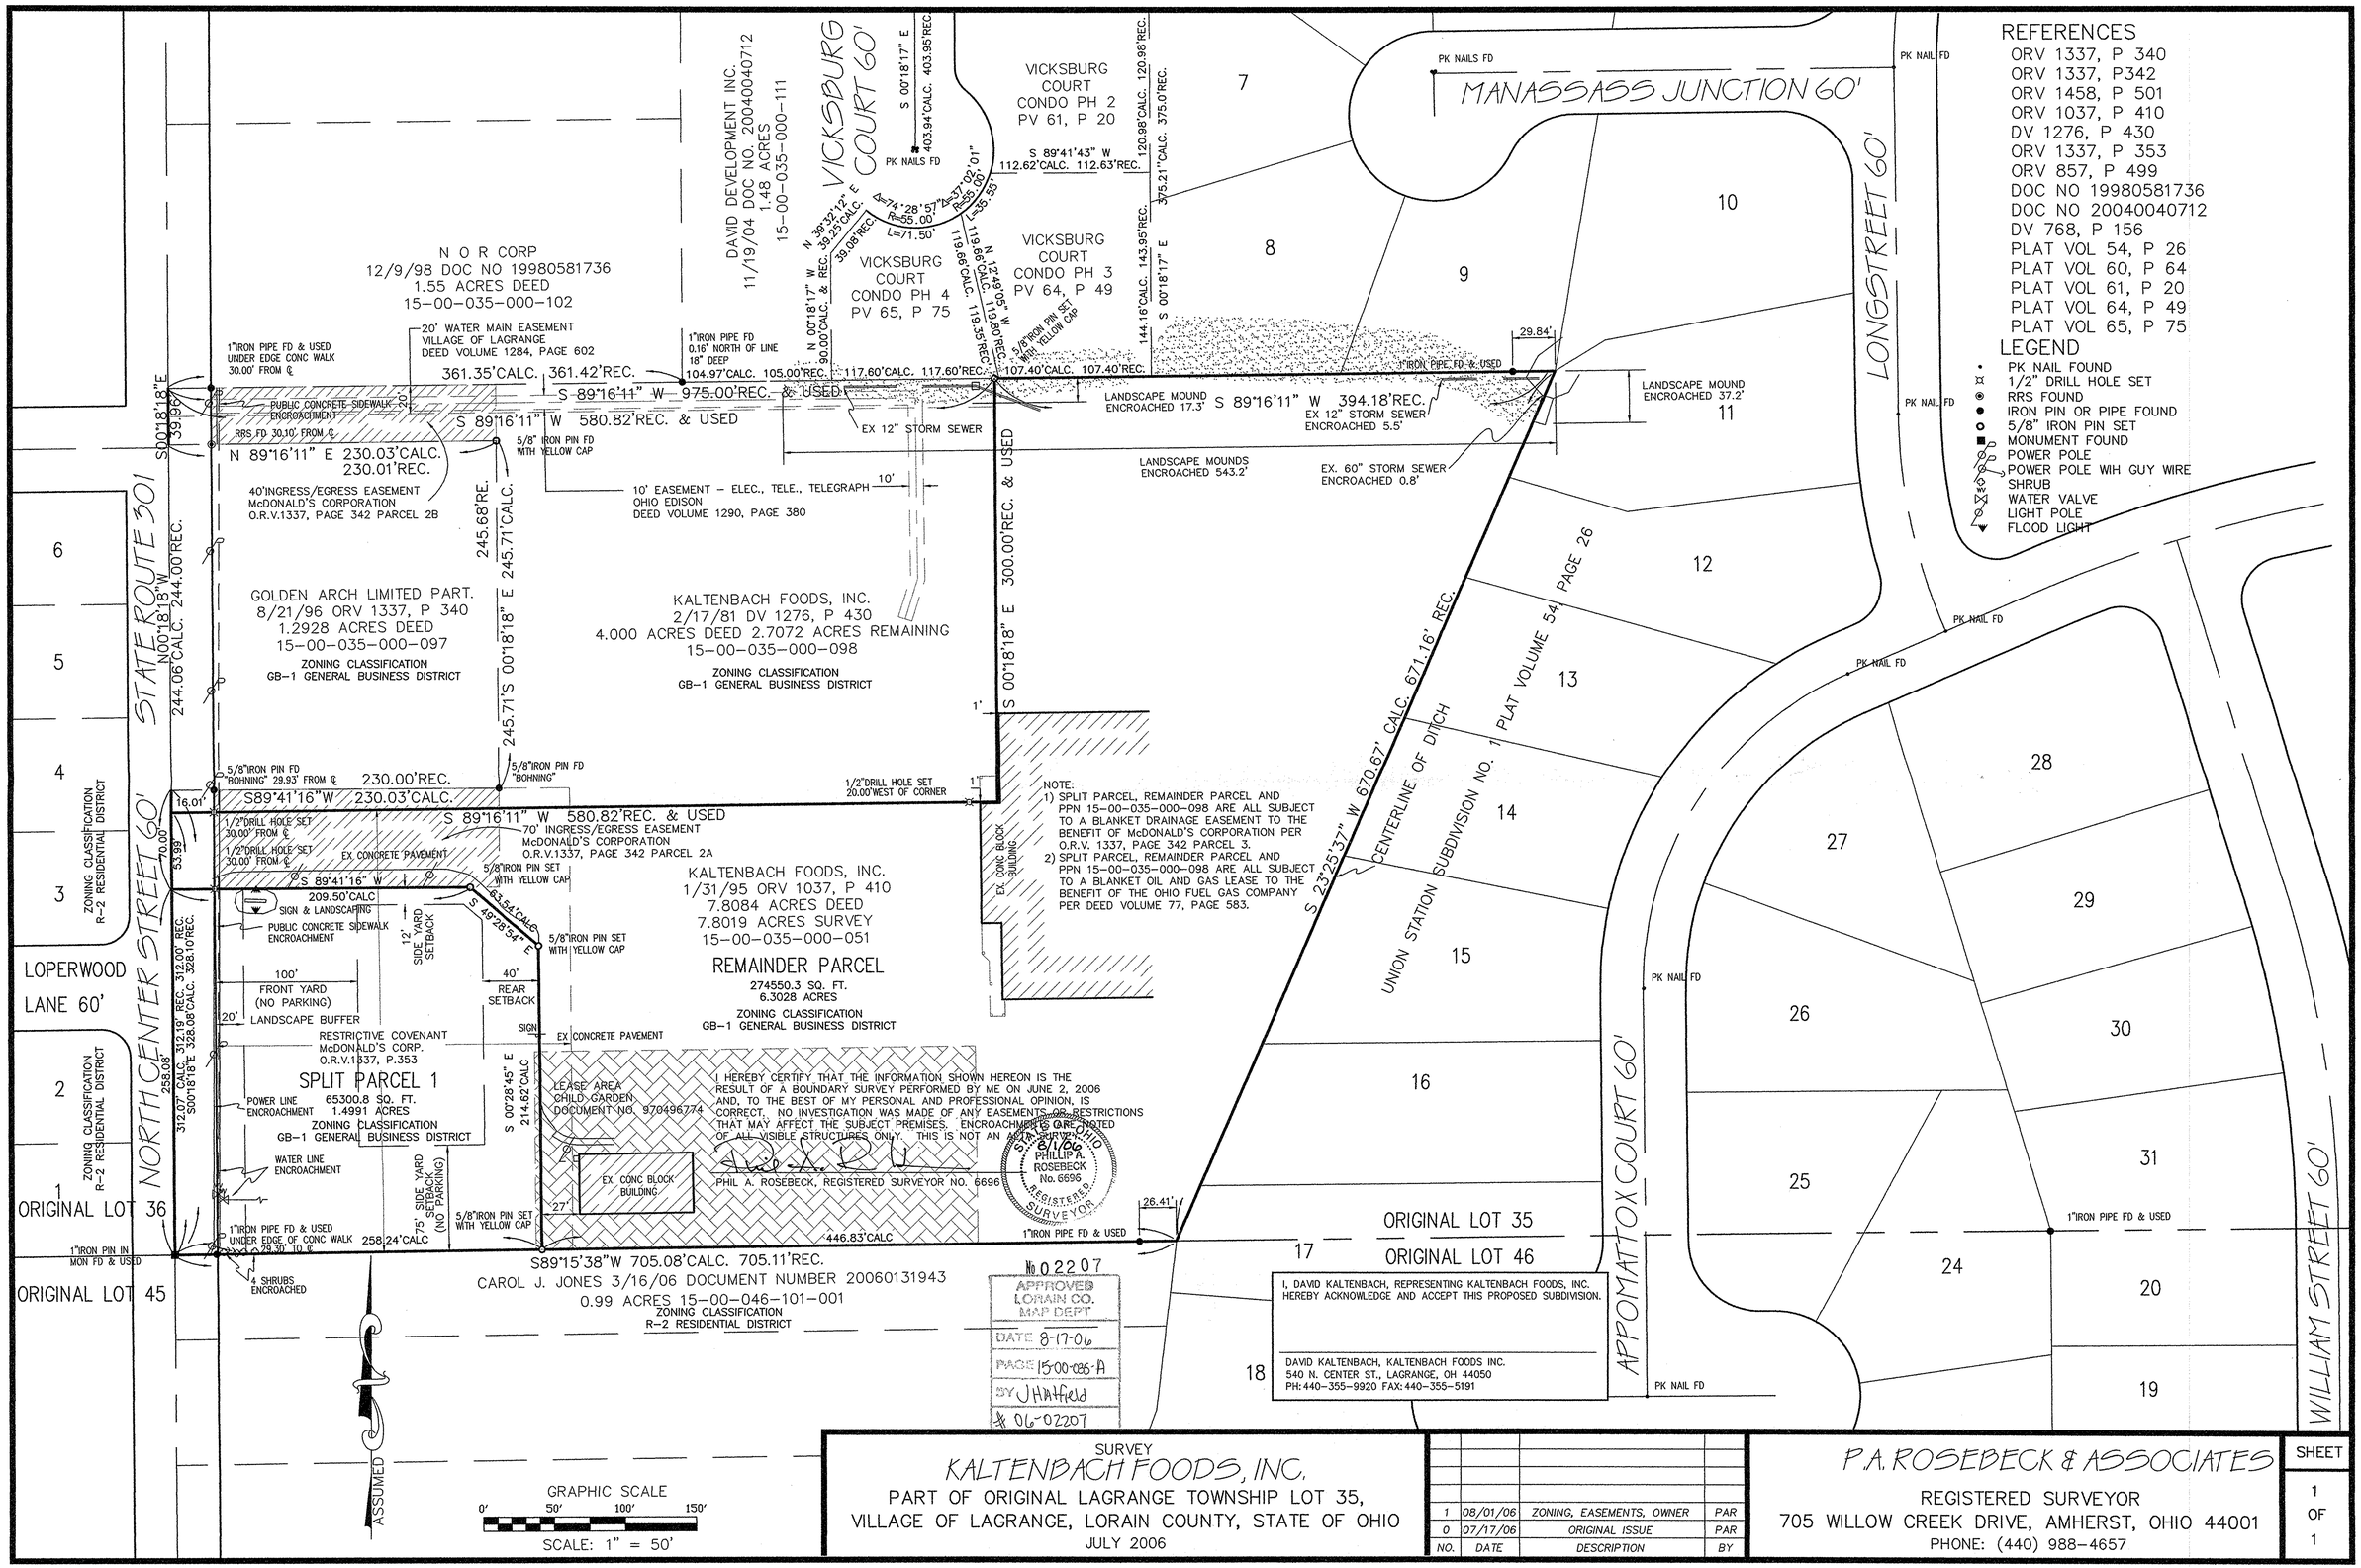

SURVEY
KALTENBACH FOODS, INC.
PART OF ORIGINAL LAGRANGE TOWNSHIP LOT 35,
VILLAGE OF LAGRANGE, LORAIN COUNTY, STATE OF OHIO
JULY 2006

NO.	DATE	DESCRIPTION	BY
1	08/01/06	ZONING, EASEMENTS, OWNER	PAR
0	07/17/06	ORIGINAL ISSUE	PAR

P.A. ROSEBECK & ASSOCIATES
REGISTERED SURVEYOR
705 WILLOW CREEK DRIVE, AMHERST, OHIO 44001
PHONE: (440) 988-4657

SHEET 1 OF 1