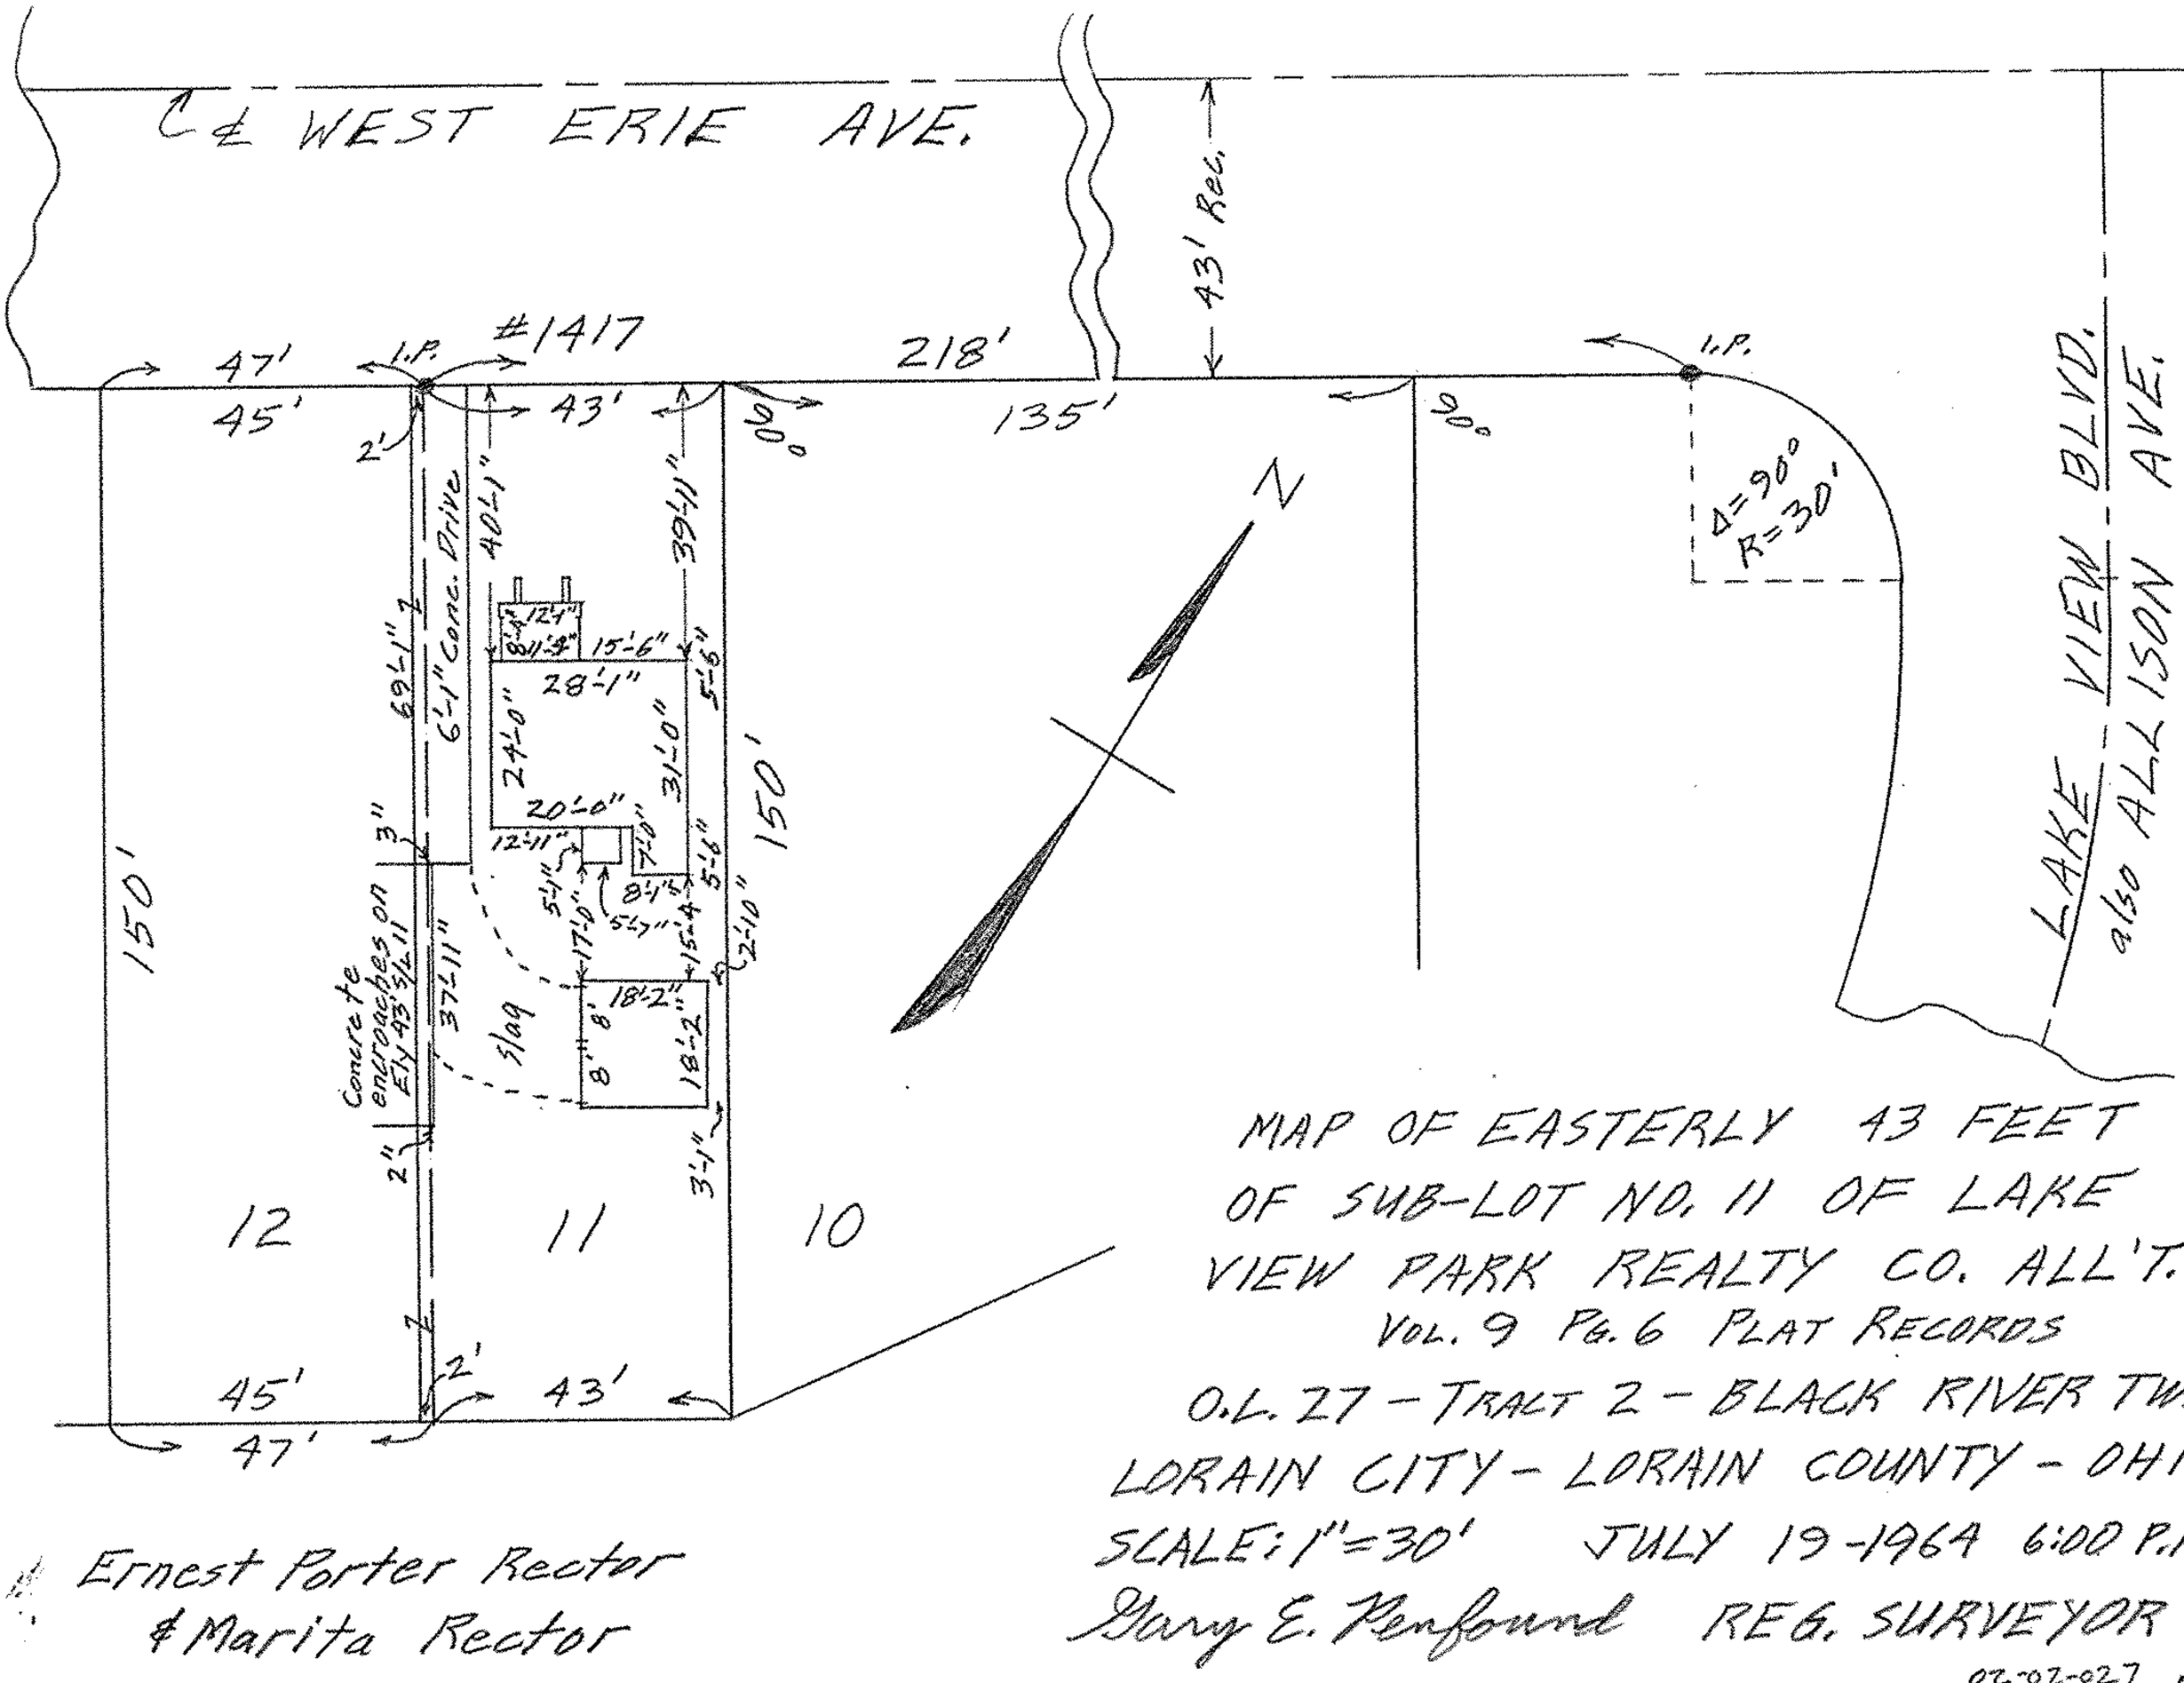

MAP OF EASTERLY 43 FEET OF SUB-LOT NO. 11 OF LAKE VIEW PARK REALTY CO. ALL'T.
VOL. 9 PG. 6 PLAT RECORDS
O.L. 27 - TRACT 2 - BLACK RIVER TWP.
LORAIN CITY - LORAIN COUNTY - OHIO
SCALE: 1"=30' JULY 19-1964 6:00 P.M.
Gary E. Penfound REG. SURVEYOR

Ernest Porter Rector
& Marita Rector

02-02-027 PC