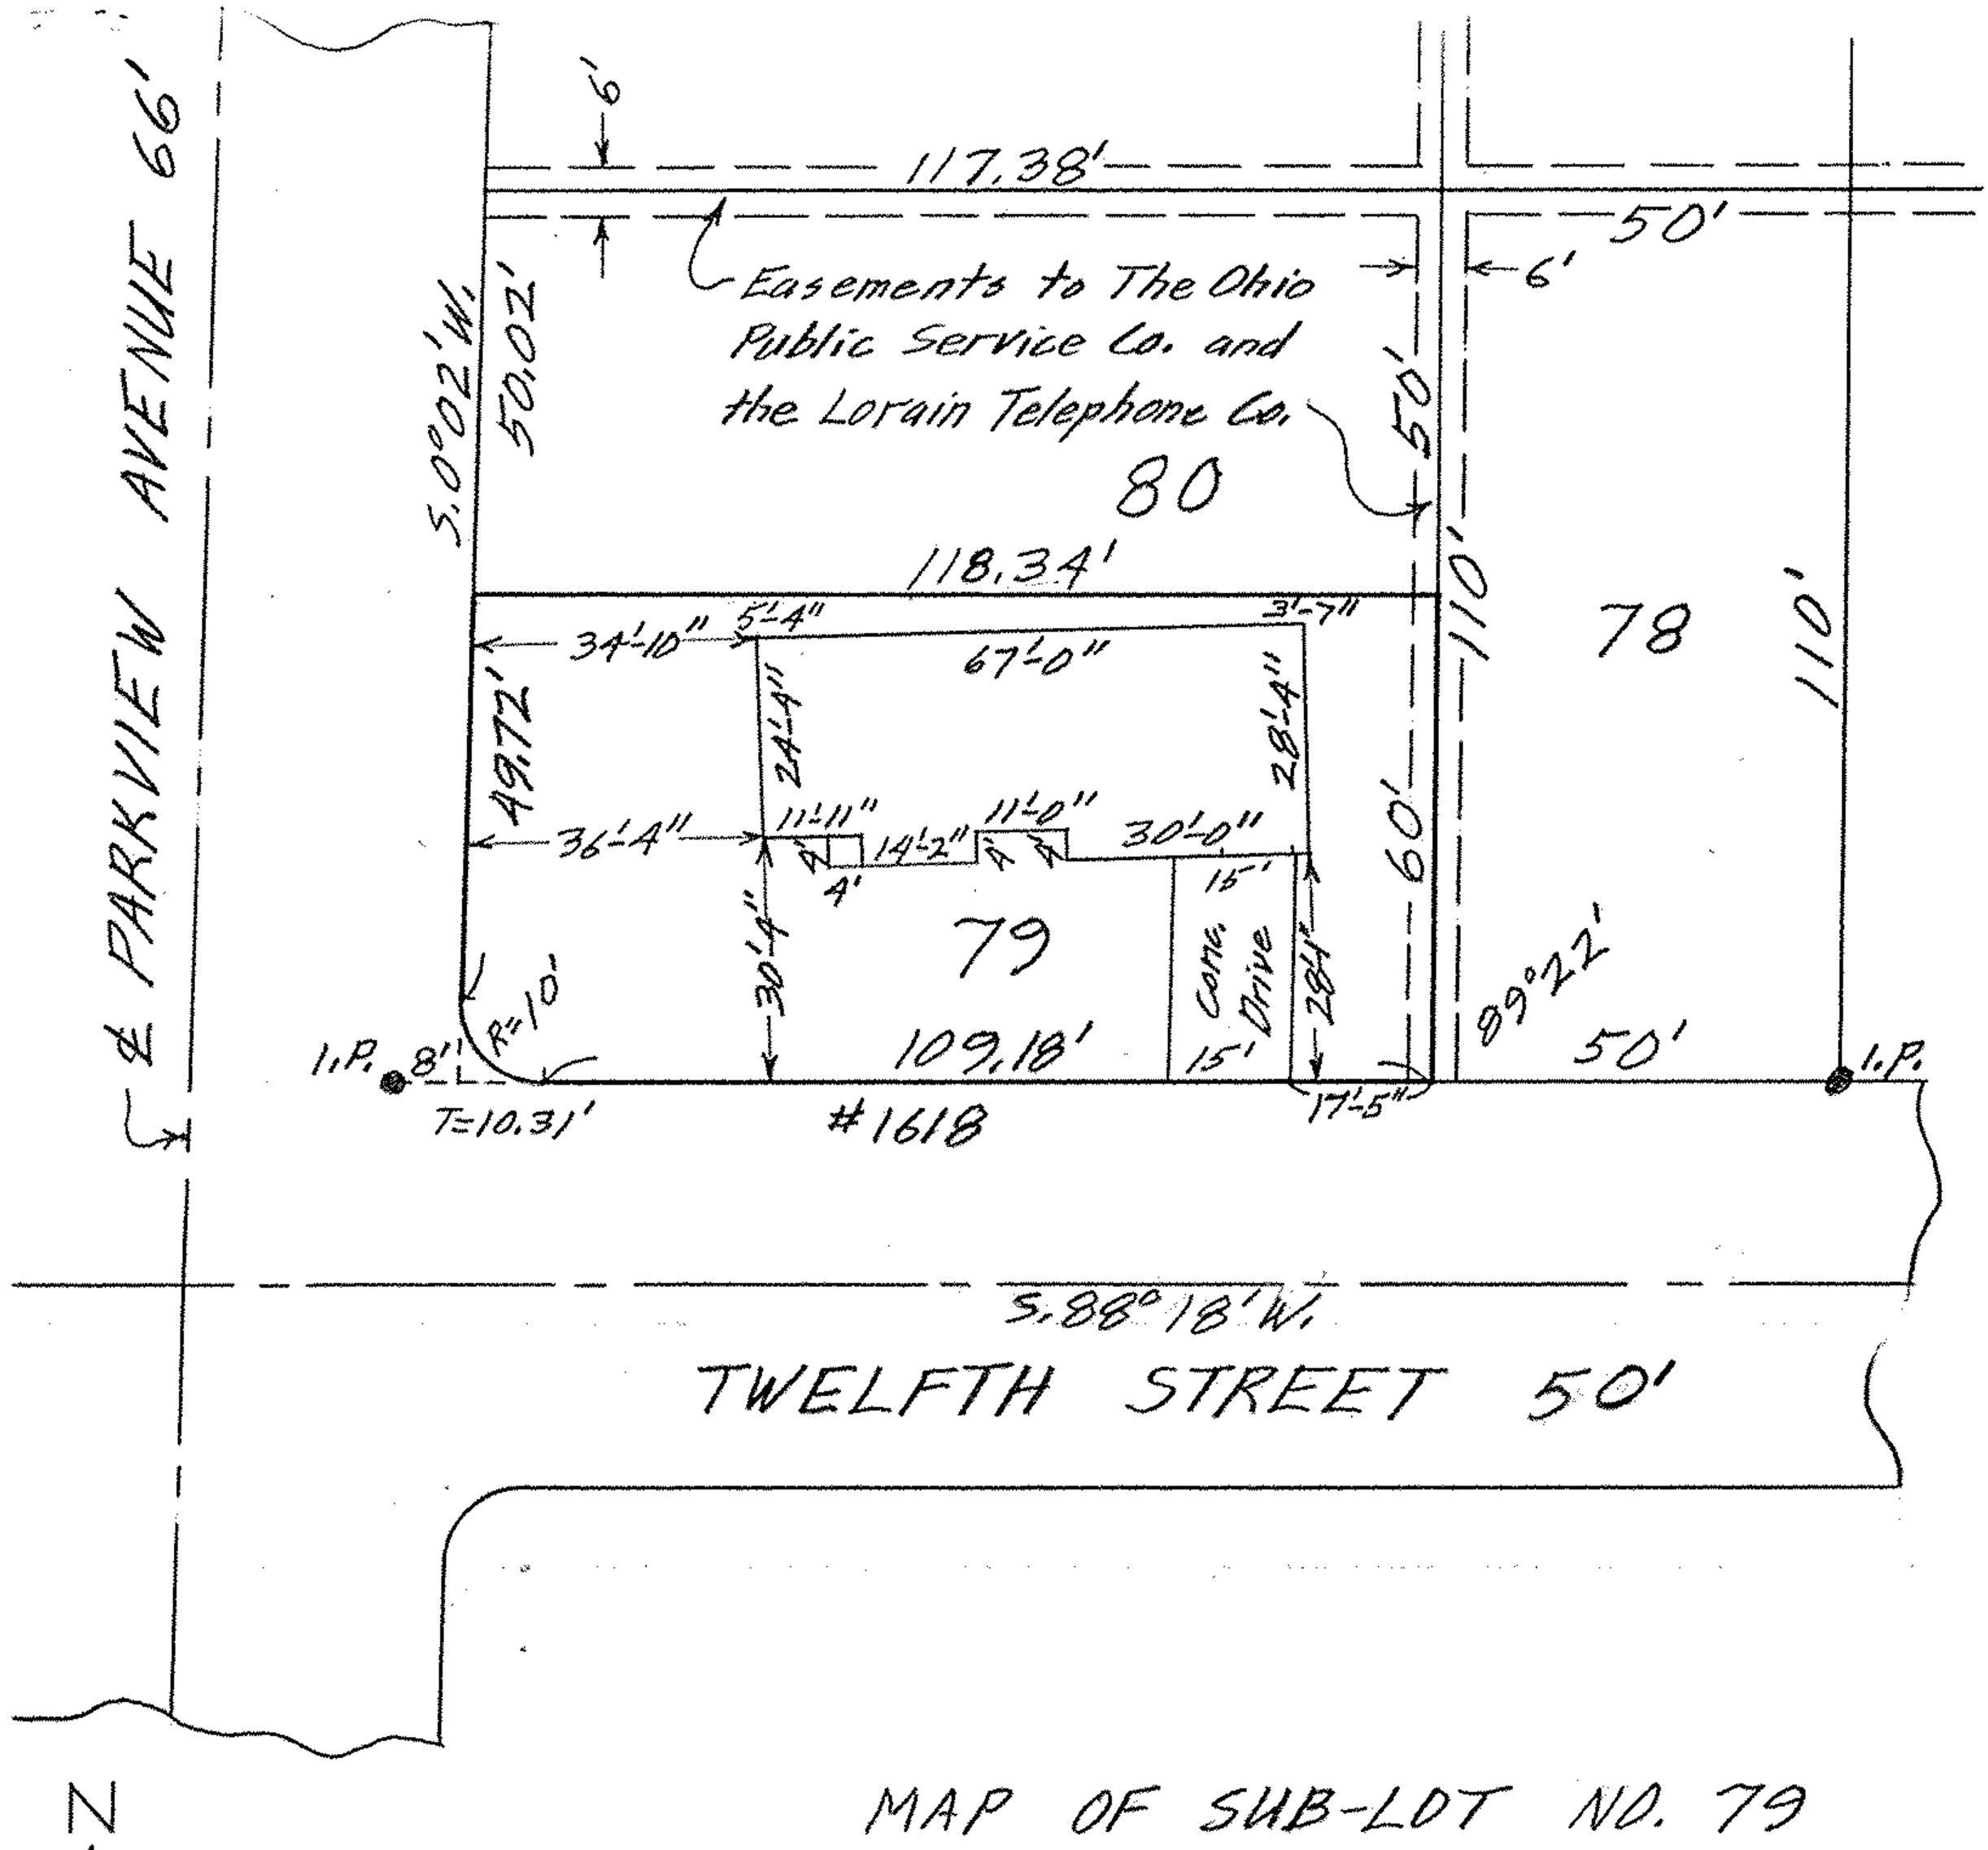

N

MAP OF SUB-LOT NO. 79
LAKE VIEW PARK HOMES ALL'T. VOL.14 PG.15
ORIG. LOT 27 - TRACT 2 - BLACK RIVER TWP.
LORAIN CITY - LORAIN COUNTY - OHIO
SCALE: 1" = 30' NOV. 24-1965 11:30 A.M.
Gary E. Penfound REG. SURVEYOR

Norman J. & Evelyn L. Beller

BH

02-02-027