MAP OF SUB-LOT NO. 217

LAKE VIEW PARK REALTY CO. ALL'T.
SECOND ADD'N. VOL. 9. PG. 28
ORIG. LOT 27 - TRACT 2 - BLACK RIVER TWP.
LORAIN CITY - LORAIN COUNTY - OHIO
SCALE: 1"=30' OCT. 2-1965 12:15 P.M.
Gary E. Penfound REG. SURVEYOR

Order No. 1276
WAGNER, William W. & Linda S.

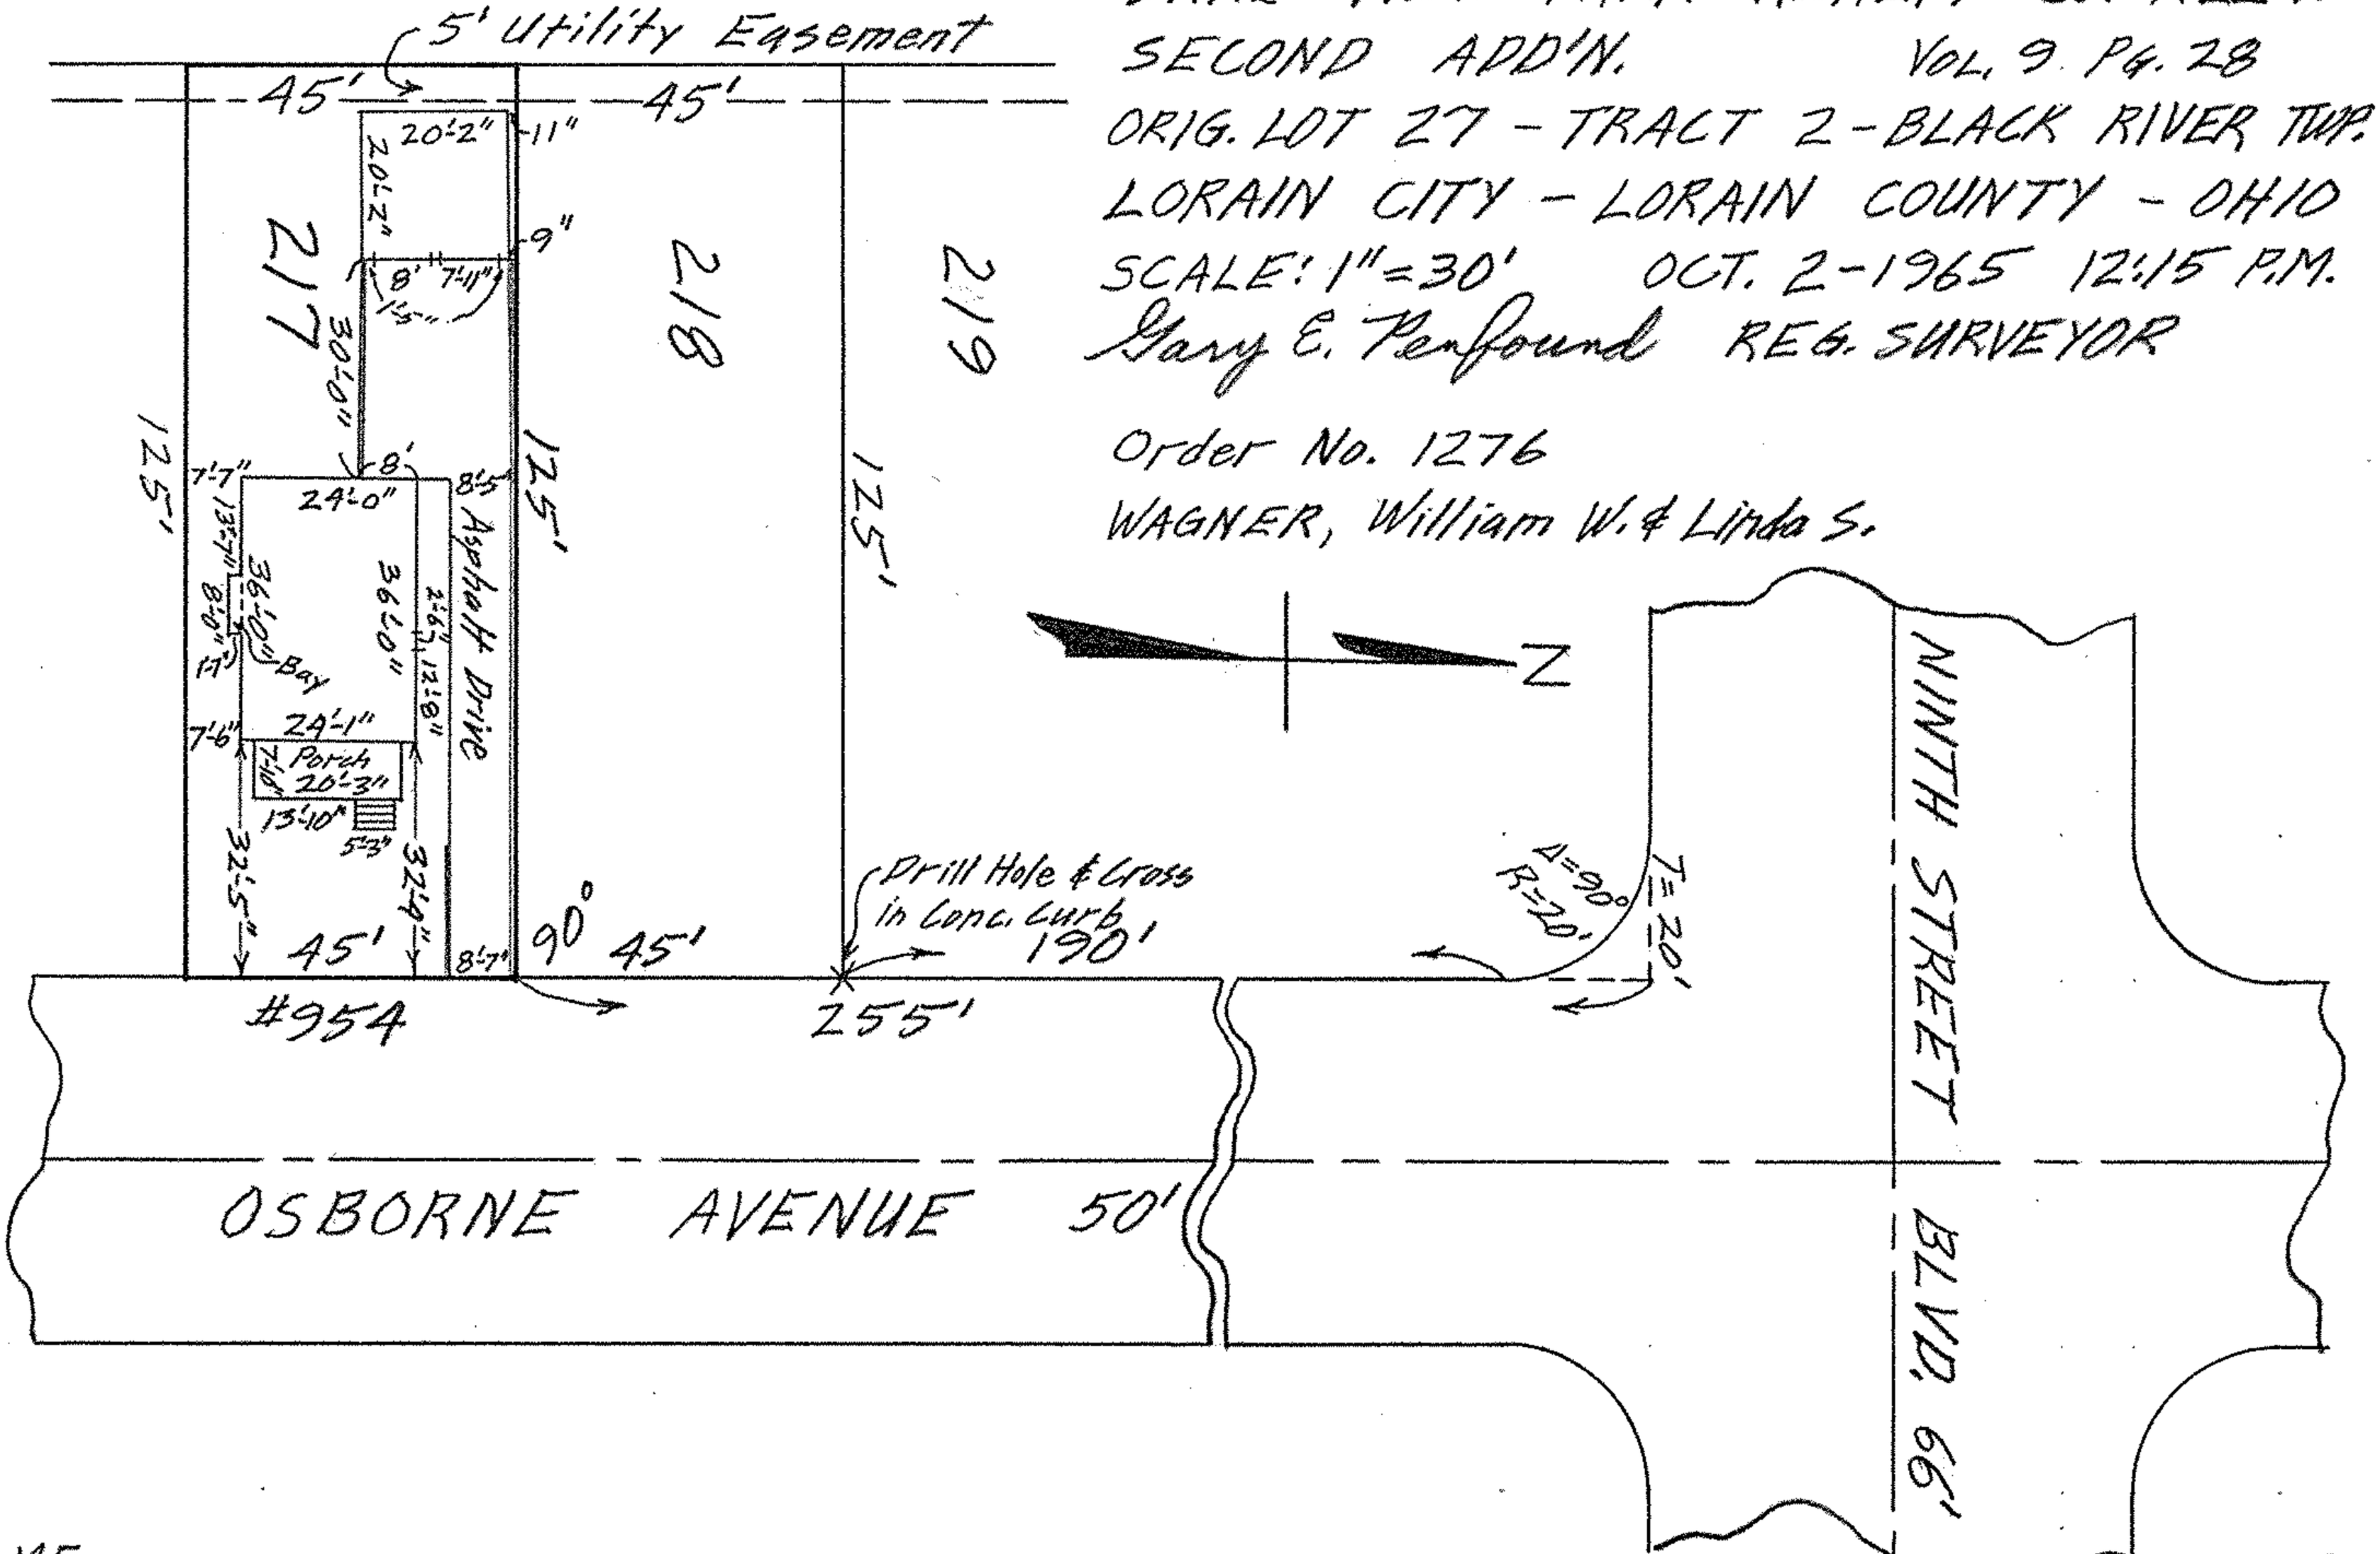

MF

02-02-027