BOUNDARY SURVEY
FOR
P.P. # 05-00-024-101-001
PART OF S/L # 1 & S/L # 2
SITUATED IN THE CITY OF AMHERST, COUNTY OF LORAIN
& STATE OF OHIO AND KNOWN AS BEING PART OF ORG.
AMHERST TOWNSHIP LOT NO. 24 SHOWN
BY THE RECORDED PLAT IN VOLUME "J" PAGE 166 OF
LORAIN COUNTY RECORDS.

LEGEND:

- I.P. SET
- I. PIN / I. PIPE FD.
- PK. NAIL SET/FD.

EHTESHAM M. SUHAIL, P.S. 7806

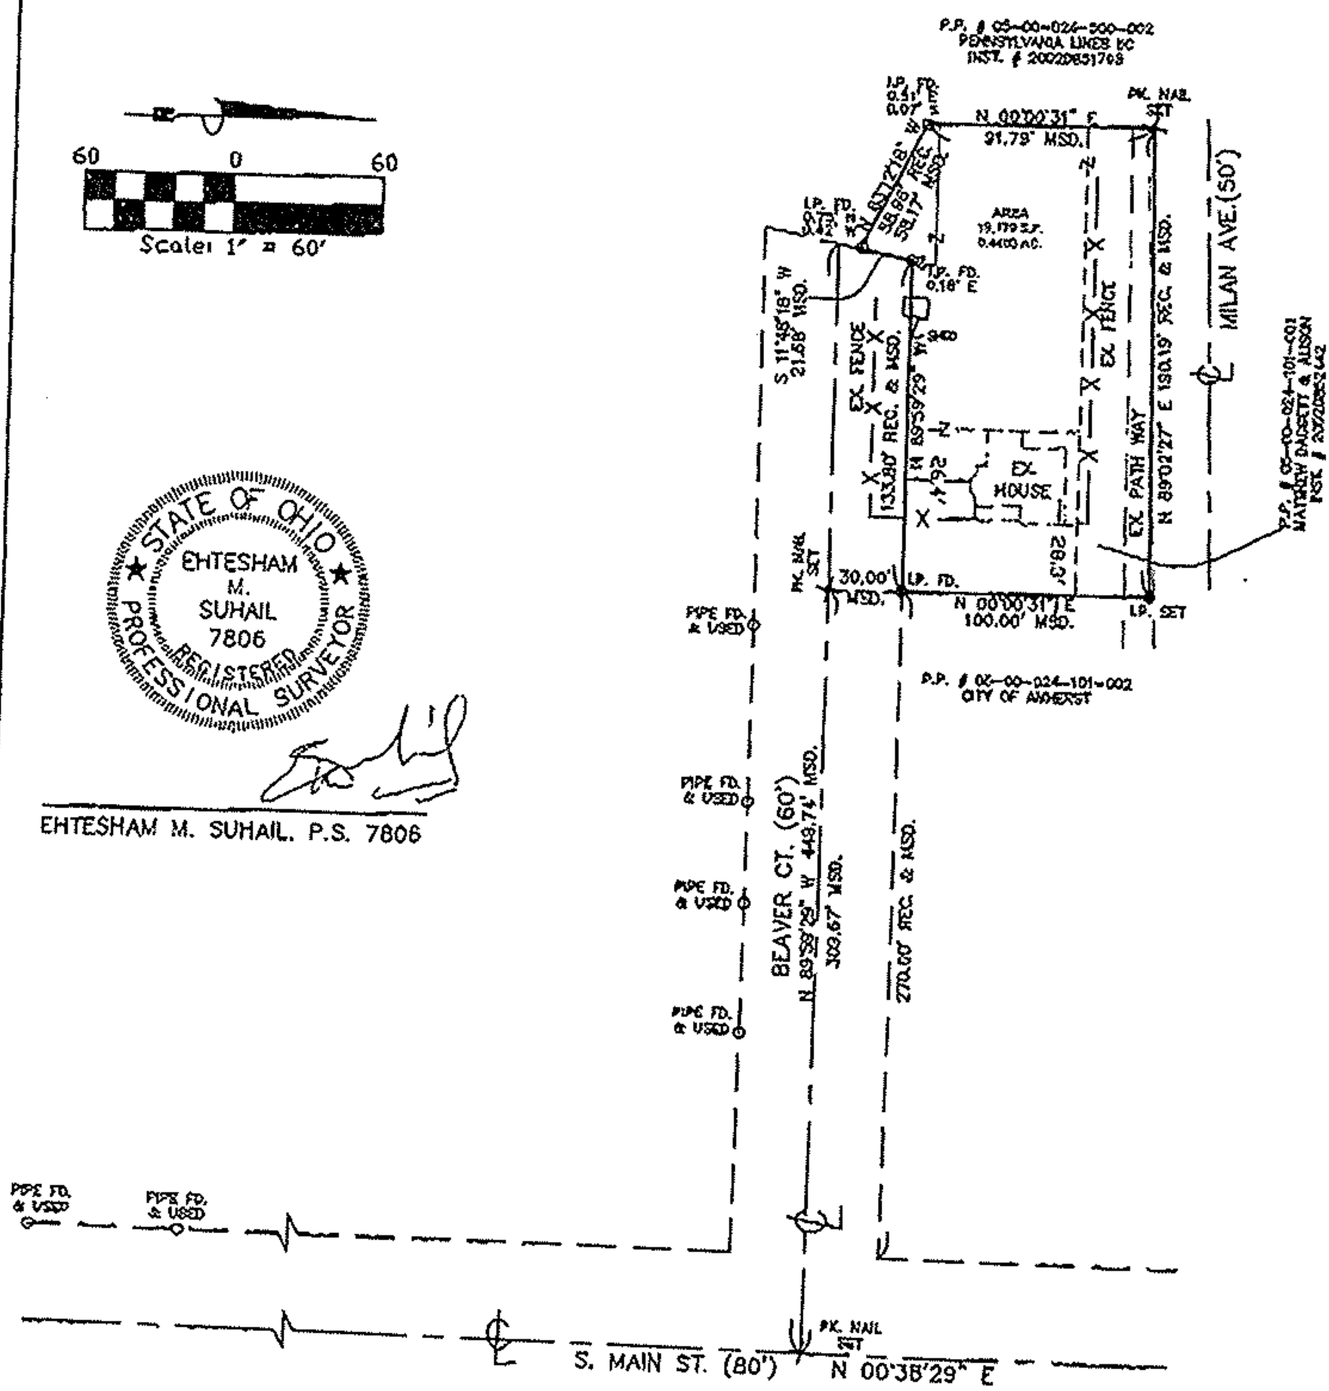

Suhail & Suhail, Inc. Consulting Engineers & Surveyors 8601 Chagrin Road, Suite 17 Chagrin Falls, Ohio 44023 (440) 708-1330 Fax: (440) 708-1334		BOUNDARY SURVEY FOR P.P. # 05-00-024-101-001 PART OF S/L NO. 1 & S/L NO. 2	for NATIONWIDE TITLE AGENCY, LTD. 05109 | 1 OF 1