07-00-030-000-128, 129
#06-02193

THOMAS SIMON & ASSOCIATES, INC.
PROFESSIONAL LAND SURVEYORS

COBBLESTONE CORNER PROFESSIONAL CENTER
39049 CENTER RIDGE ROAD
NORTH RIDGEVILLE, OHIO 44039
(440) 327-2925
FAX 327-2964

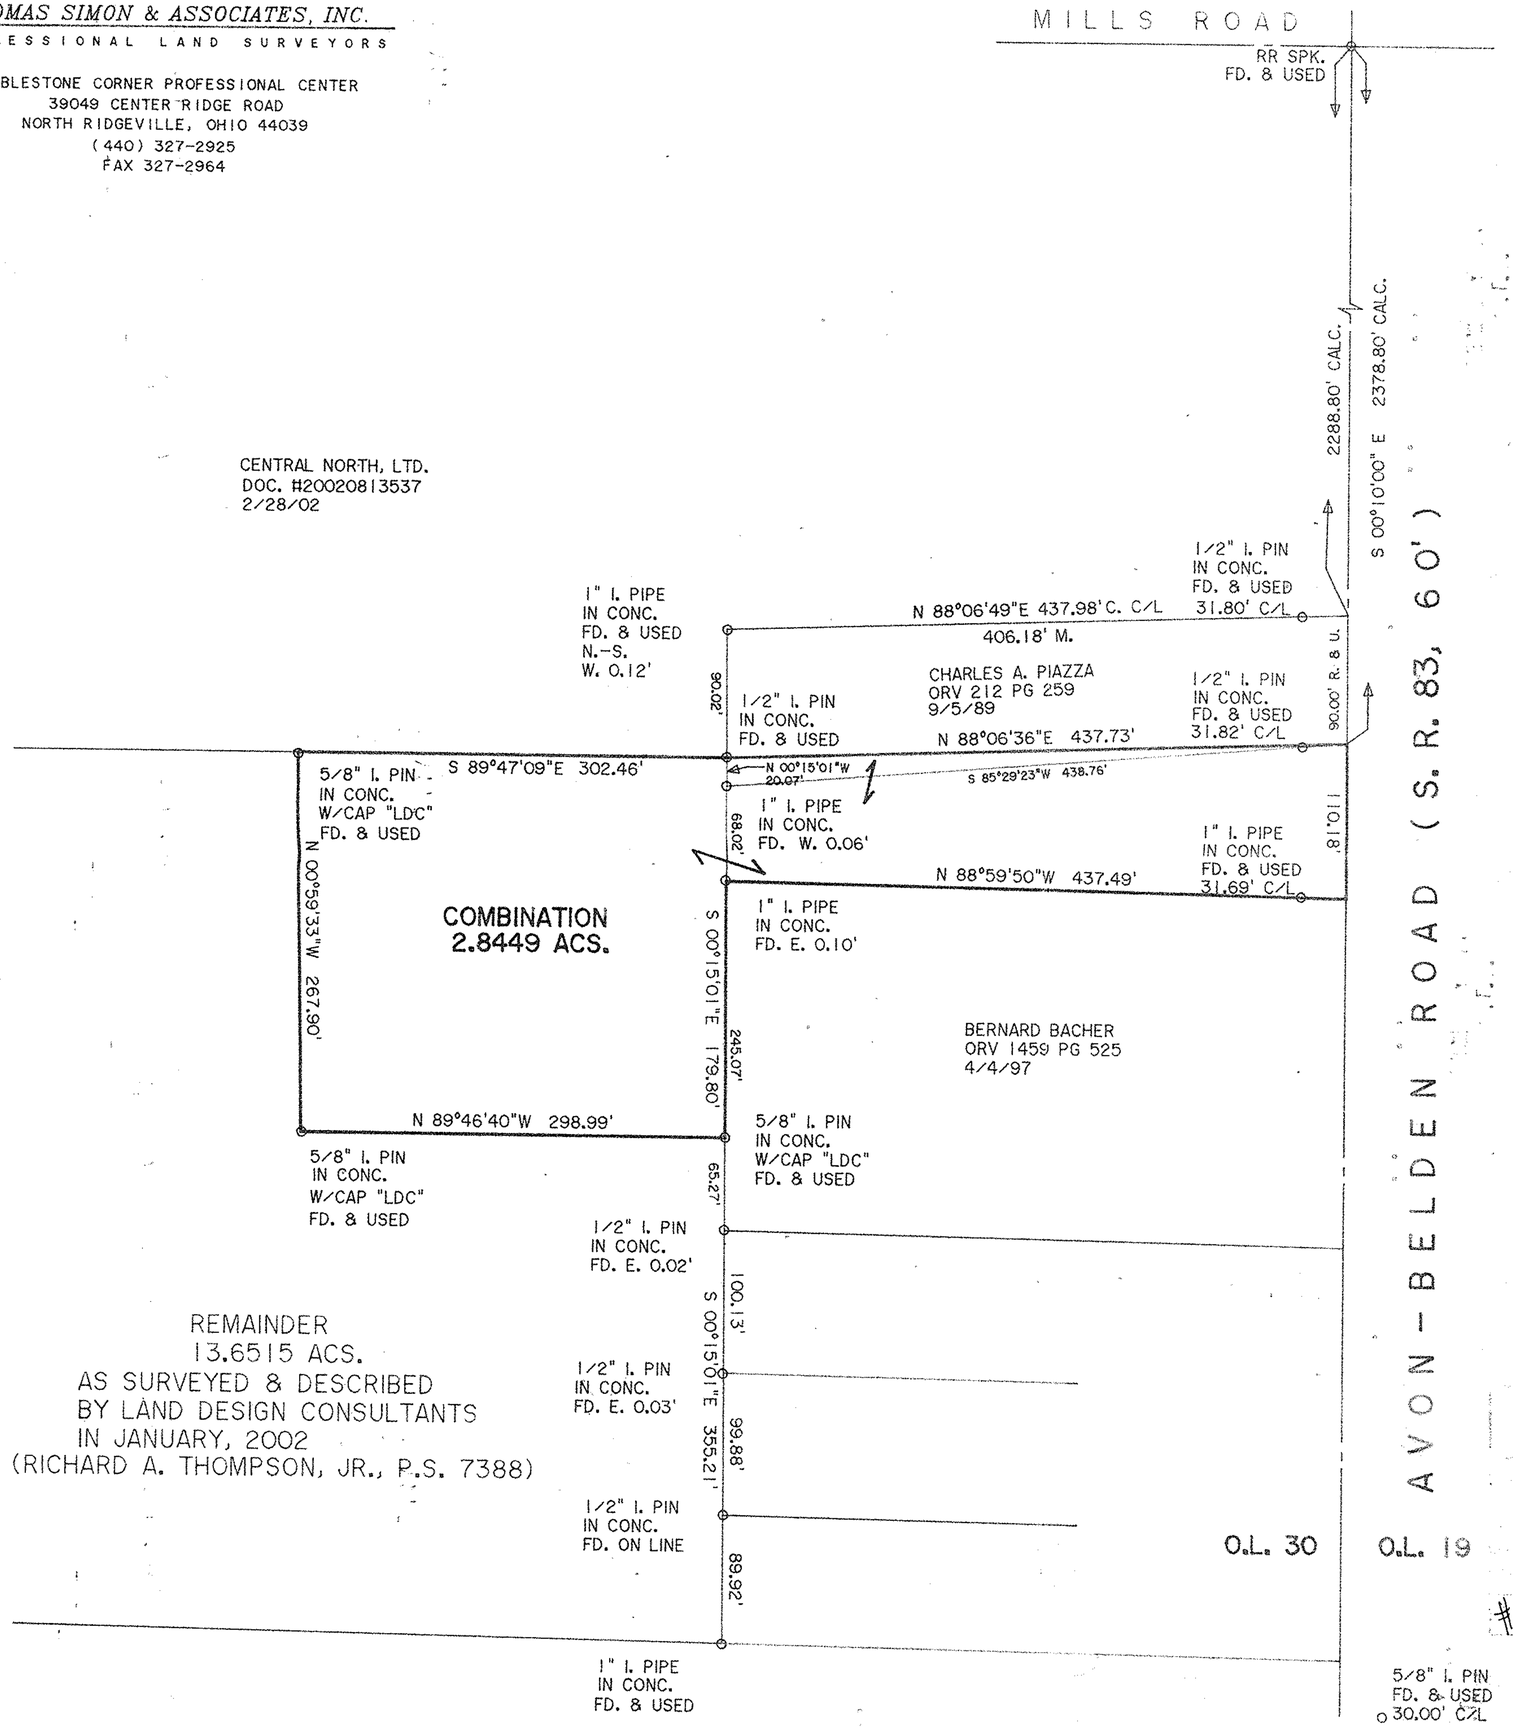

80 0 80 160 240
GRAPHIC SCALE - FEET

DIMENSIONS SHOWN ON THIS PLAT ARE EXPRESSED IN FEET AND DECIMAL PARTS THEREOF, ALL BEARINGS ARE TO AN ASSUMED MERIDIAN AND ARE USED TO INDICATE ANGLES ONLY. PERMANENT MONUMENTS WERE FOUND OR SET AT ALL POINTS INDICATED HEREON, ALL OF WHICH I CERTIFY TO BE CORRECT.

STATE OF OHIO * THOMAS A. SIMON S-7775 * REGISTERED PROFESSIONAL SURVEYOR

THOMAS A. SIMON
REG. PROFESSIONAL SURVEYOR
NO. S-7775

BASIS OF BEARINGS IS THE CENTERLINE OF AVON-BELDEN ROAD (STATE ROUTE 83), SOUTH 00°10'00" EAST.

No 02193
7-26-06
7-00-030-D
Heatfield
#06-02193

PLAT OF SURVEY & COMBINATION FOR CHARLES PIAZZA

BEING KNOWN AS PART OF ORIGINAL RIDGEVILLE TOWNSHIP LOT NO. 30

CITY OF NORTH RIDGEVILLE COUNTY OF LORAIN
STATE OF OHIO

JUNE, 2006 SCALE: 1" = 80'

JOB NO. 2006-032