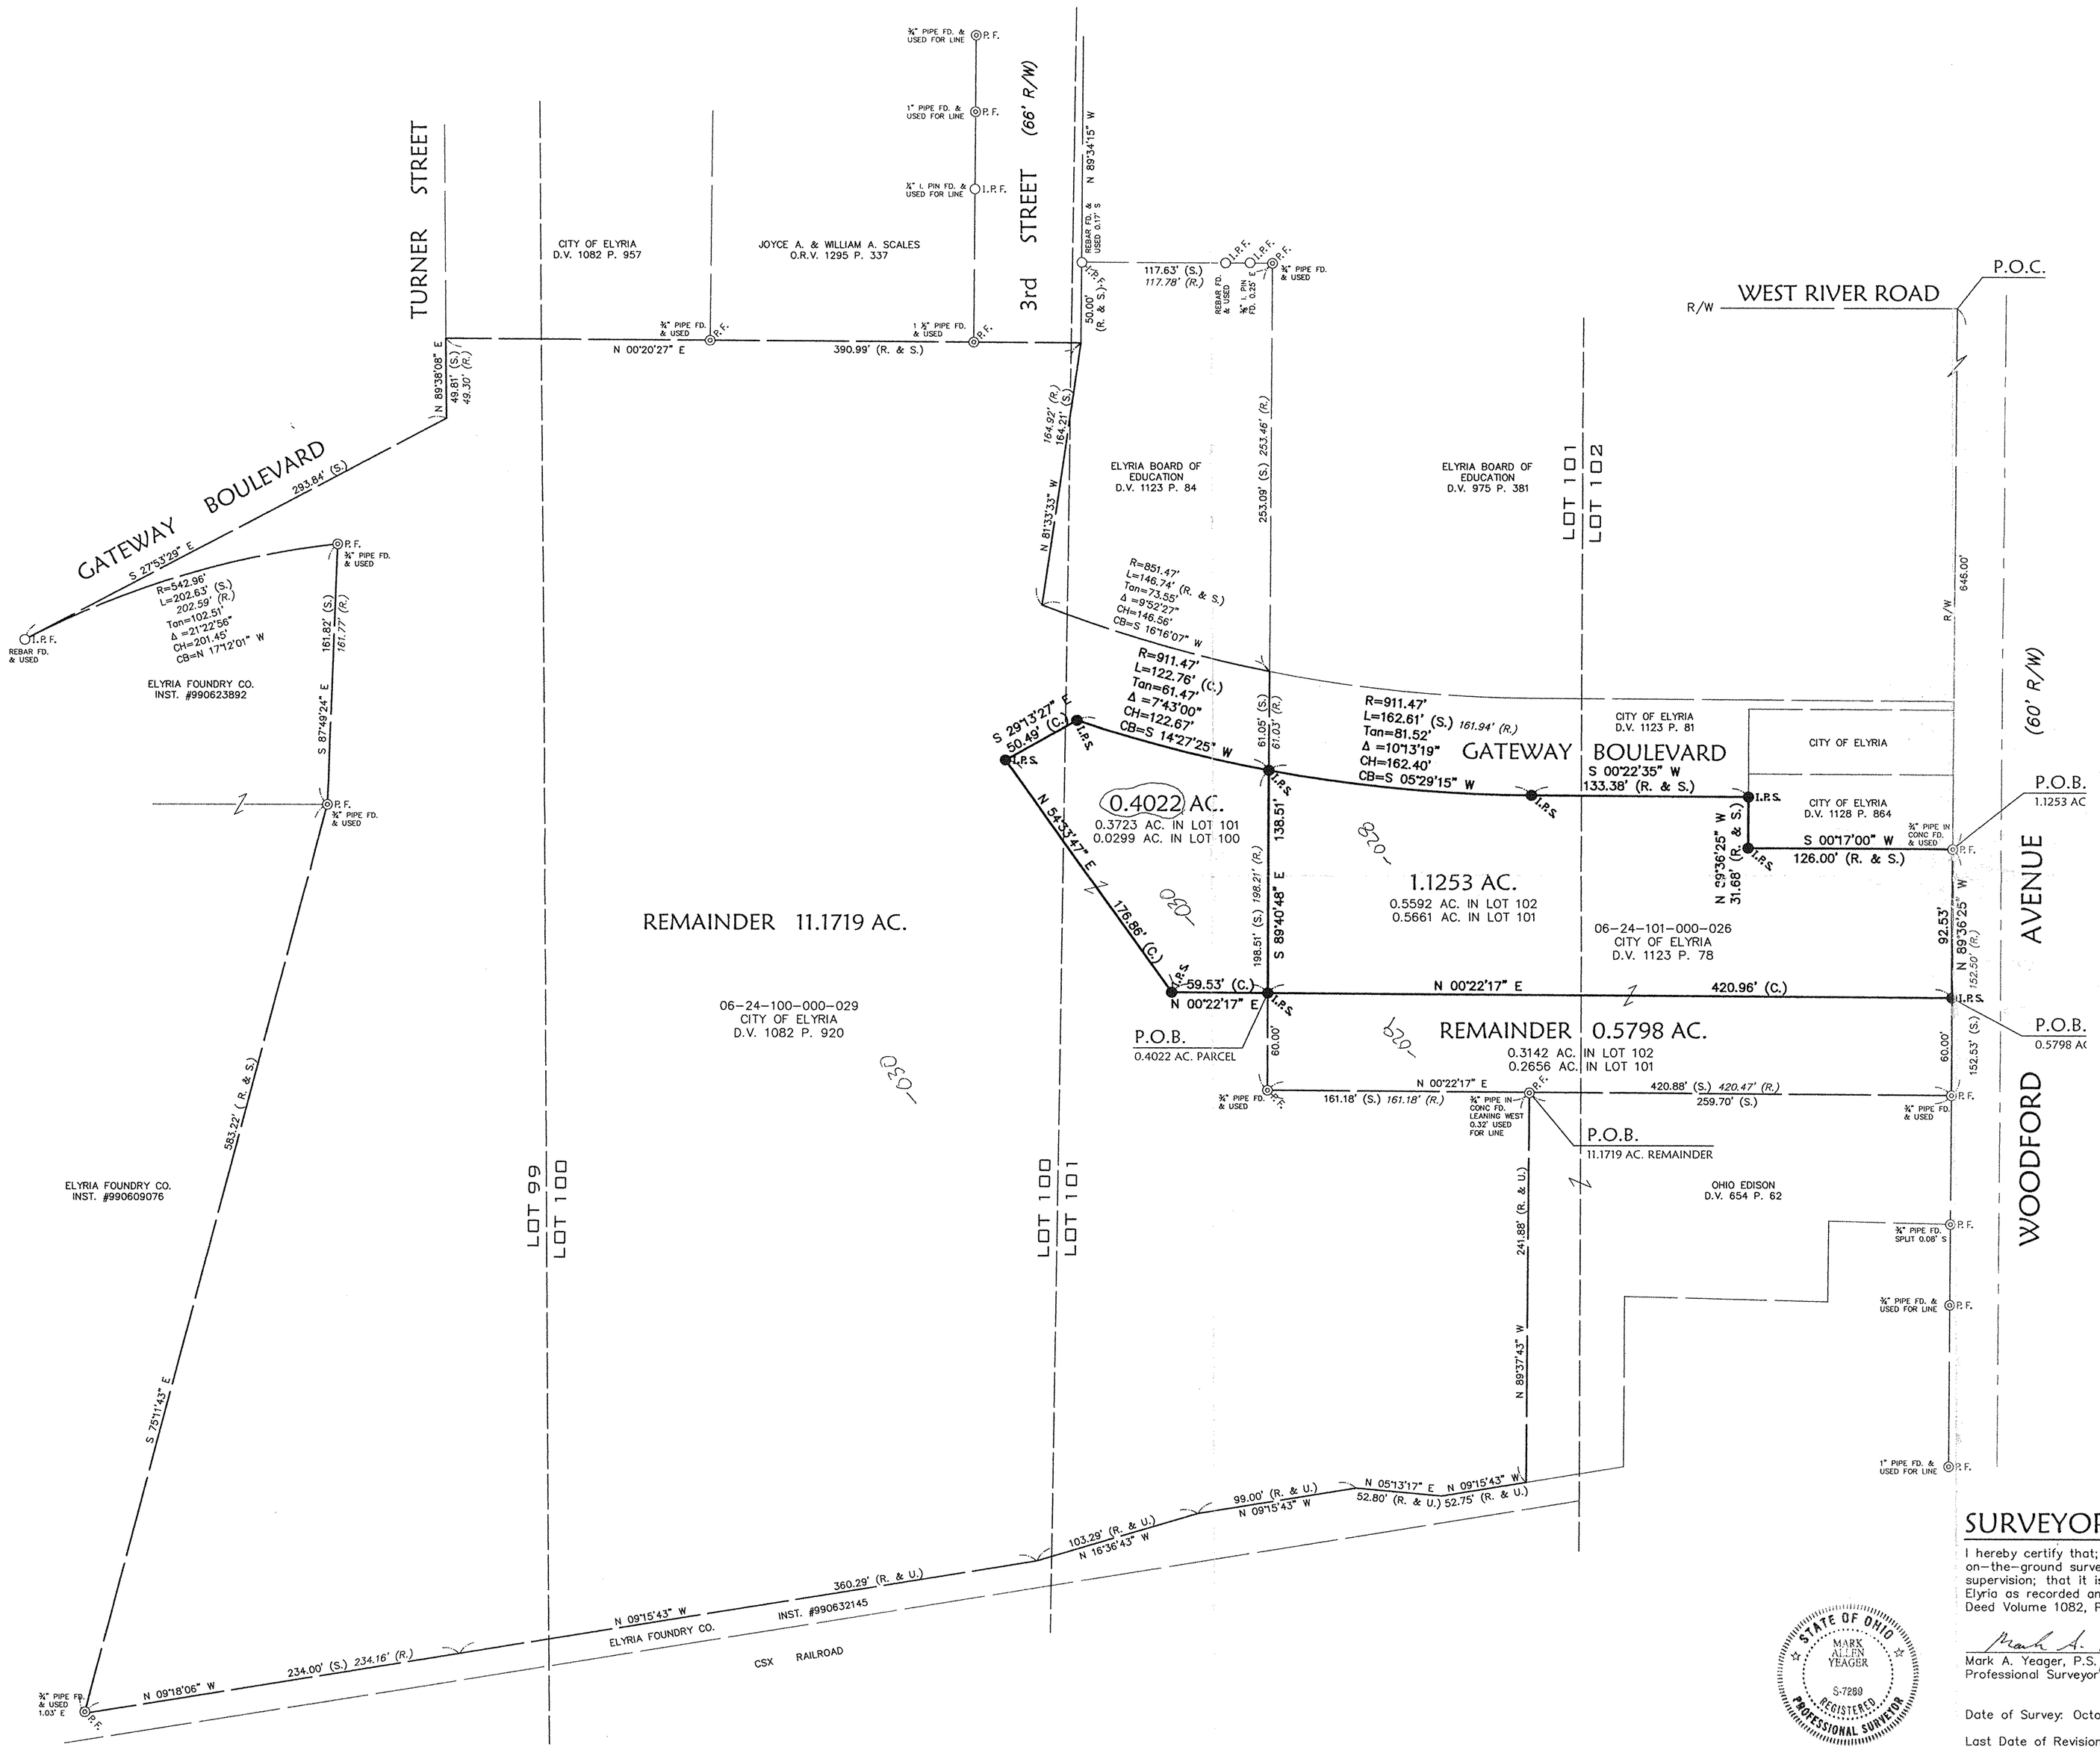


## LEGEND

- ○ I.P.F. REBAR/IRON PIN FOUND
- ⊗ P.F. IRON PIPE FOUND
- ● I.R.S. 5/8" CAPPED REBAR SET

## ABBREVIATIONS

- C. – CALCULATED
- FD. – FOUND
- R. – RECORD
- S. – SURVEYED
- U. – USED

06-24-101-000-029, 030
026, 027
028, 029
030

No 01280
APPROVED
LORAIN CO.
MAP DEPT.
DATE 12-31-02
PAGE 6-117
BY R. MAINES
NO. 02-01280

## SURVEYOR'S CERTIFICATION

I hereby certify that; the survey shown hereon is the result of an on-the-ground survey that has been performed by me or under my supervision; that it is a survey of the lands conveyed to the City of Elyria as recorded among the land records of Lorain County, Ohio in Deed Volume 1082, Page 920 and Deed Volume 1123, Page 78.

Mark A. Yeager 10/15/02
Mark A. Yeager, P.S. Date
Professional Surveyor Ohio Reg. No. 7289

STATE OF OHIO MARK ALLEN YEAGER S-7289 REGISTERED PROFESSIONAL SURVEYOR

Date of Survey: October 9, 2002

Last Date of Revision:

| REVISIONS | | | |
|---|---|---|---|
| DATE | DESCRIPTION | BY | |
| 10-11-02 | ORIGINAL ISSUE | | ABR |

DATE: 10-11-02
DRAWN BY: ABR
CHD BY:
DWG. NAME: O-SRU101
PATH: 02046
F.B.:

KS ASSOCIATES, INC.
200 Burns Road, Suite 100
Elyria, Ohio 44035
Phone (440) 365-4750
Fax (440) 365-4790
mail@ksassoc.com
www.ksassoc.com

KS ASSOCIATES

# SURVEY MAP

OF PART OF ORIGINAL ELYRIA TOWNSHIP LOTS 99, 100, 101 & 102
WEST OF BLACK RIVER
CITY OF ELYRIA, COUNTY OF LORAIN, STATE OF OHIO

SHEET 1 OF 1

JOB NO. 02046