


# Plat of Survey for David Treaster

Being a part of Lot 10 within Tract 12,  
Henrietta Township, Lorain County, Ohio

D.W. & B.A. Treaster  
RN 20000709858

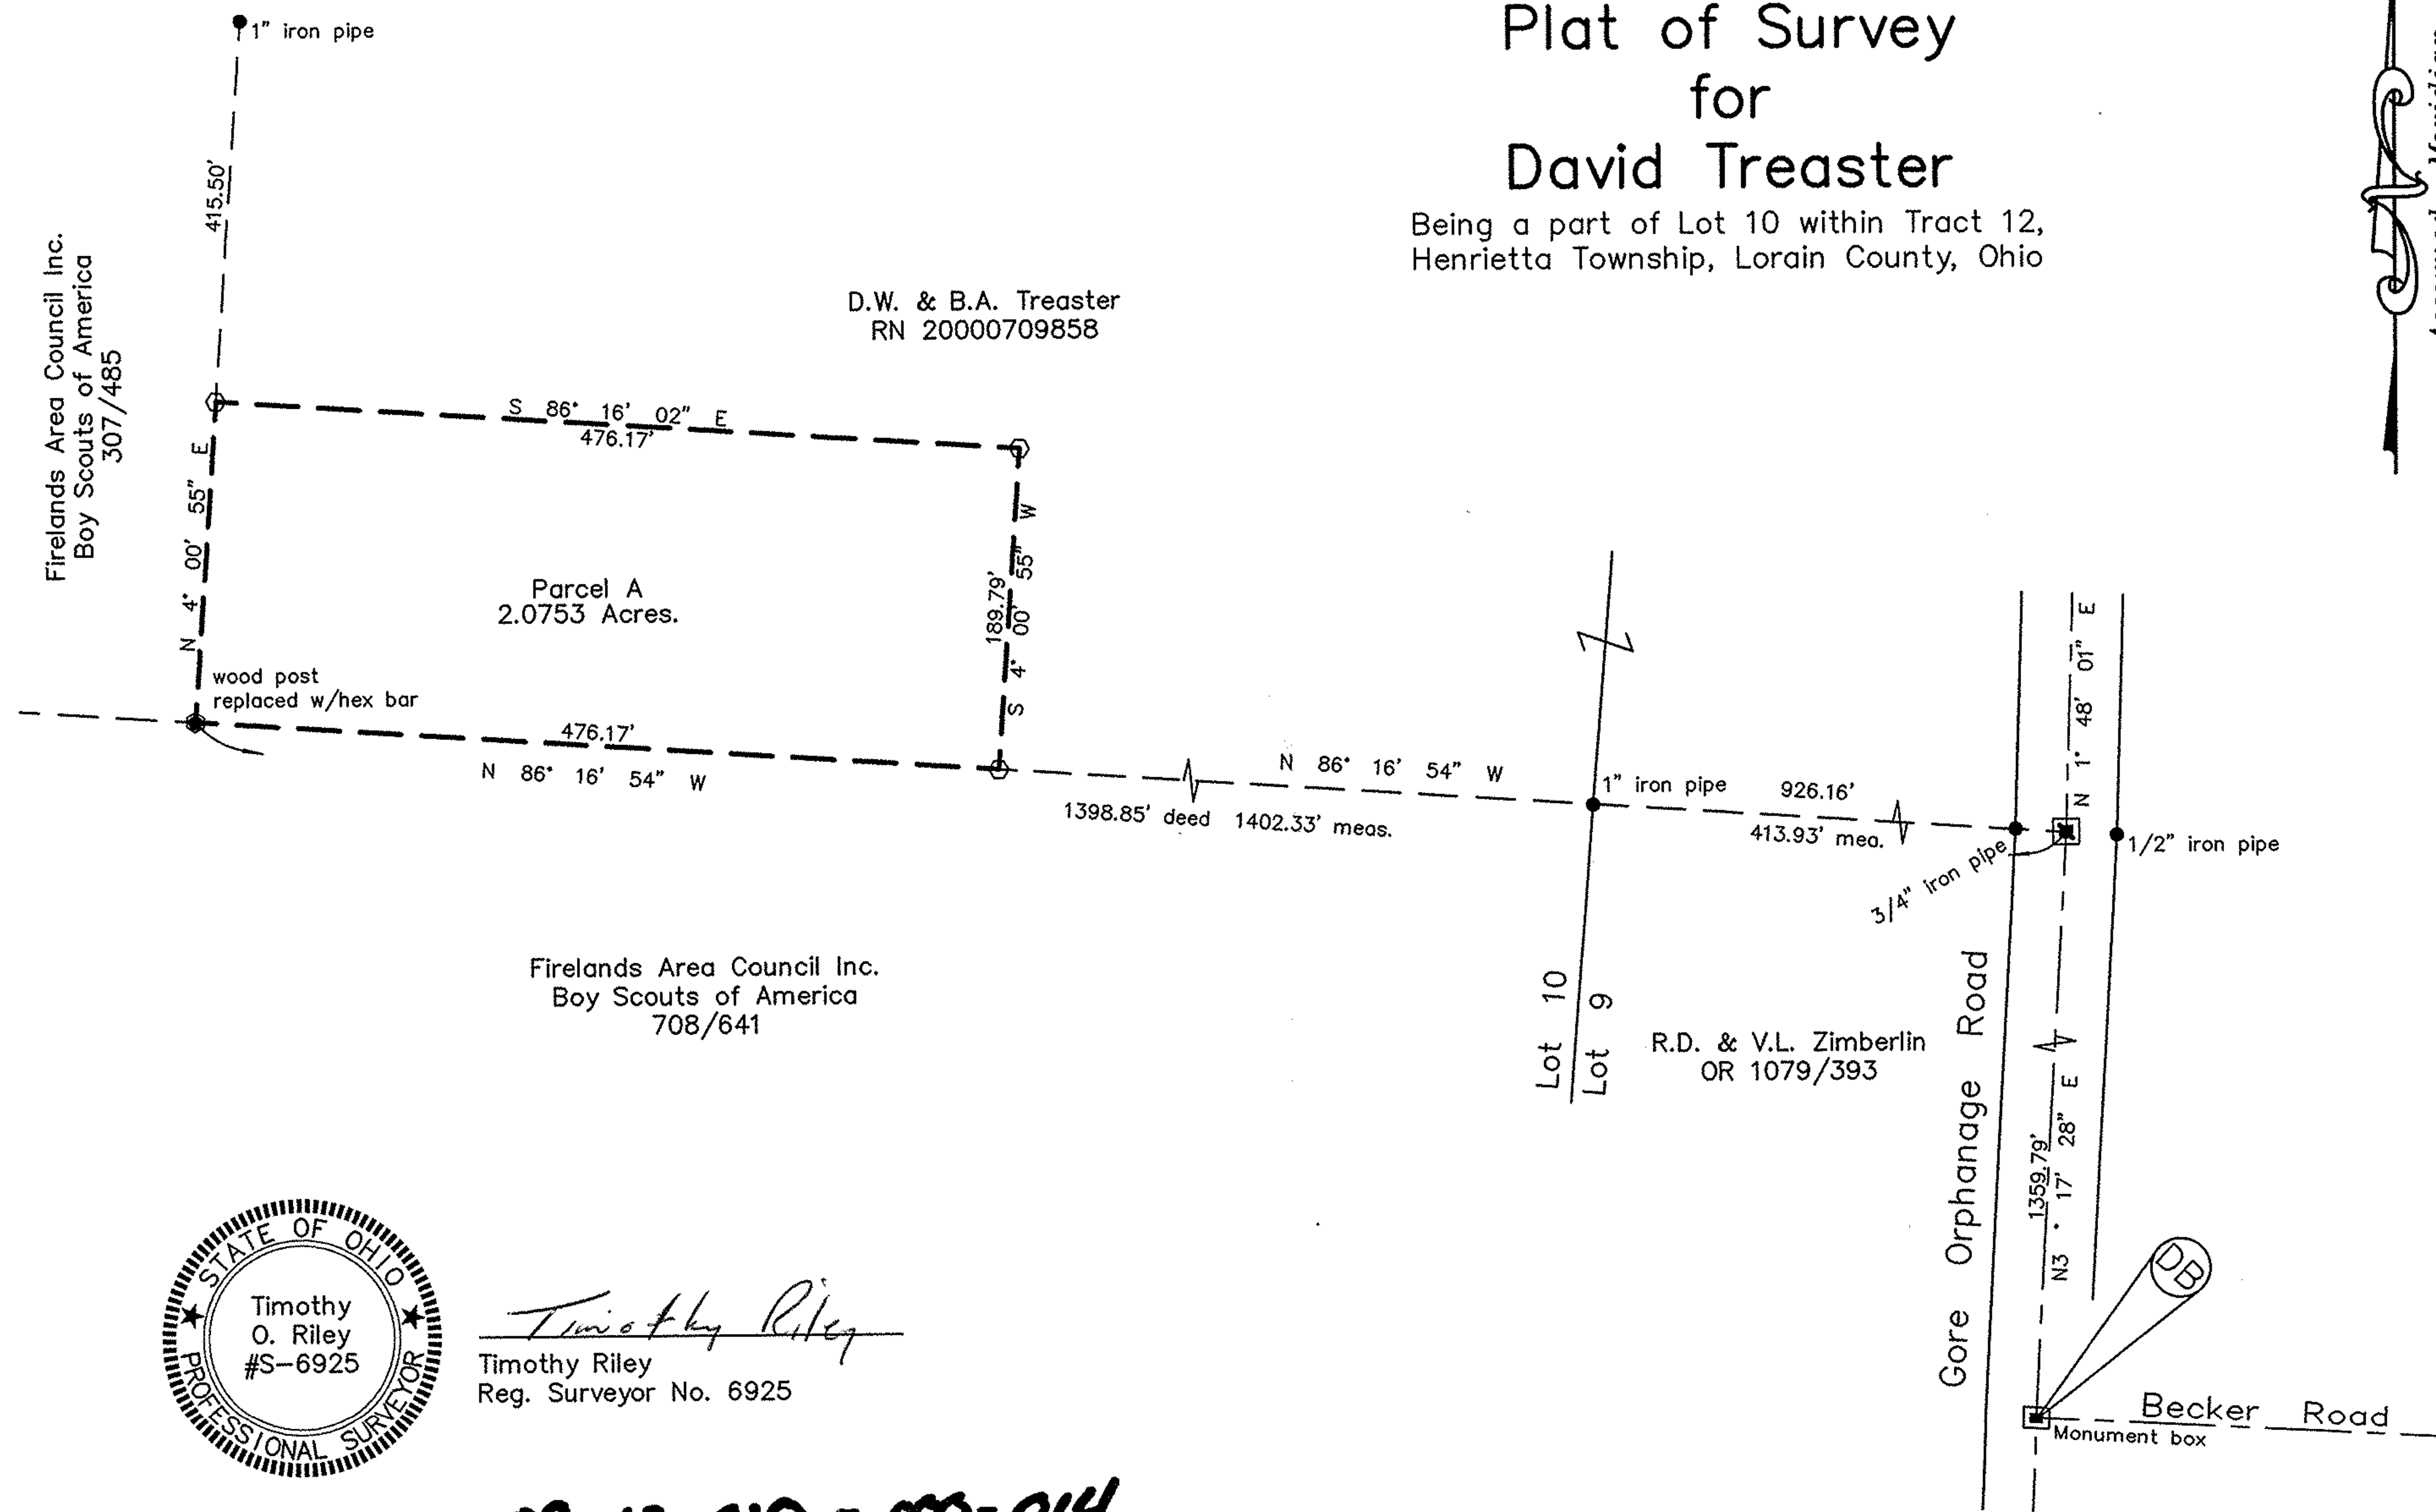

Firelands Area Council Inc.  
Boy Scouts of America  
307/485

Parcel A  
2.0753 Acres.


Firelands Area Council Inc.  
Boy Scouts of America  
708/641

Lot 10  
Lot 9

R.D. & V.L. Zimmerlin  
OR 1079/393

Gore Orphanage Road

Becker Road  
Monument box

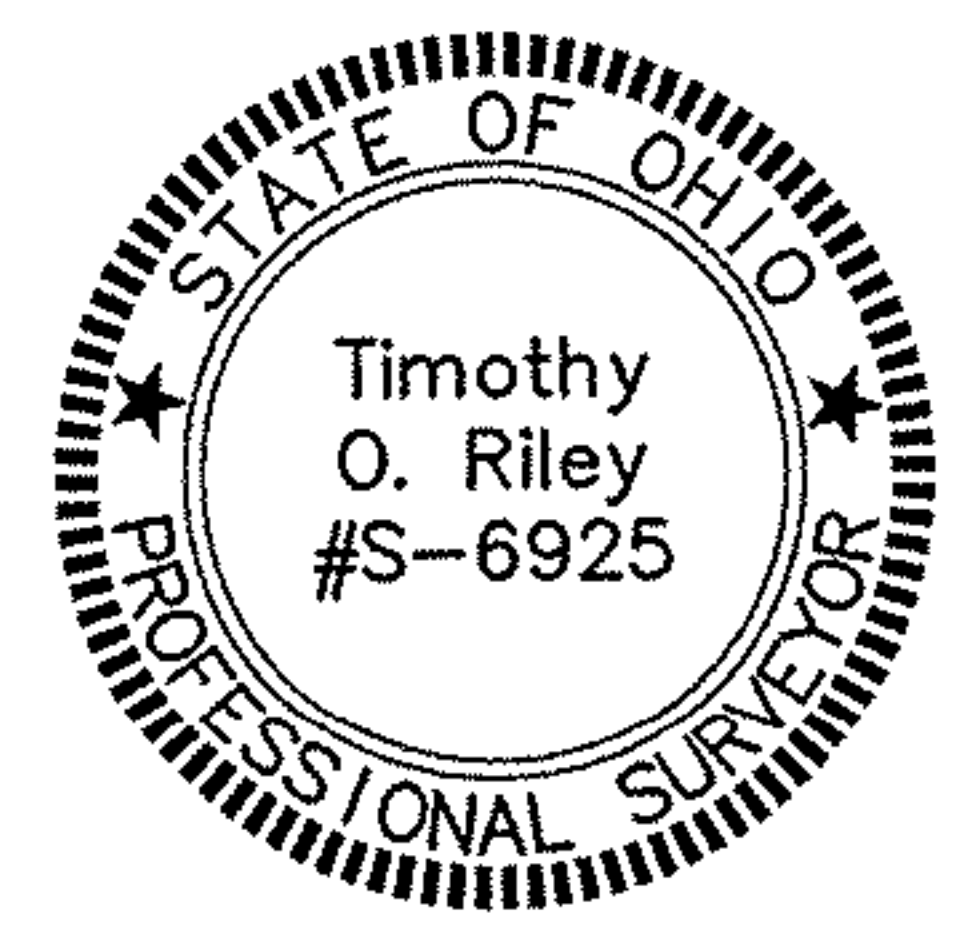

*Timothy Riley*  
Timothy Riley  
Reg. Surveyor No. 6925

08-12-010 - 000-014

9/16" Hex Bar Set ○ Nail Set  
● Monument Found

Inch Scale E/C 1:10000

**Timothy Riley**  
ENGINEER - SURVEYOR  
*Norwalk, Ohio*

Date: 3-17-2001	Dwn By: CAD
Scale: 1" = 100'	Ckd By: TOR
Tract 12, Lot 10, Henrietta Twp.	
Job No. 32,006 A Gore Orphanage Rd	