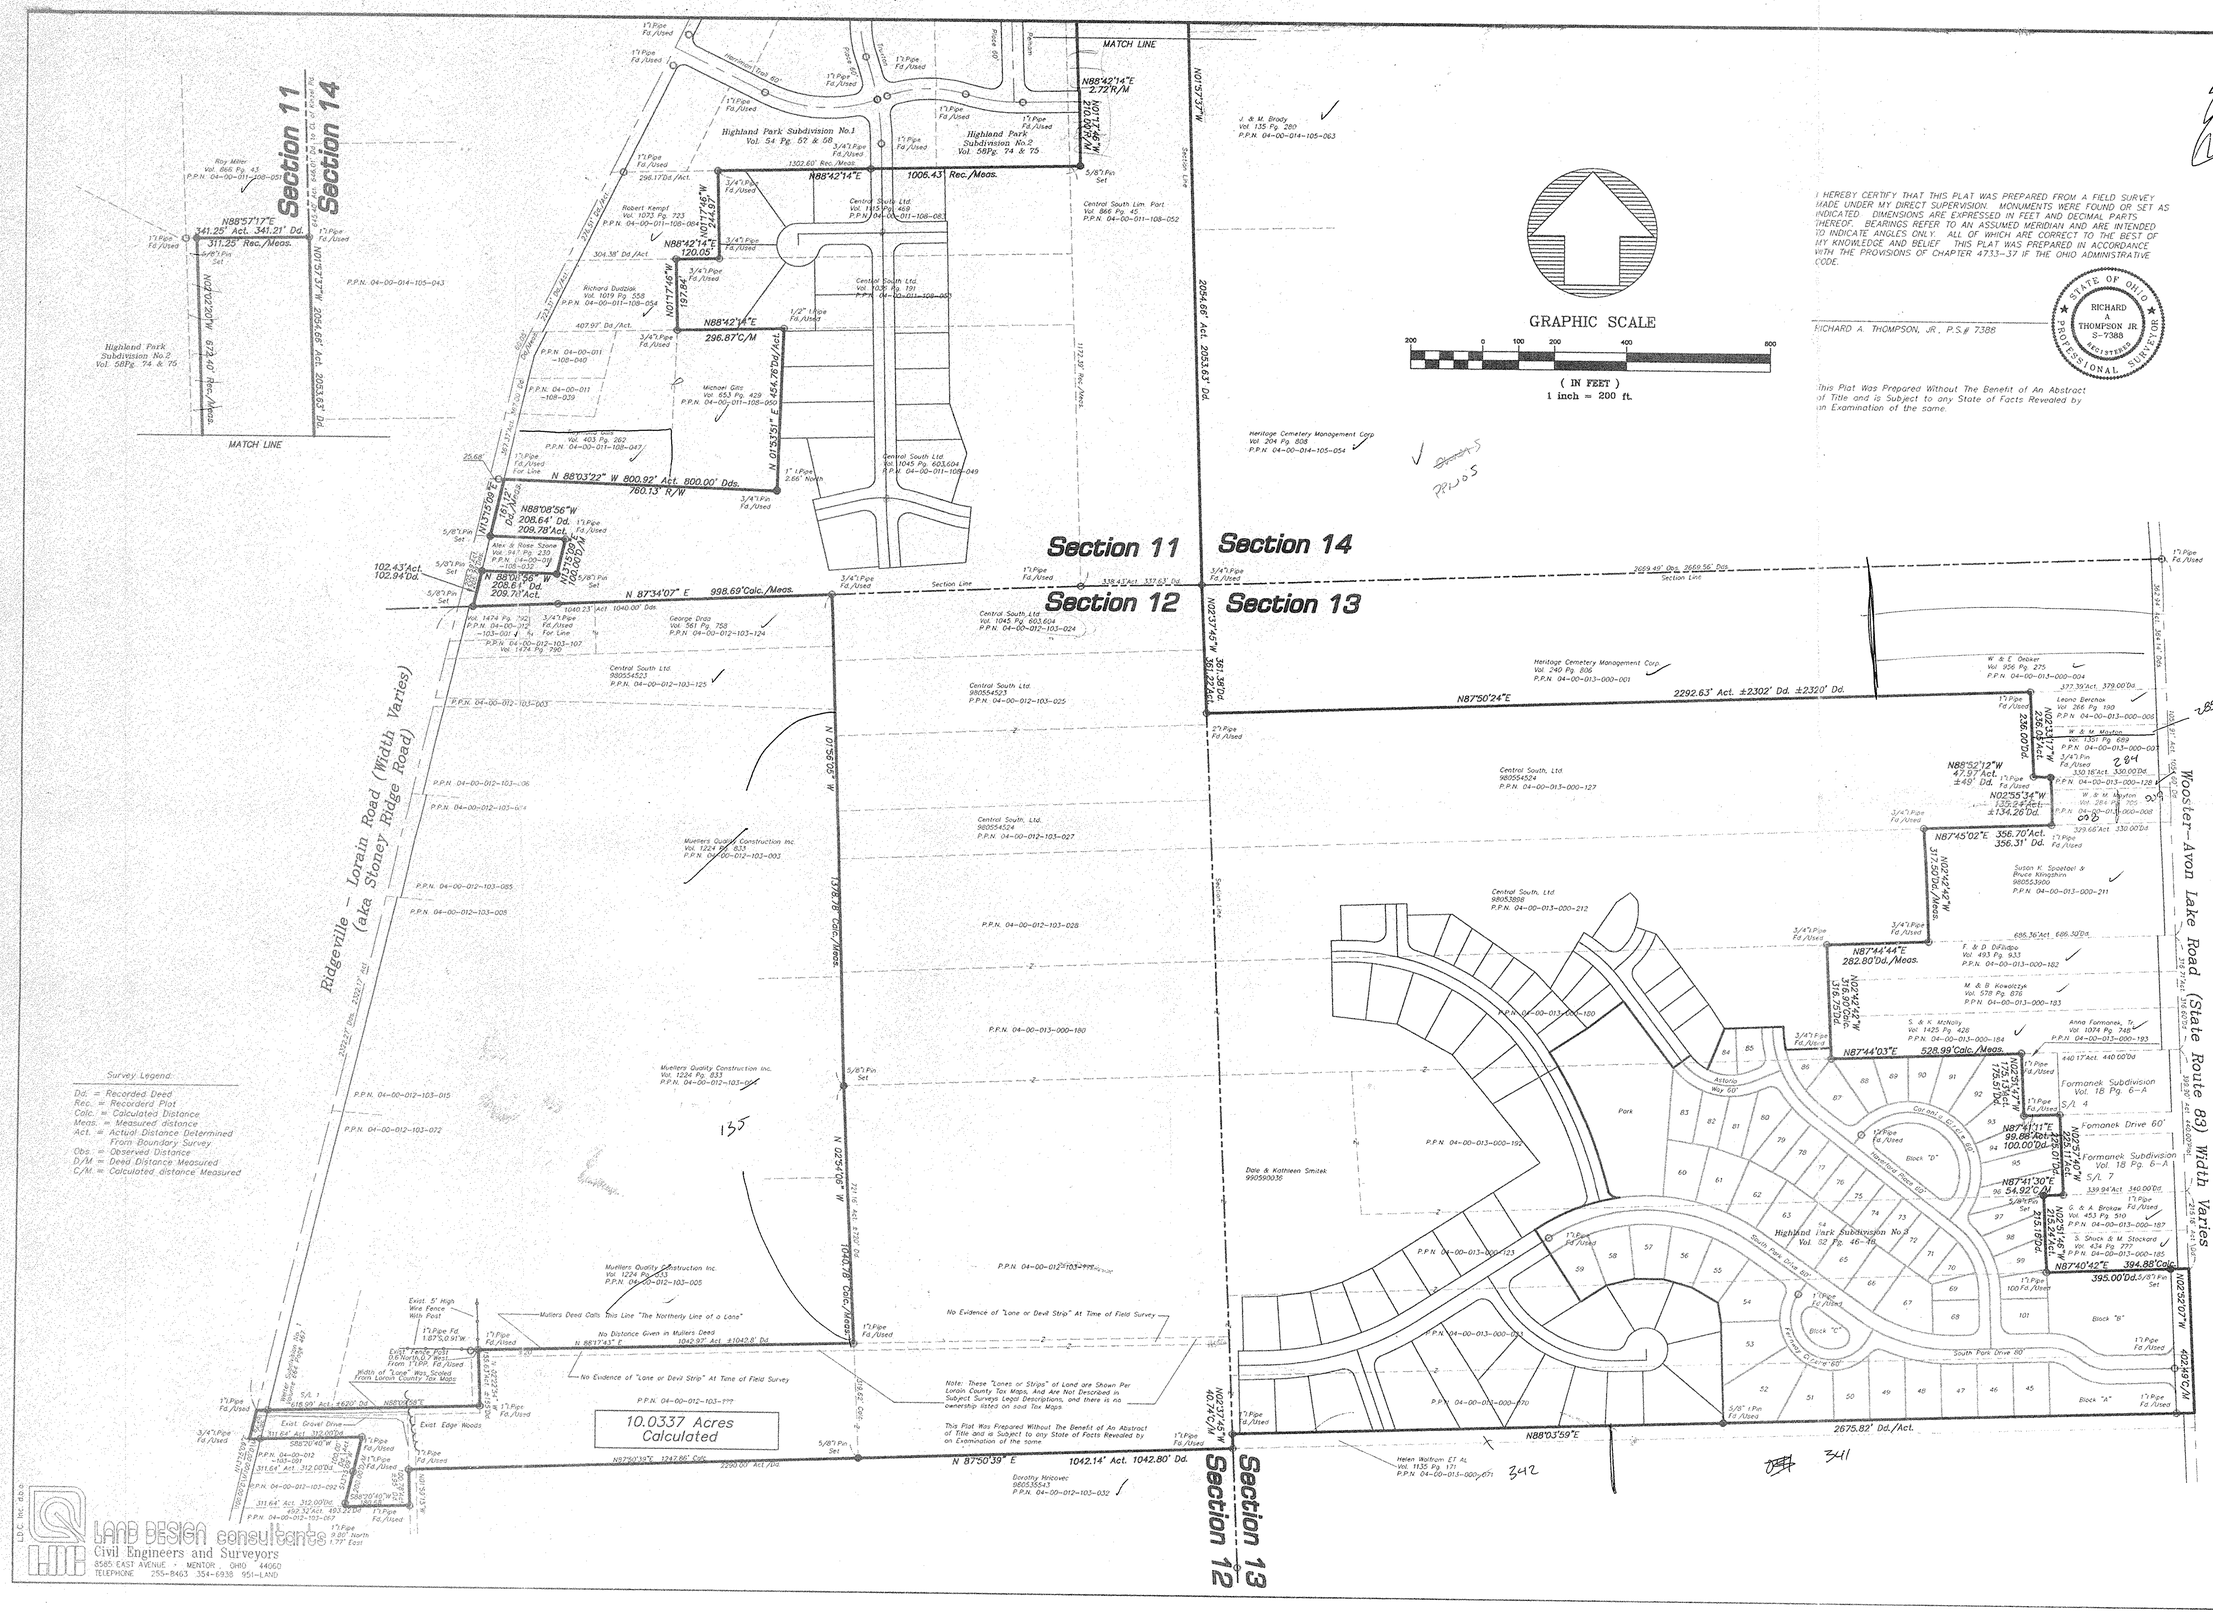
Section 11
Section 14
Section 12
Section 13
MATCH LINE
Highland Park Subdivision No.1
Vol. 54 Pg. 57 & 58
Highland Park Subdivision No.2
Vol. 58Pg. 74 & 75
N88°42'14"E 1006.43' Rec./Meas.
N88°42'14"E 2.72'R/M
N88°42'14"E 120.05'
N88°42'14"E 296.87'C/M
N 88°03'22" W 800.92' Act. 800.00' Dds.
760.13' R/W
N88°08'56"W 208.64' Dd. 209.70' Act.
N 88°08'56" W 208.64' Dd. 209.71' Act.
N 87°34'07" E 998.69' Calc./Meas.
N87°50'24"E 2292.63' Act. ±2302' Dd. ±2320' Dd.
N87°45'02"E 356.70' Act. 356.31' Dd.
N87°44'44"E 282.80' Dd./Meas.
N87°44'03"E 528.99' Calc./Meas.
N87°41'30"E 54.92' C/M
N87°40'42"E 394.88' Calc.
N88°03'59"E 2675.82' Dd./Act.
N 87°50'39" E 1042.14' Act. 1042.80' Dd.
N 01°53'51" E 454.78' Dd./Act.
N 02°37'05" W 1040.00' Dds.
