04-00-003-103-031,032
#21789 Pg. 4-00-003-H

SPLIT SURVEY
FOR
TIM A. HOLOWECKY
OF
PART OF SECTION 3
CITY OF AVON
COUNTY OF LORAIN
STATE OF OHIO
JANUARY 1996
SCALE 1" = 50'
REVISED APRIL, 1996

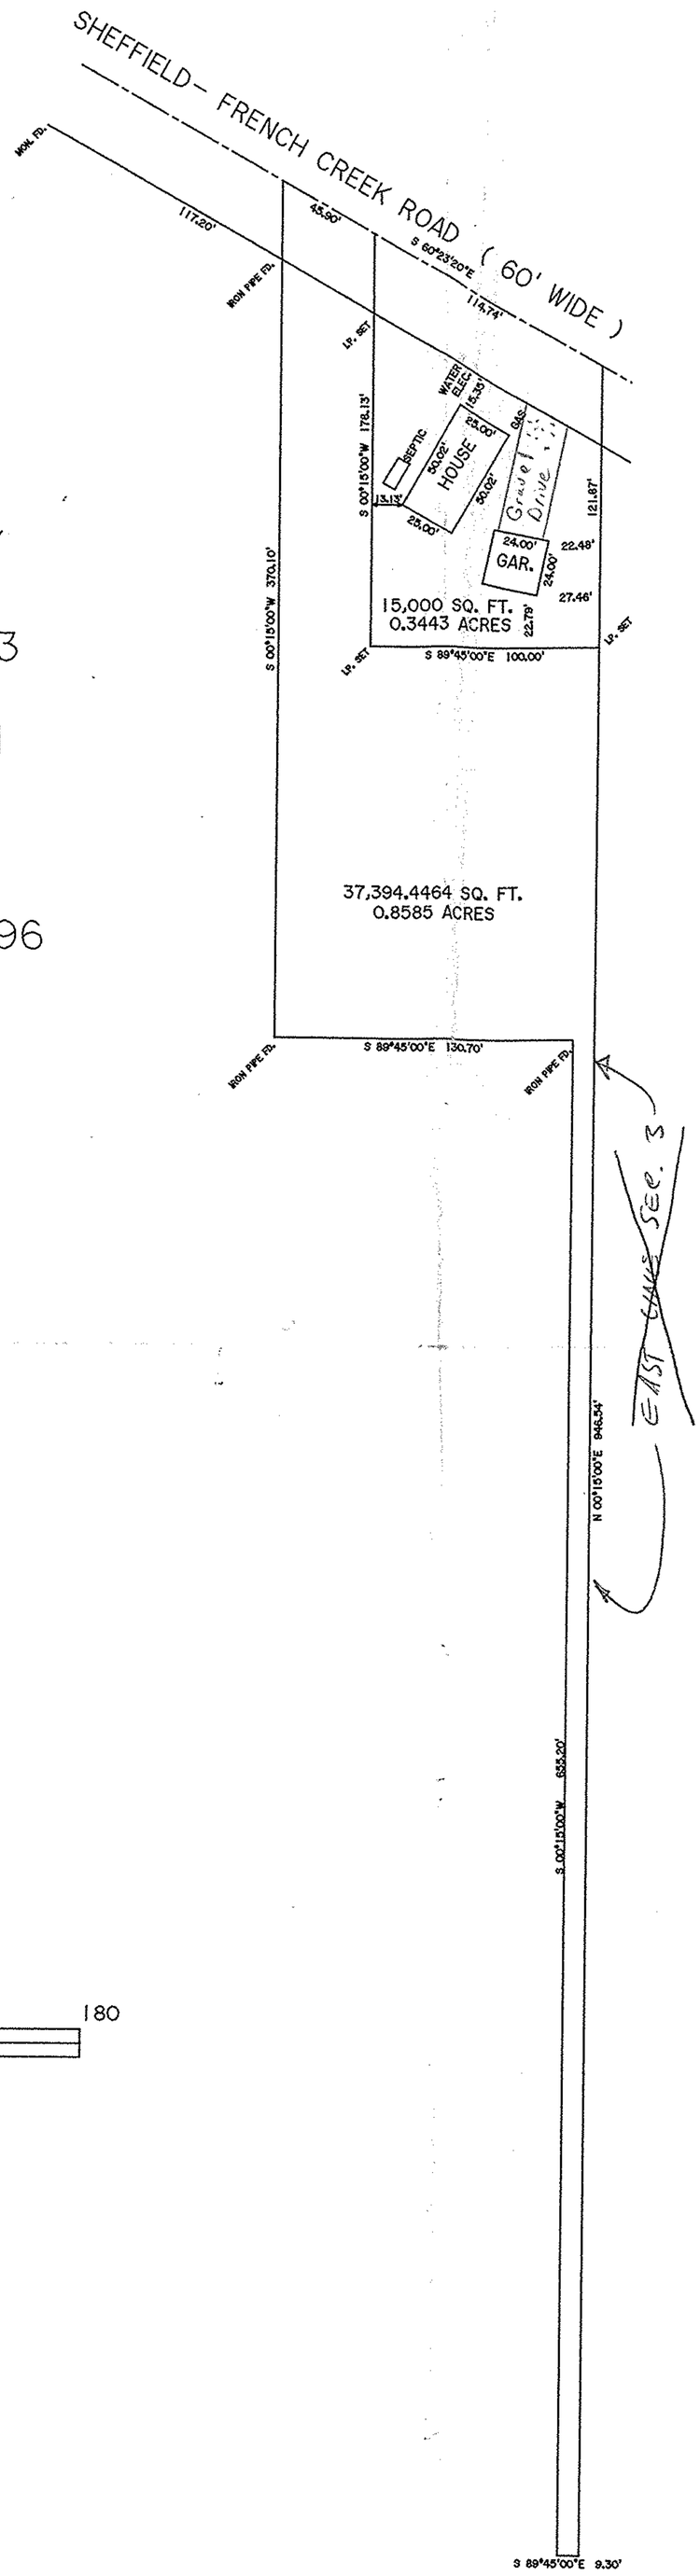

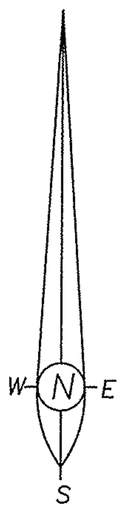

60 0 60 120 180

GRAPHIC SCALE - FEET

RALPH W. GROMLEY R.S. NO. 7431

#21789

APPROVED
LORAIN CO.
MAP DEPT

DATE 6-5-96

PAGE 4-00-003 H

BY CAROLYN FRANCIS

#21789

		DATE
	AVON	NO.
		BY

PLAT PREPARED BY
DE - BEL SURVEYORS
35650 LAKELAND BOULEVARD
EASTLAKE, OHIO
216 953 1338