# SURVEY
OF PART OF
## LAGRANGE TWP. LOT No. 40
TWP. OF LAGRANGE COUNTY OF LORAIN
STATE OF OHIO

PREPARED FOR:
ESTABROOK ASSEMBLY SERVICES INC.
700 W. BAGLEY RD.
P.O. BOX 304
BEREA, OHIO
AND
BRIAN GEVRY
8053 LEXINGTON WAY
N. RIDGEVILLE, OH

PREPARED BY:
HAPONEK & ASSOC. INC.
SURVEYORS
N. RIDGEVILLE, OHIO

STATE OF OHIO
DANE A. HAPONEK
S-6211
REGISTERED SURVEYOR

15-00-040-000-0137 018

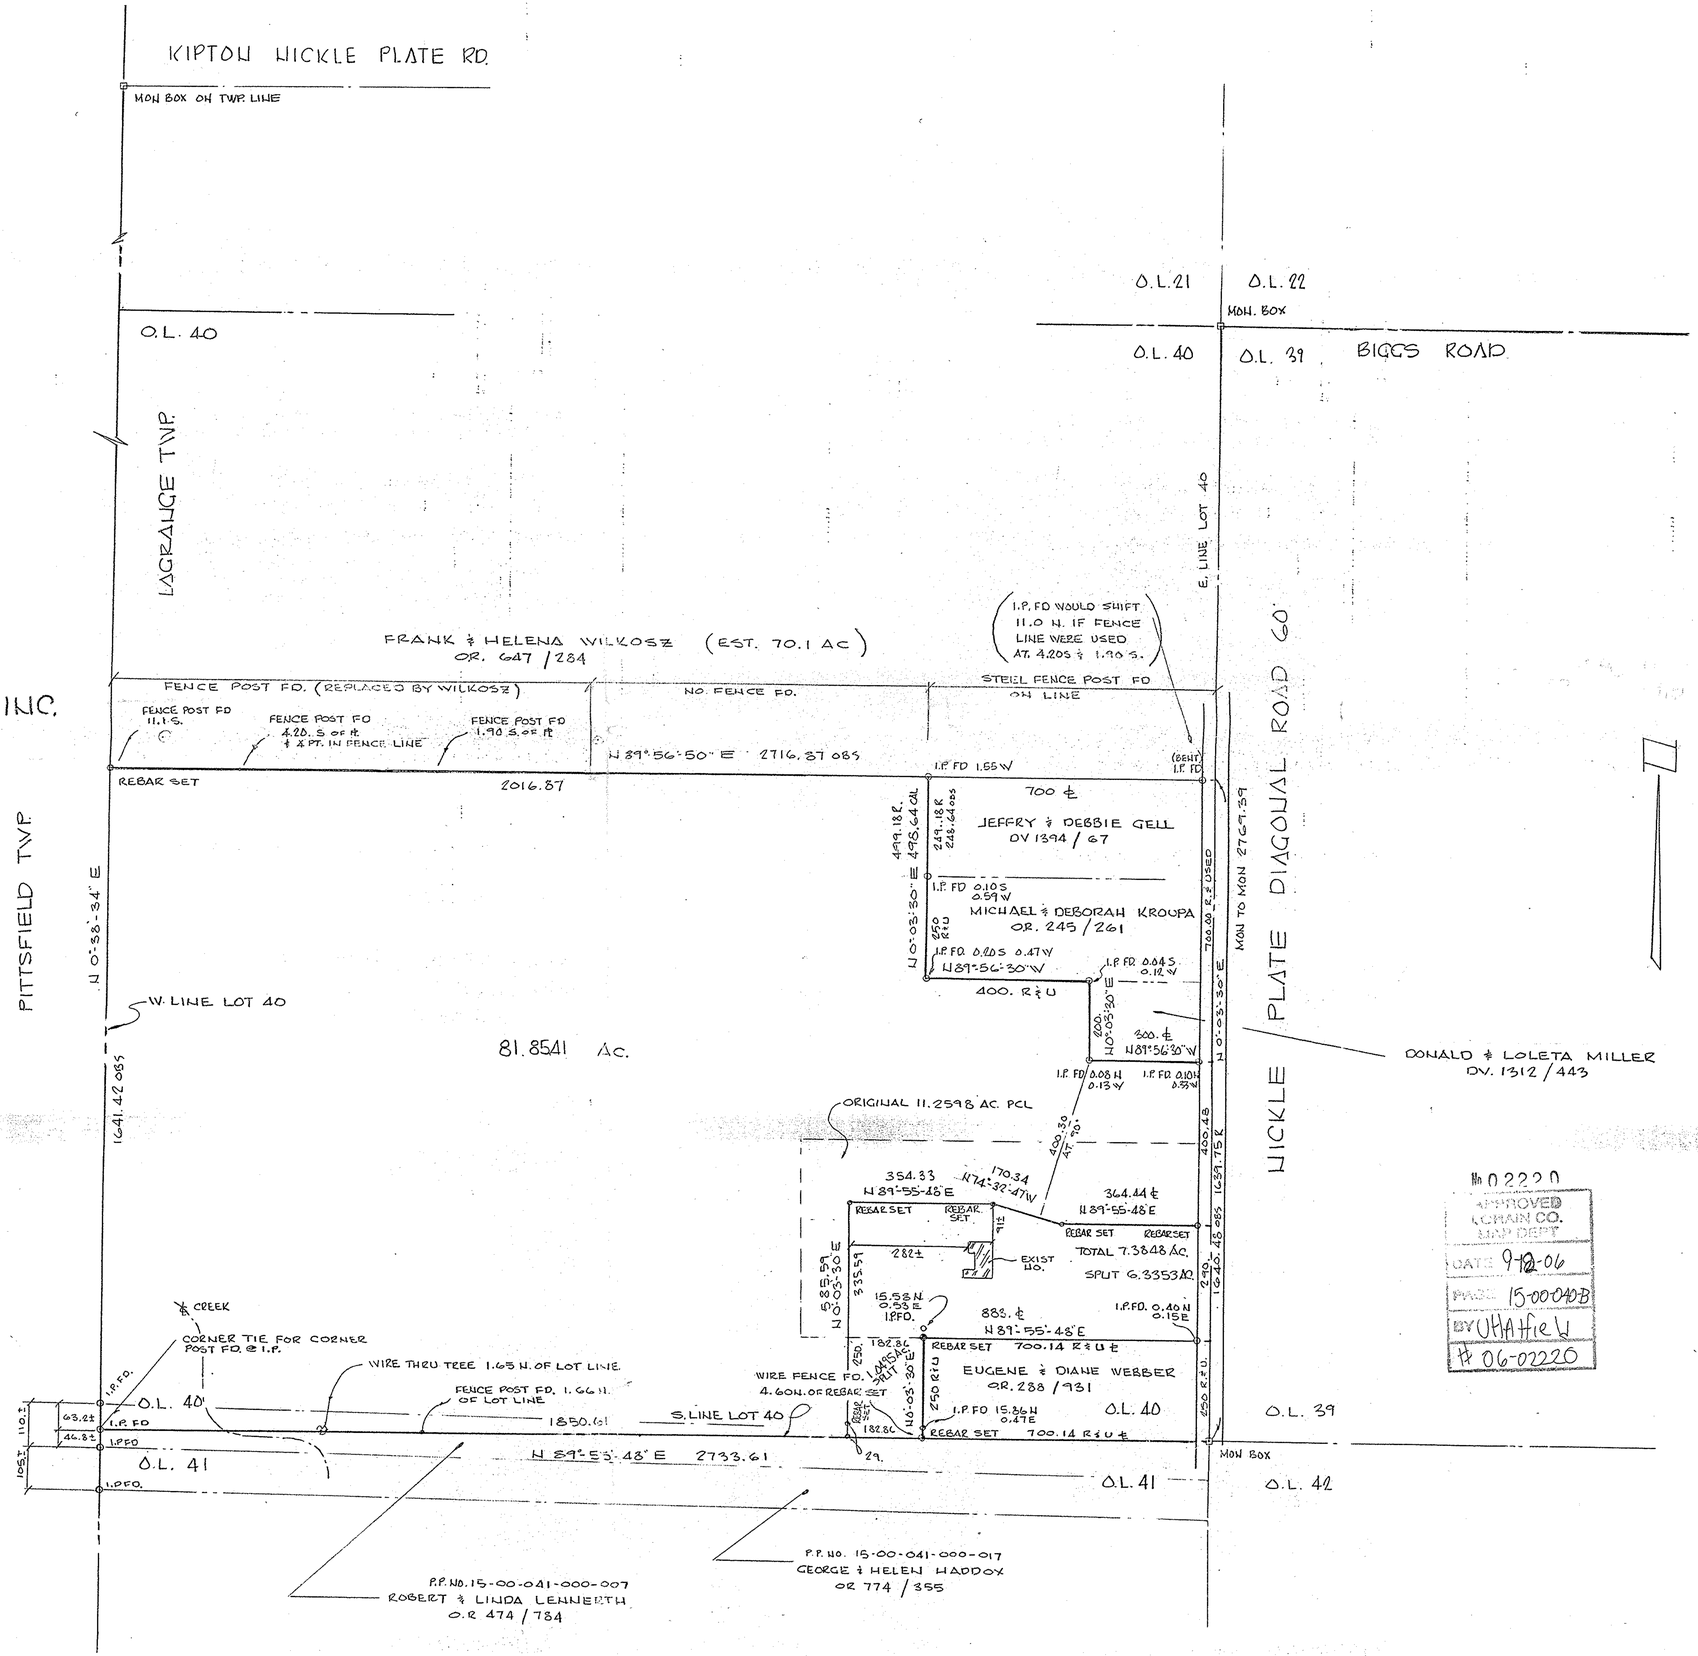


DATE : JAN. 1998
SCALE: 1" = 200'

No 02220
APPROVED
LORAIN CO.
MAP DEPT
DATE 9-12-06
PARCEL 15-00040B
BY UHAfield
# 06-02220