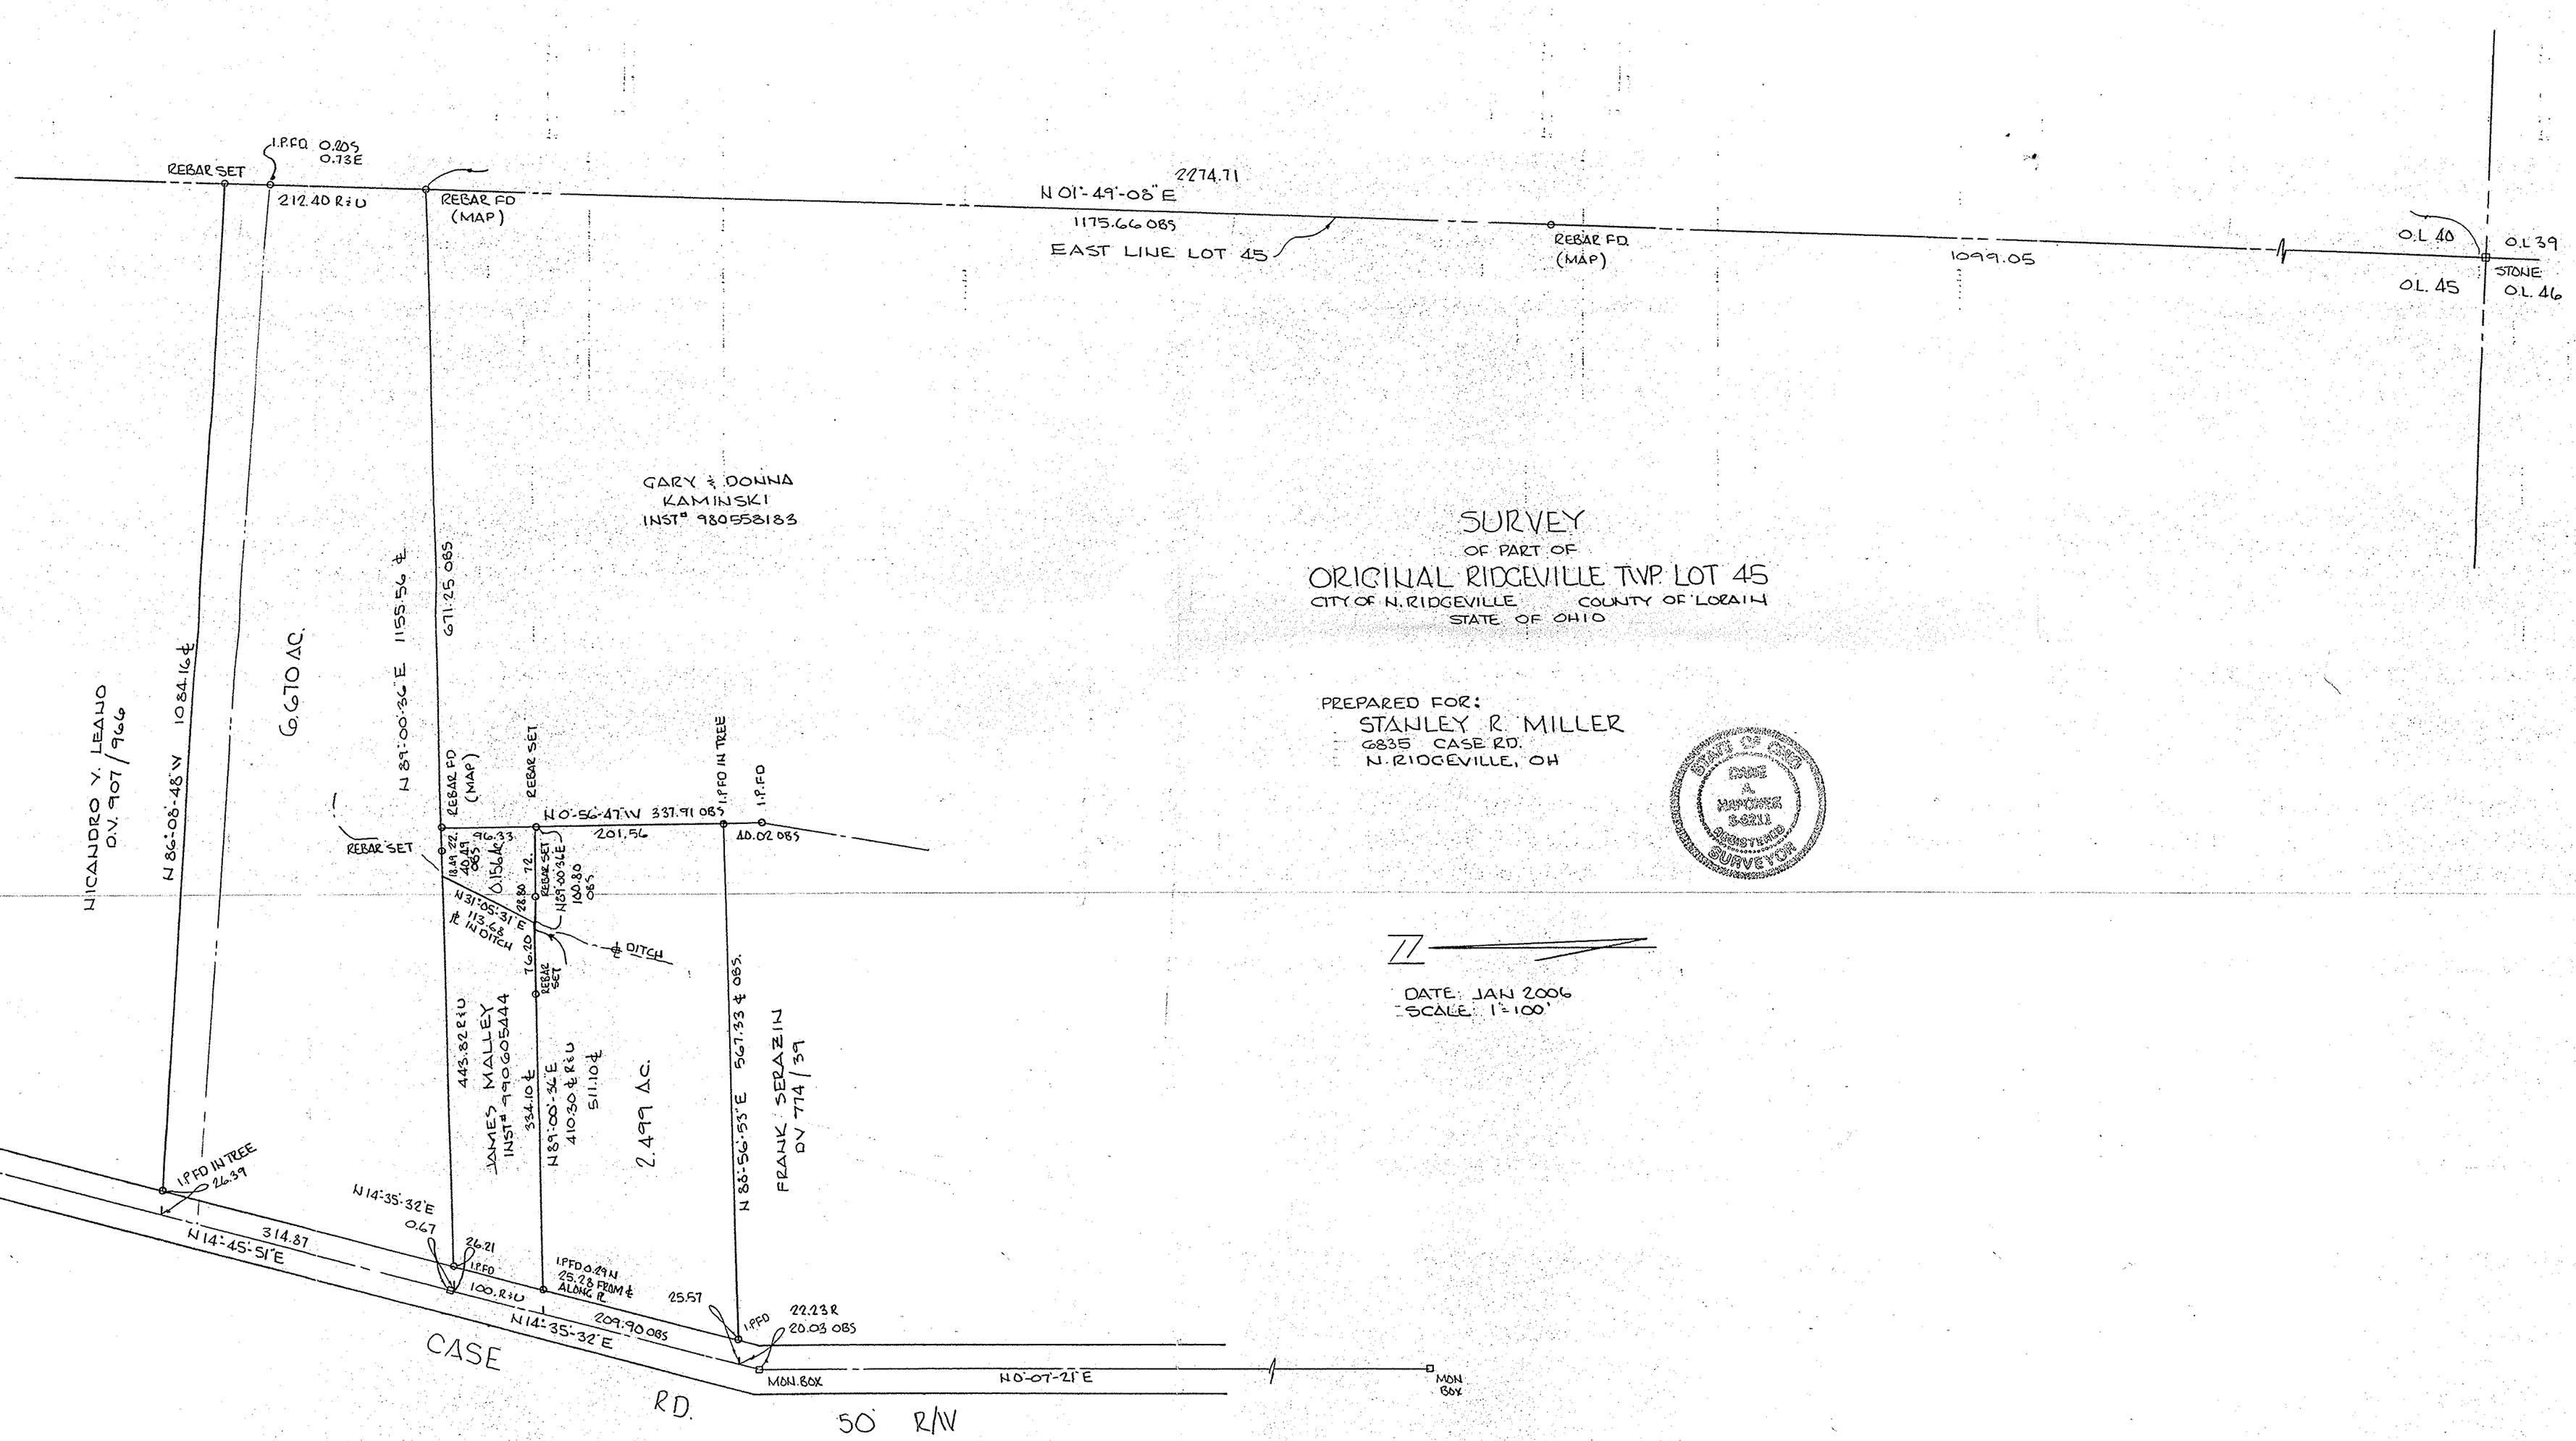

SURVEY
OF PART OF
ORIGINAL RIDGEVILLE TWP LOT 45
CITY OF N. RIDGEVILLE COUNTY OF LORAIN
STATE OF OHIO

PREPARED FOR:
STANLEY R. MILLER
6835 CASE RD.
N. RIDGEVILLE, OH

DATE: JAN 2006
SCALE: 1"=100'

No 02218
DATE 9-15-06
PROJ. 7-00065D
BY JHH/KeW
H 06-02218

STATE OF OHIO
JAMES
A
HAYCOCK
6-6213
REGISTERED
SURVEYOR