04-00-017_102-212, 213 214

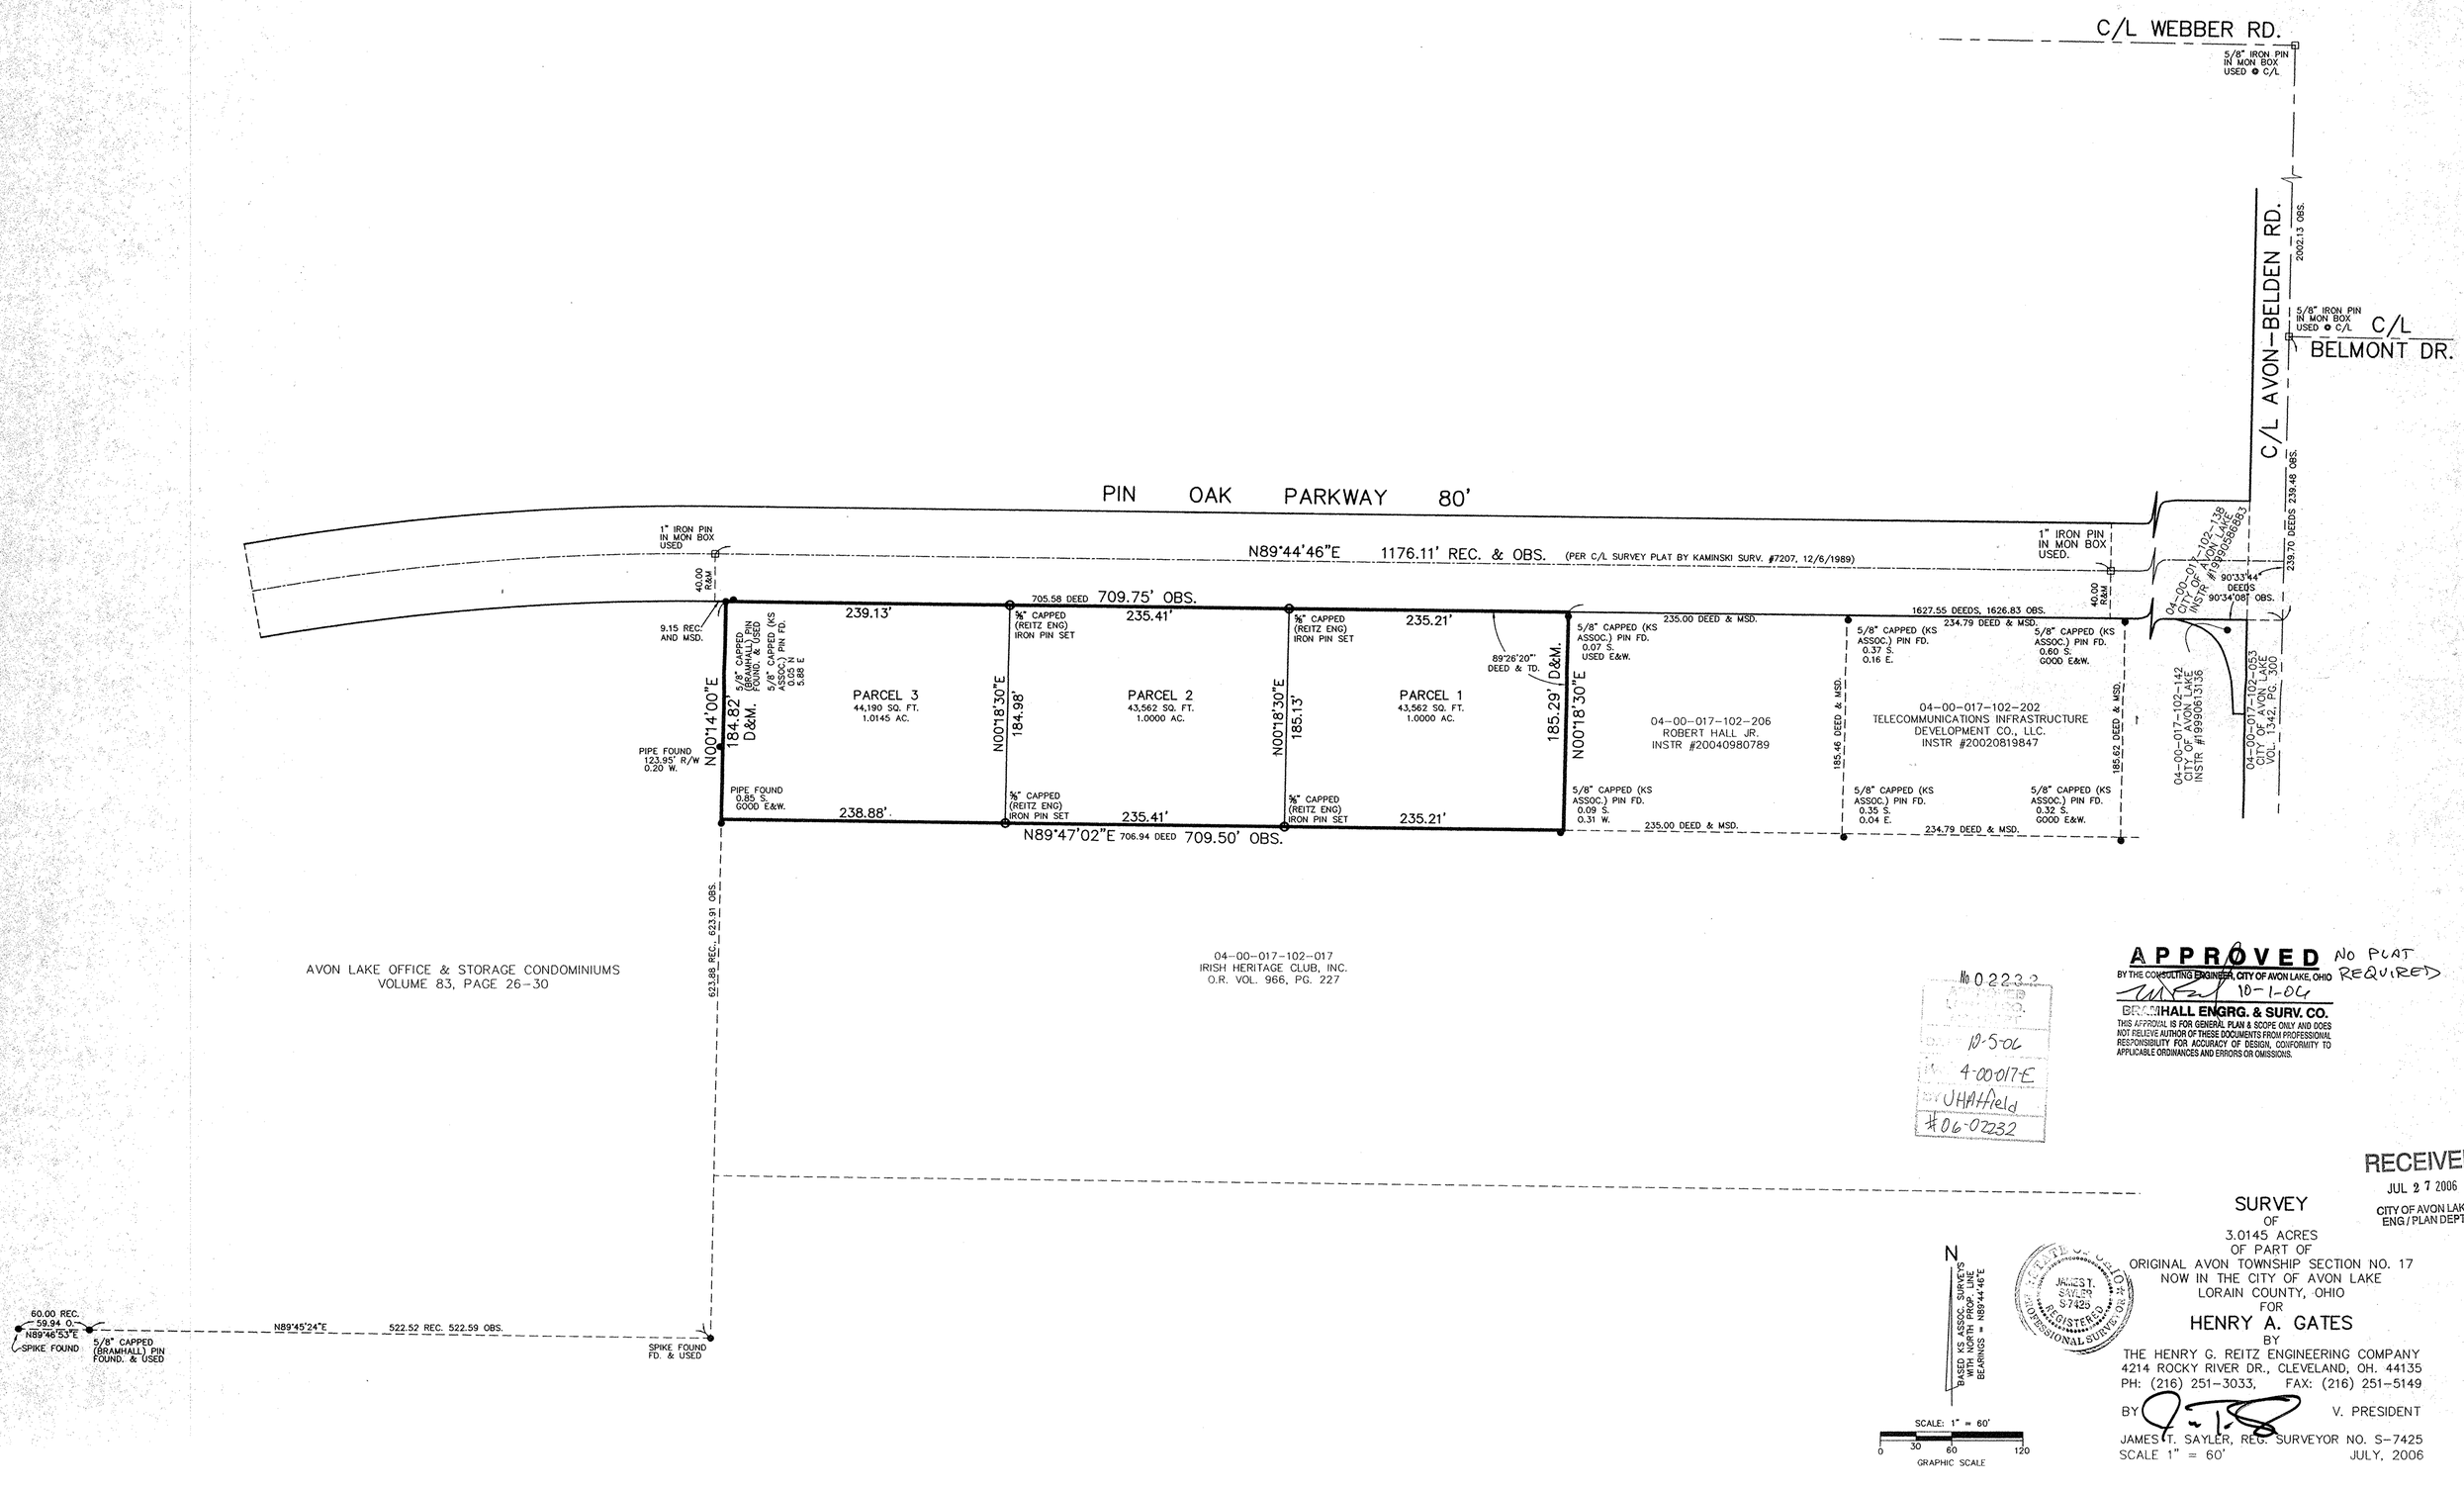


**APPROVED** NO PLAT REQUIRED
BY THE CONSULTING ENGINEER, CITY OF AVON LAKE, OHIO
10-1-06
BRAMHALL ENGRG. & SURV. CO.
THIS APPROVAL IS FOR GENERAL PLAN & SCOPE ONLY AND DOES NOT RELIEVE AUTHOR OF THESE DOCUMENTS FROM PROFESSIONAL RESPONSIBILITY FOR ACCURACY OF DESIGN, CONFORMITY TO APPLICABLE ORDINANCES AND ERRORS OR OMISSIONS.

No 02232
10-5-06
4-00017-E
UHatfield
#06-02232

RECEIVED
JUL 27 2006
CITY OF AVON LAKE ENG/PLAN DEPT.

# SURVEY

OF
3.0145 ACRES
OF PART OF
ORIGINAL AVON TOWNSHIP SECTION NO. 17
NOW IN THE CITY OF AVON LAKE
LORAIN COUNTY, OHIO
FOR
HENRY A. GATES

BY
THE HENRY G. REITZ ENGINEERING COMPANY
4214 ROCKY RIVER DR., CLEVELAND, OH. 44135
PH: (216) 251-3033, FAX: (216) 251-5149

BY V. PRESIDENT

JAMES T. SAYLER, REG. SURVEYOR NO. S-7425
SCALE 1" = 60' JULY, 2006