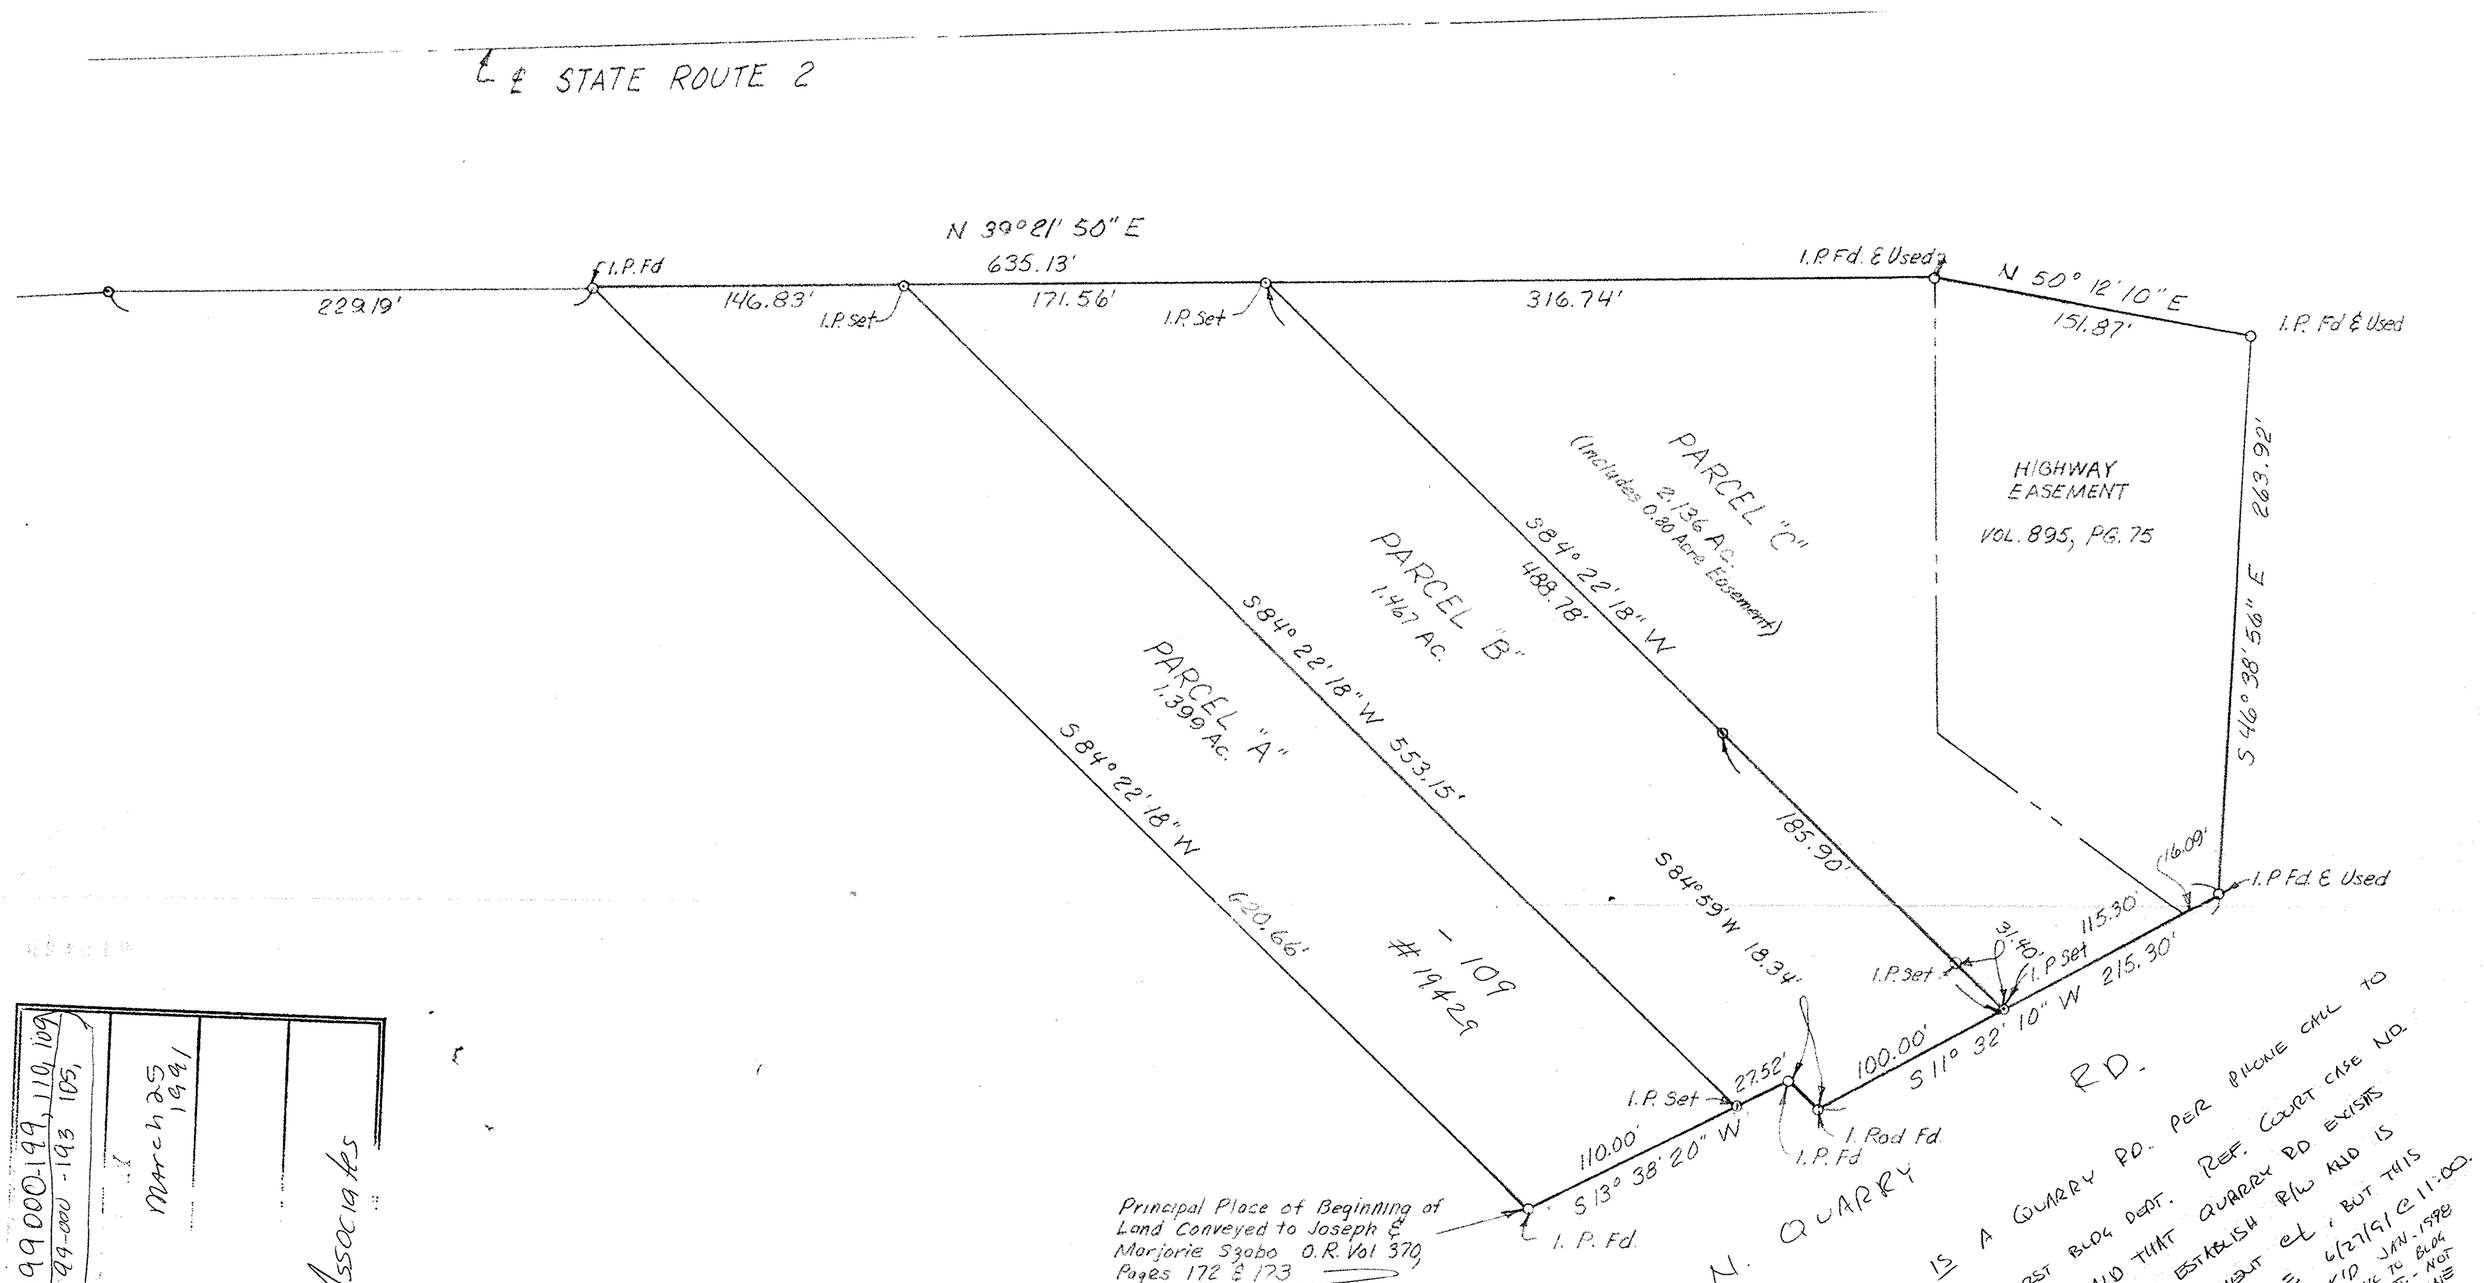

NO QUARRY RD REFERENCE.

ALSO DV 1358/687 - NO ROAD REFERENCE

YES, THERE IS A QUARRY RD. PER PHONE CALL TO K. KLINGSHIRN AMHERST BLDG DEPT. REF. COURT CASE NO. 98061-87 SAID THAT QUARRY RD EXISTS BUT THAT CITY MUST ESTABLISH R/W AND IS TO ESTABLISH & MONUMENT ℄, BUT THIS HAS NOT YET BEEN DONE 6/27/91 @ 11:00. EKD

w/ CALL TO BLDG DEPT. NOT YET DONE JAN. 1998

#19429

APPROVED LORAIN CO. MAP DEPT.	
DATE 6-18-91	
PAGE 5-00 099-C	
BY C.E. FRANCIS	
VOID AFTER	19429

P.P. NO. 05-00 099 000-199, 110, 109
OID (05-00-099-000-193 105,
SPLIT # 19429
MAP PAGE 05-00-099-C
SURVEYOR McGlinchy + Associates
March 25 1991

AMHERST CITY BLDG. DEPT.
RON KONOWAL ENGINEER
988-3734

TOM NOTIFIED KONOWAL & LEFT MESSAGE FOR HIM TO INVESTIGATE & GET BACK TO US
1-5-98 @ 9:30
PETER SEGNARD

TOM CALLED 2/23/98 @ 3:45 AND ASKED TO HAVE THE ENG. CALL ME TO FIND OUT ABOUT N. QUARRY RD ℄ FROM CONRAIL TRACKS NORTH TO I-90 SEE COURT CASE AS NOTED.

MAP of PROPOSED PARCEL SPLIT

PREPARED FOR JOSEPH & MARJORIE SZABO

PART of ORIGINAL AMHERST TWP. LOT No. 99
CITY of AMHERST, LORAIN COUNTY, OHIO

PART OF P.P. No. (07) 05-00-099-000-105

McGLINCHY AND ASSOCIATES
PROFESSIONAL ENGINEERS AND SURVEYORS
625 North Woodhill Drive Amherst, Ohio

SCALE: 1" = 50' DRAWN BY: LVM
DATE: 3/25/91 JOB NO: 918811