P.P. NO.
03-00-074-101-001
SPLIT NOV 2006
07-01449
MAP NO.
3-00-073 A
SURVEYOR
Simon + Associates

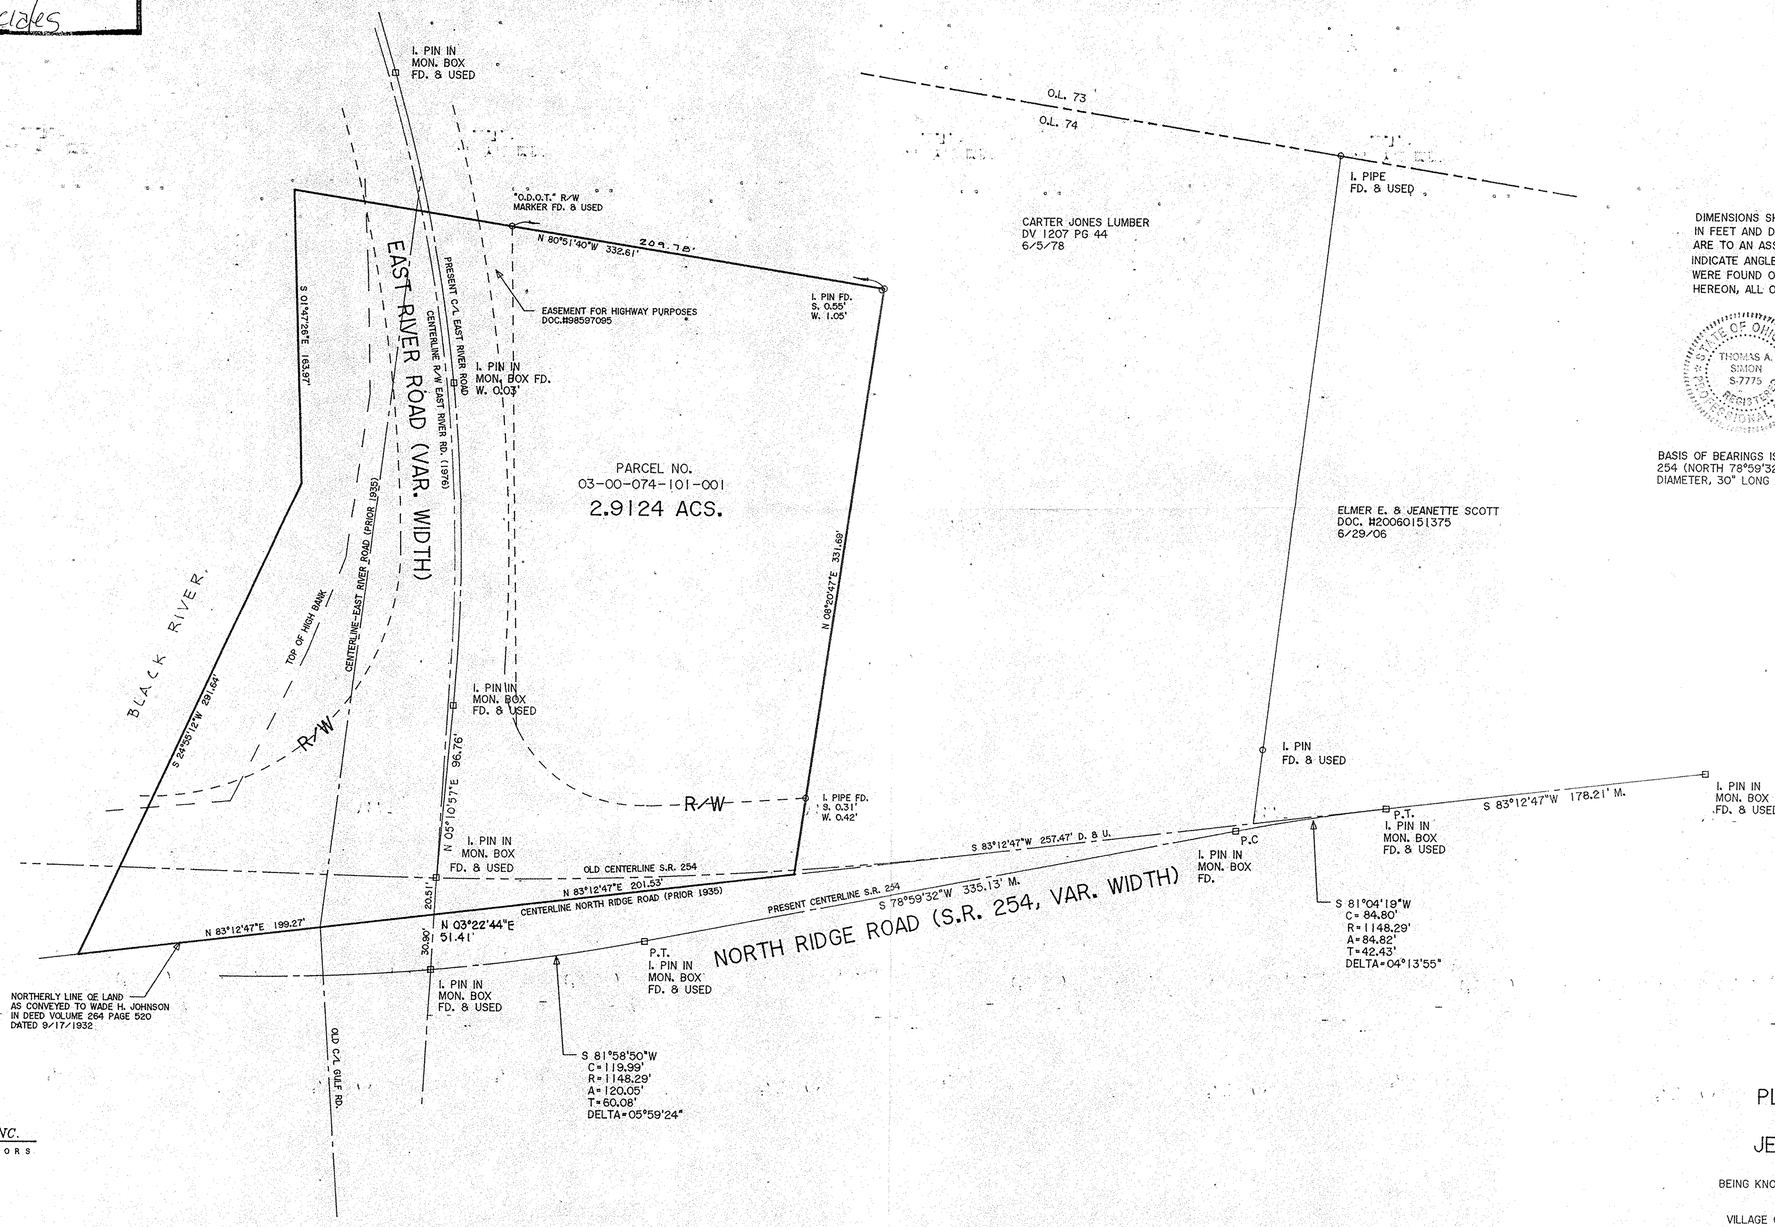

DIMENSIONS SHOWN ON THIS PLAT ARE EXPRESSED IN FEET AND DECIMAL PARTS THEREOF, ALL BEARINGS ARE TO AN ASSUMED MERIDIAN AND ARE USED TO INDICATE ANGLES ONLY. PERMANENT MONUMENTS WERE FOUND OR SET AT ALL POINTS INDICATED HEREON, ALL OF WHICH I CERTIFY TO BE CORRECT.

STATE OF OHIO THOMAS A. SIMON S-7775 REGISTERED PROFESSIONAL SURVEYOR

THOMAS A. SIMON
REG. PROFESSIONAL SURVEYOR
NO. S-7775

BASIS OF BEARINGS IS THE CENTERLINE OF STATE ROUTE 254 (NORTH 78°59'32"EAST). IRON PINS SET ARE 5/8" DIAMETER, 30" LONG WITH PLASTIC CAPS "T. SIMON, S-7775".

#07-01449-A
APPROVED
LORAIN CO.
2/8/07
3-00-073-A
D. HOLLAND
#07-01449-A

PLAT OF SURVEY
FOR
JEAN DRUMCHEFF

BEING KNOWN AS PART OF ORIGINAL SHEFFEILD TOWNSHIP LOT NO. 74

VILLAGE OF SHEFFIELD COUNTY OF LORAIN
STATE OF OHIO

NOVEMBER, 2006 SCALE: 1" = 40'

THOMAS SIMON & ASSOCIATES, INC.
PROFESSIONAL LAND SURVEYORS

150 SOUTH OLIVE STREET
ELYRIA, OHIO 44035

(440) 327-2925
FAX 327-2964

JOB NO. 2006-066