BOUNDARY SURVEY

for

THE CITY OF AVON

SITUATED IN THE CITY OF AVON, COUNTY OF LORAIN, STATE OF OHIO AND KNOWN AS BEING PART OF ORIGINAL AVON TOWNSHIP SECTION NUMBERS 03 & 04.

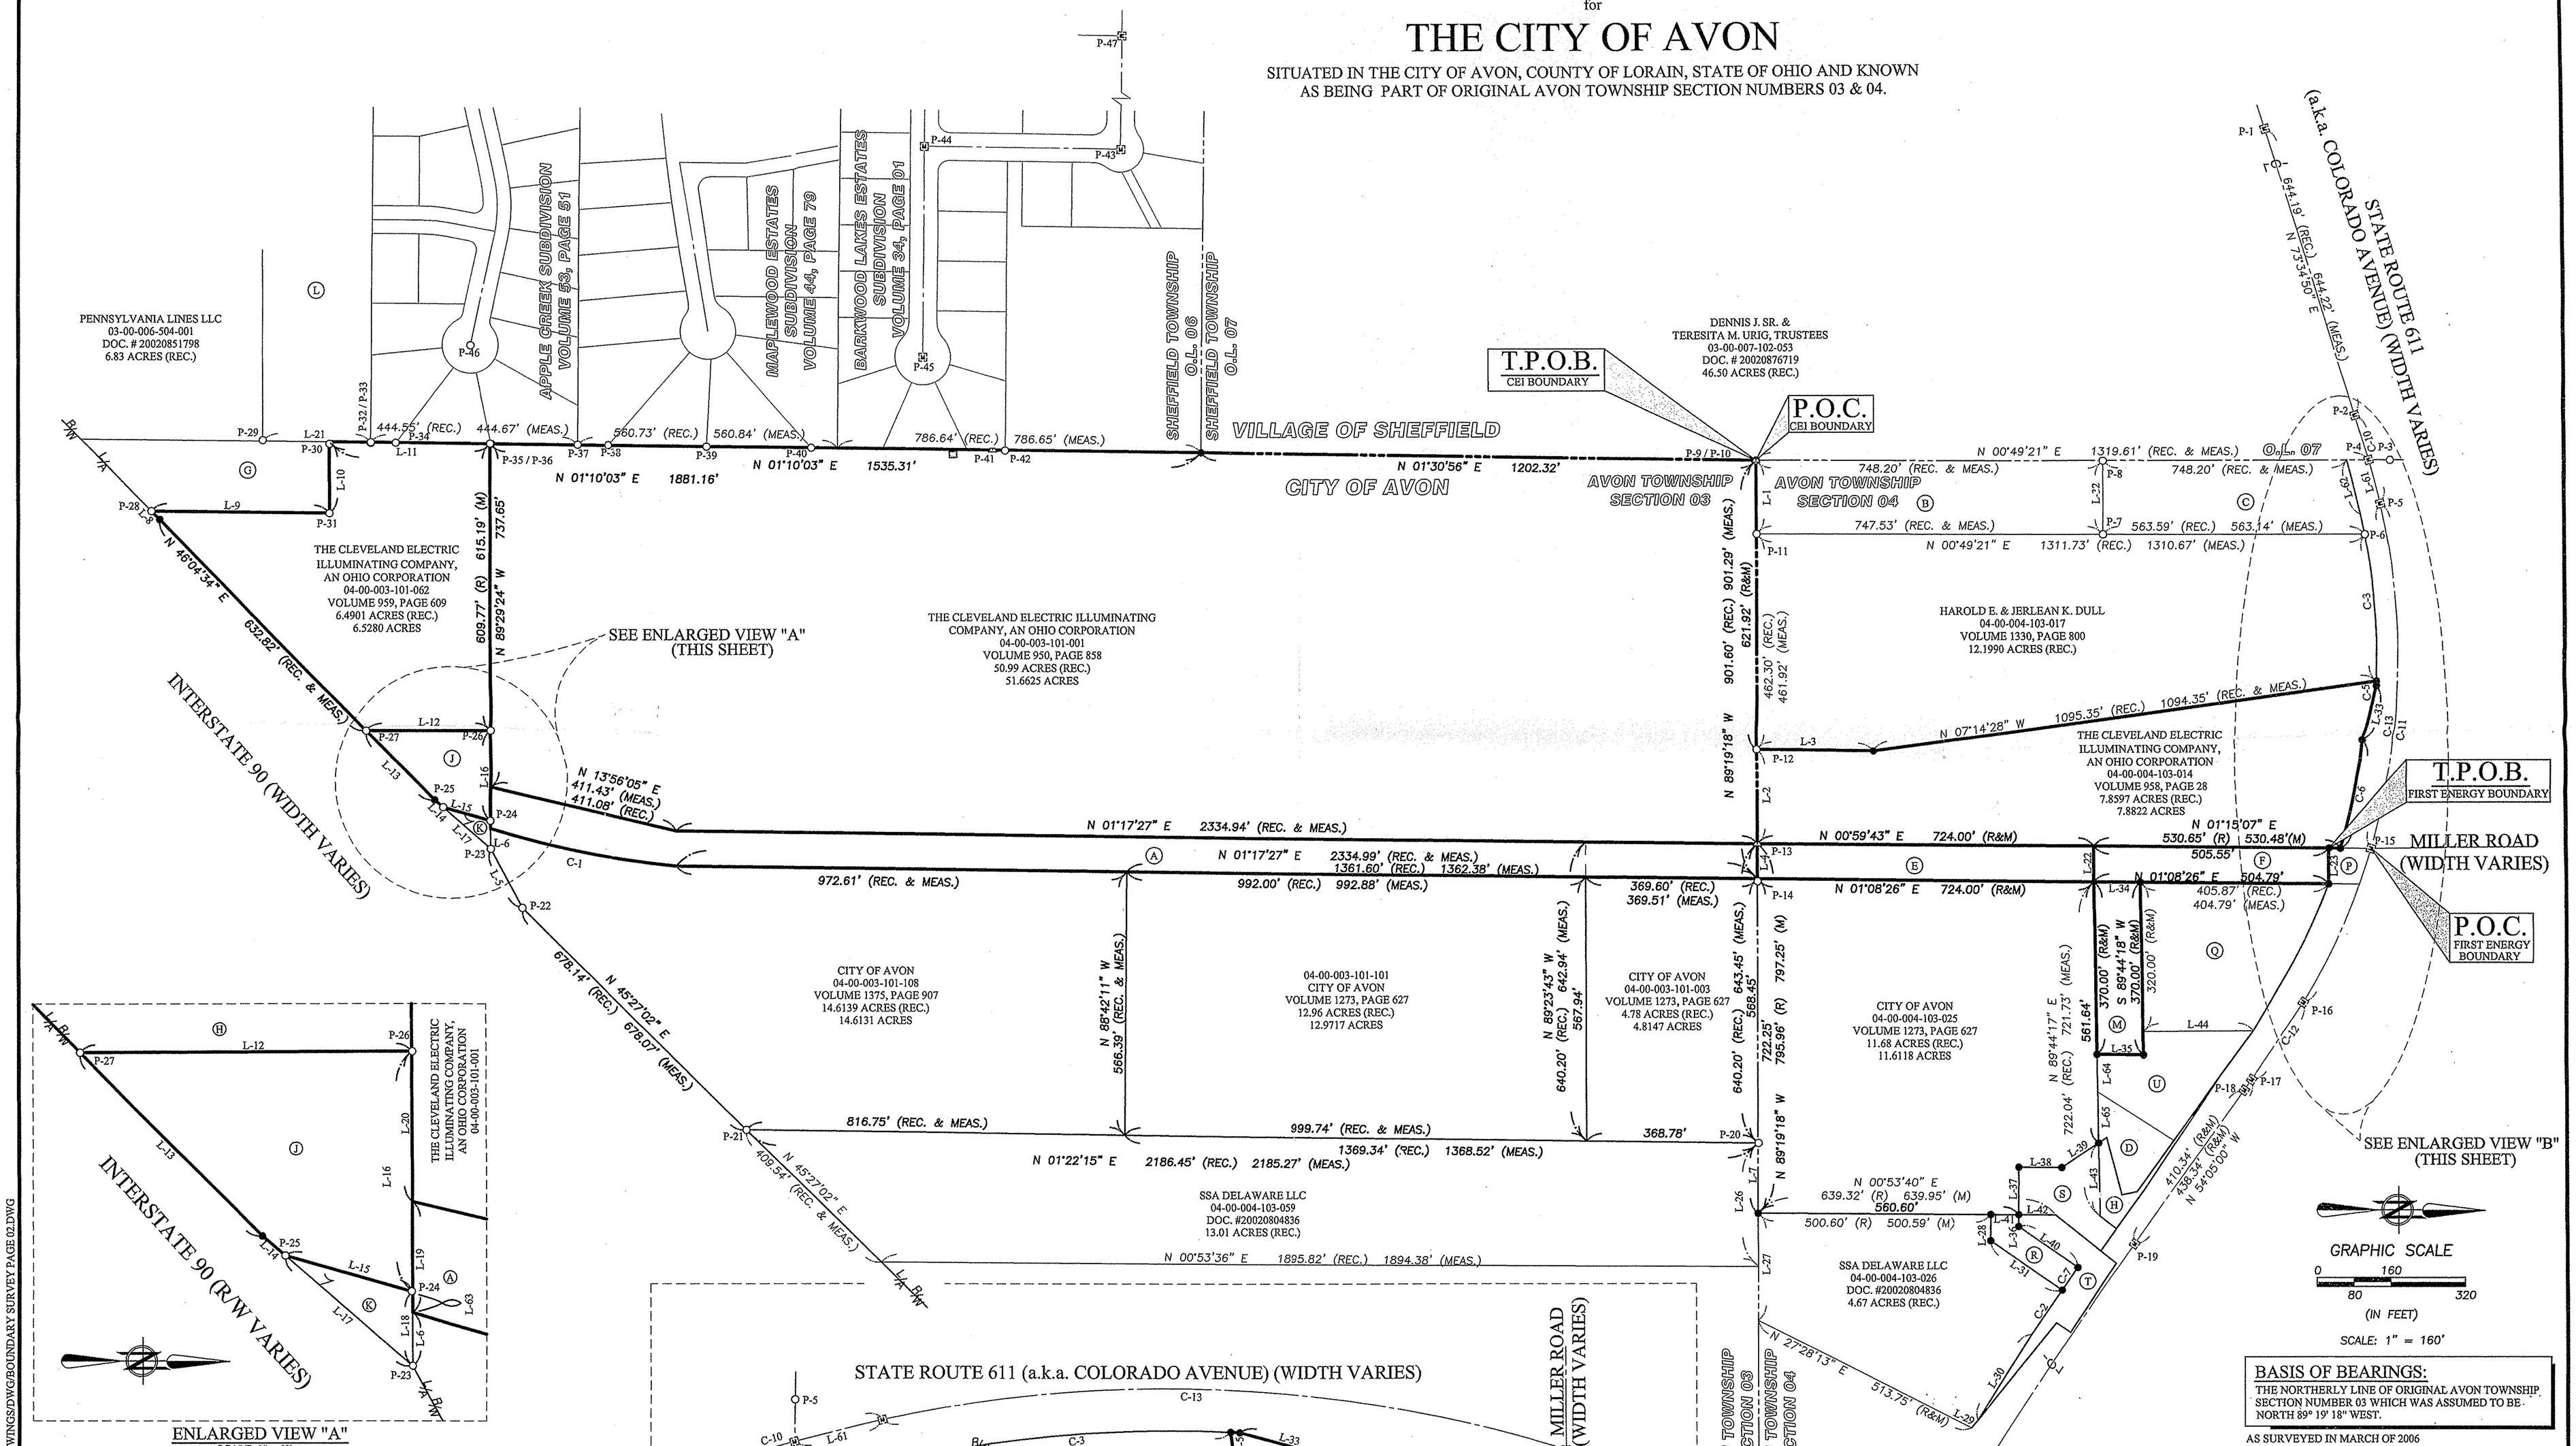

BASIS OF BEARINGS:
THE NORTHERLY LINE OF ORIGINAL AVON TOWNSHIP SECTION NUMBER 03 WHICH WAS ASSUMED TO BE NORTH 89° 19' 18" WEST.

AS SURVEYED IN MARCH OF 2006

REVISION	DATE:	BY:	DESCRIPTION:
	03-29-06	CMH	ISSUB TO CITY
	11-16-06	CMH	REVISED PER FIRST ENERGY COMMENTS

DRAWN BY: BDA

CHECKED BY: CMH

BRAMHALL
ENGINEERING AND SURVEYING CO., INC.
37307 HARVEST DRIVE AVON, OHIO 44011
(440) 934 - 7878 (440) 934 - 7879 FAX

SHEET 2 OF 3

JOB NO. 04-1966

J:/AVON/041966/DRAWINGS/DWG/BOUNDARY SURVEY PAGE 02.DWG