P.P. NO.

.T # 6-2005

PA

SUR.

Thomas Simon

DIMENSIONS SHOWN ON THIS PLAT ARE EXPRESSED IN FEET AND DECIMAL PARTS THEREOF. ALL BEARINGS ARE TO AN ASSUMED MERIDIAN AND ARE USED TO INDICATE ANGLES ONLY. PERMANENT MONUMENTS WERE FOUND OR SET AT ALL POINTS INDICATED HEREON, ALL OF WHICH I CERTIFY TO BE CORRECT.

STATE OF OHIO PROFESSIONAL SURVEYOR THOMAS A. SIMON S-7775 REGISTERED

THOMAS A. SIMON
REG. PROFESSIONAL SURVEYOR
NO. S-7775

50 0 50 100 150
GRAPHIC SCALE - FEET

BASIS OF BEARINGS IS THE CENTERLINE OF HALL ROAD (NORTH 10°56'01" EAST). IRON PINS SET ARE 5/8" DIAMETER, 30" LONG WITH PLASTIC CAPS "T. SIMON, S-7775".

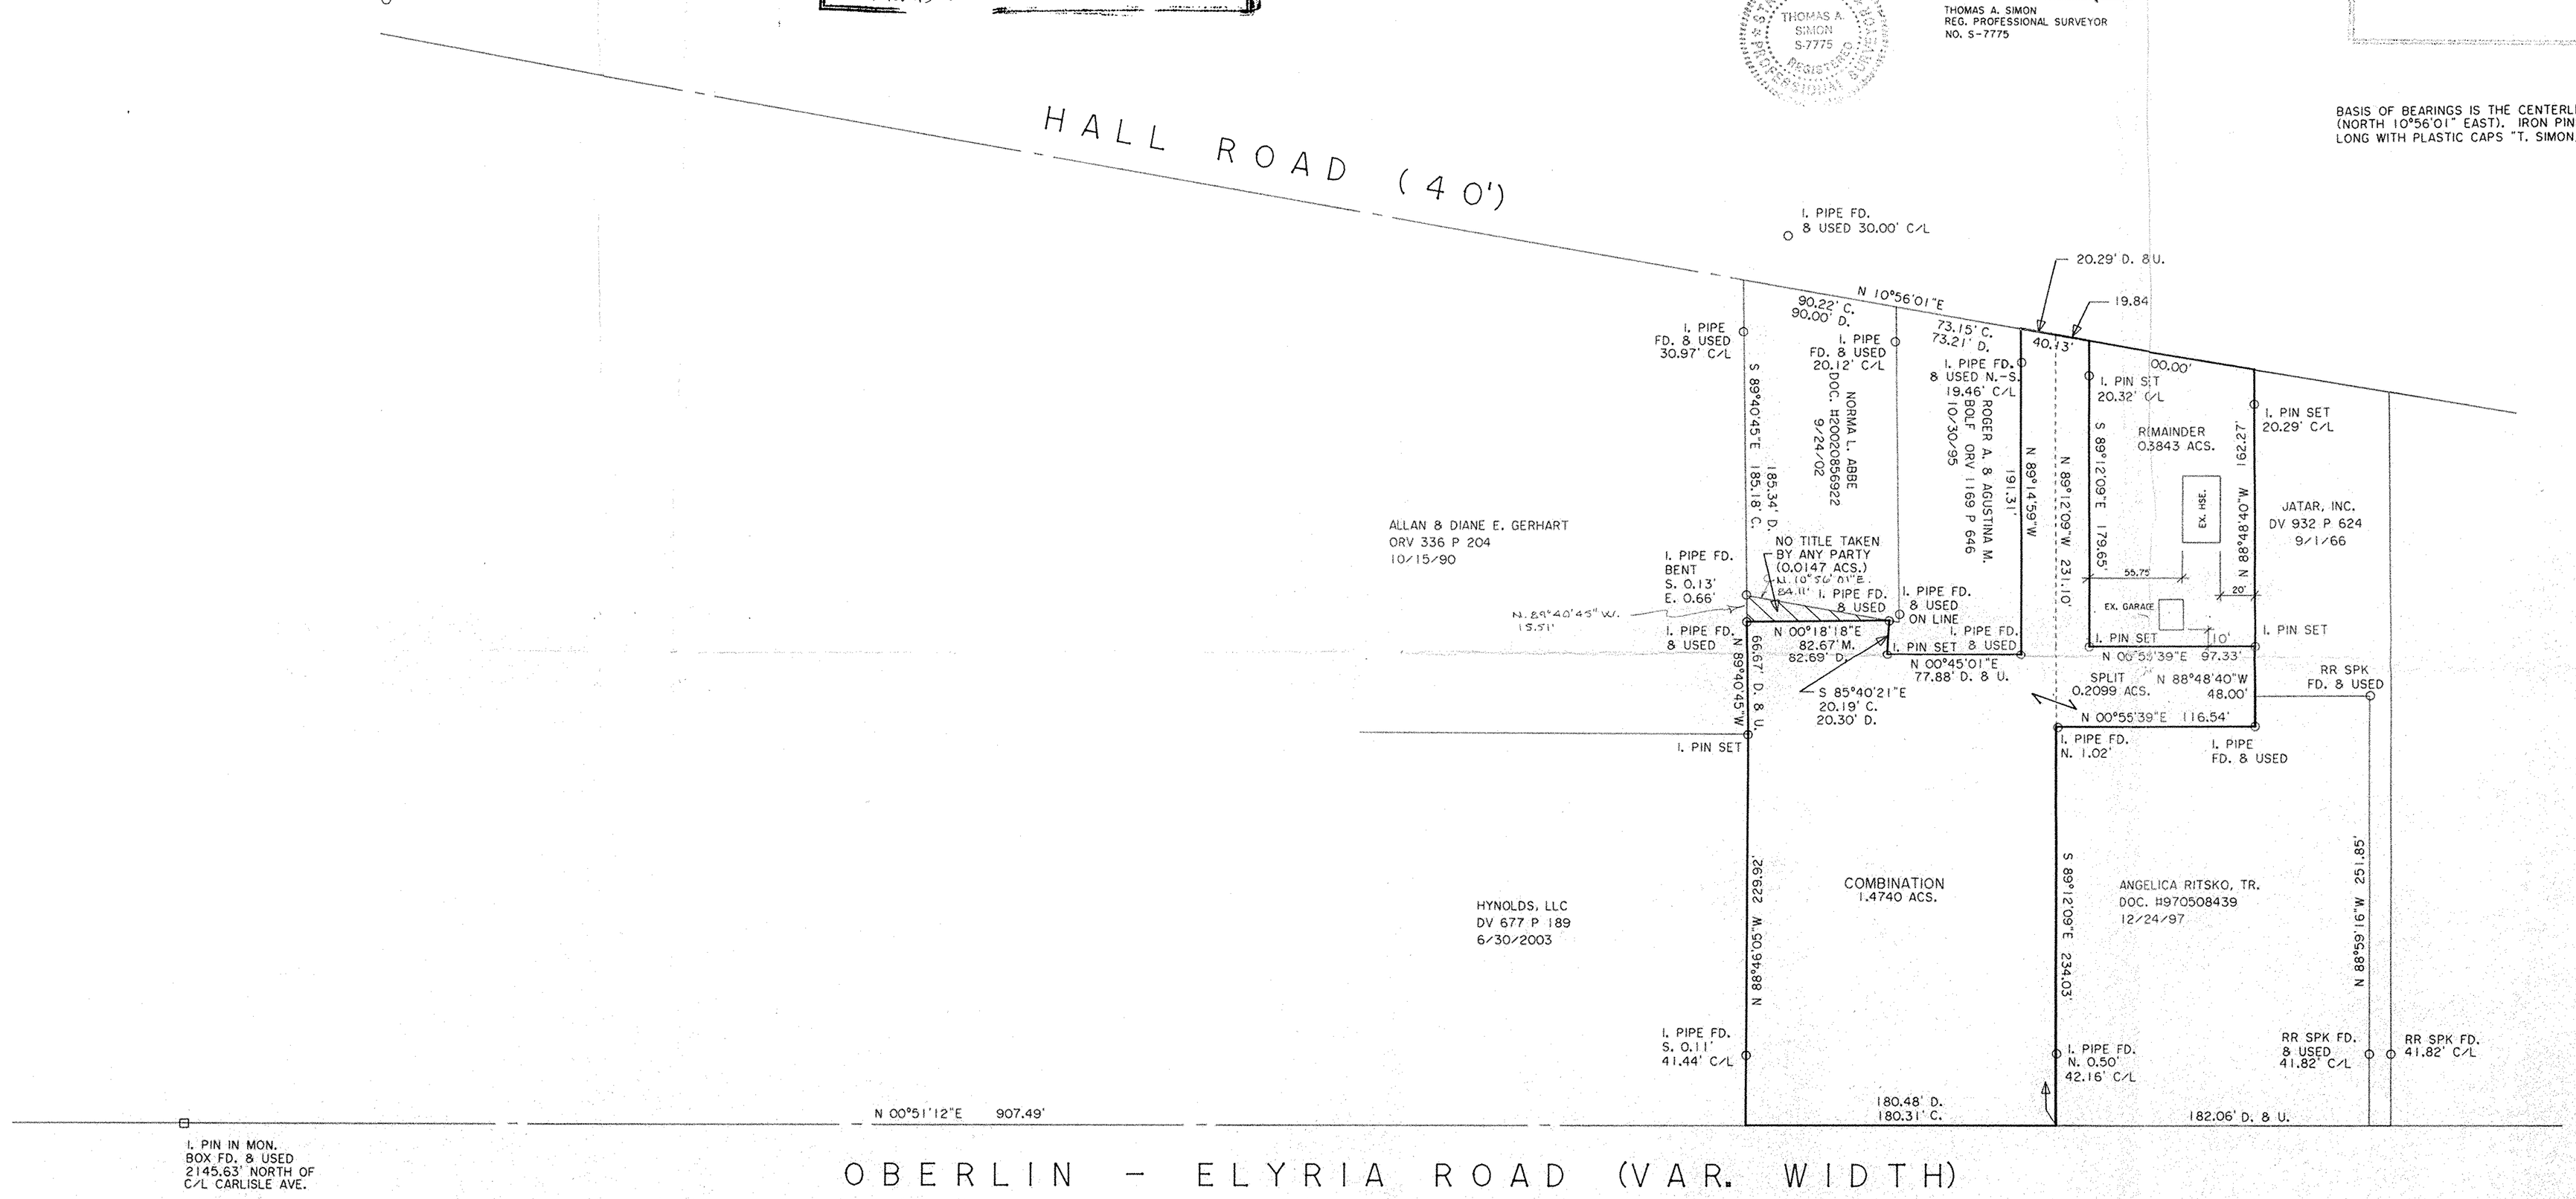

PLAT OF BOUNDARY SURVEY, SPLIT & COMBINATION
FOR
M & R MANAGEMENT, LLC
AN OHIO LIMITED LIABILITY COMPANY

BEING KNOWN AS PART OF ORIGINAL CARLISLE TOWNSHIP SECTION NO. 3

COUNTY OF LORAIN STATE OF OHIO

JUNE, 2005 SCALE: 1" = 50'

THOMAS SIMON & ASSOCIATES, INC.
PROFESSIONAL LAND SURVEYORS

COBBLESTONE CORNER PROFESSIONAL CENTER
39049 CENTER RIDGE ROAD
NORTH RIDGEVILLE, OHIO 44039
(440) 327-2925
FAX 327-2964