NOTE:
EXISTING SANITARY & STORM SEWER LOCATION & SIZE INFORMATION DERIVED FROM CITY of ELYRIA ENGINEERING DEPT.

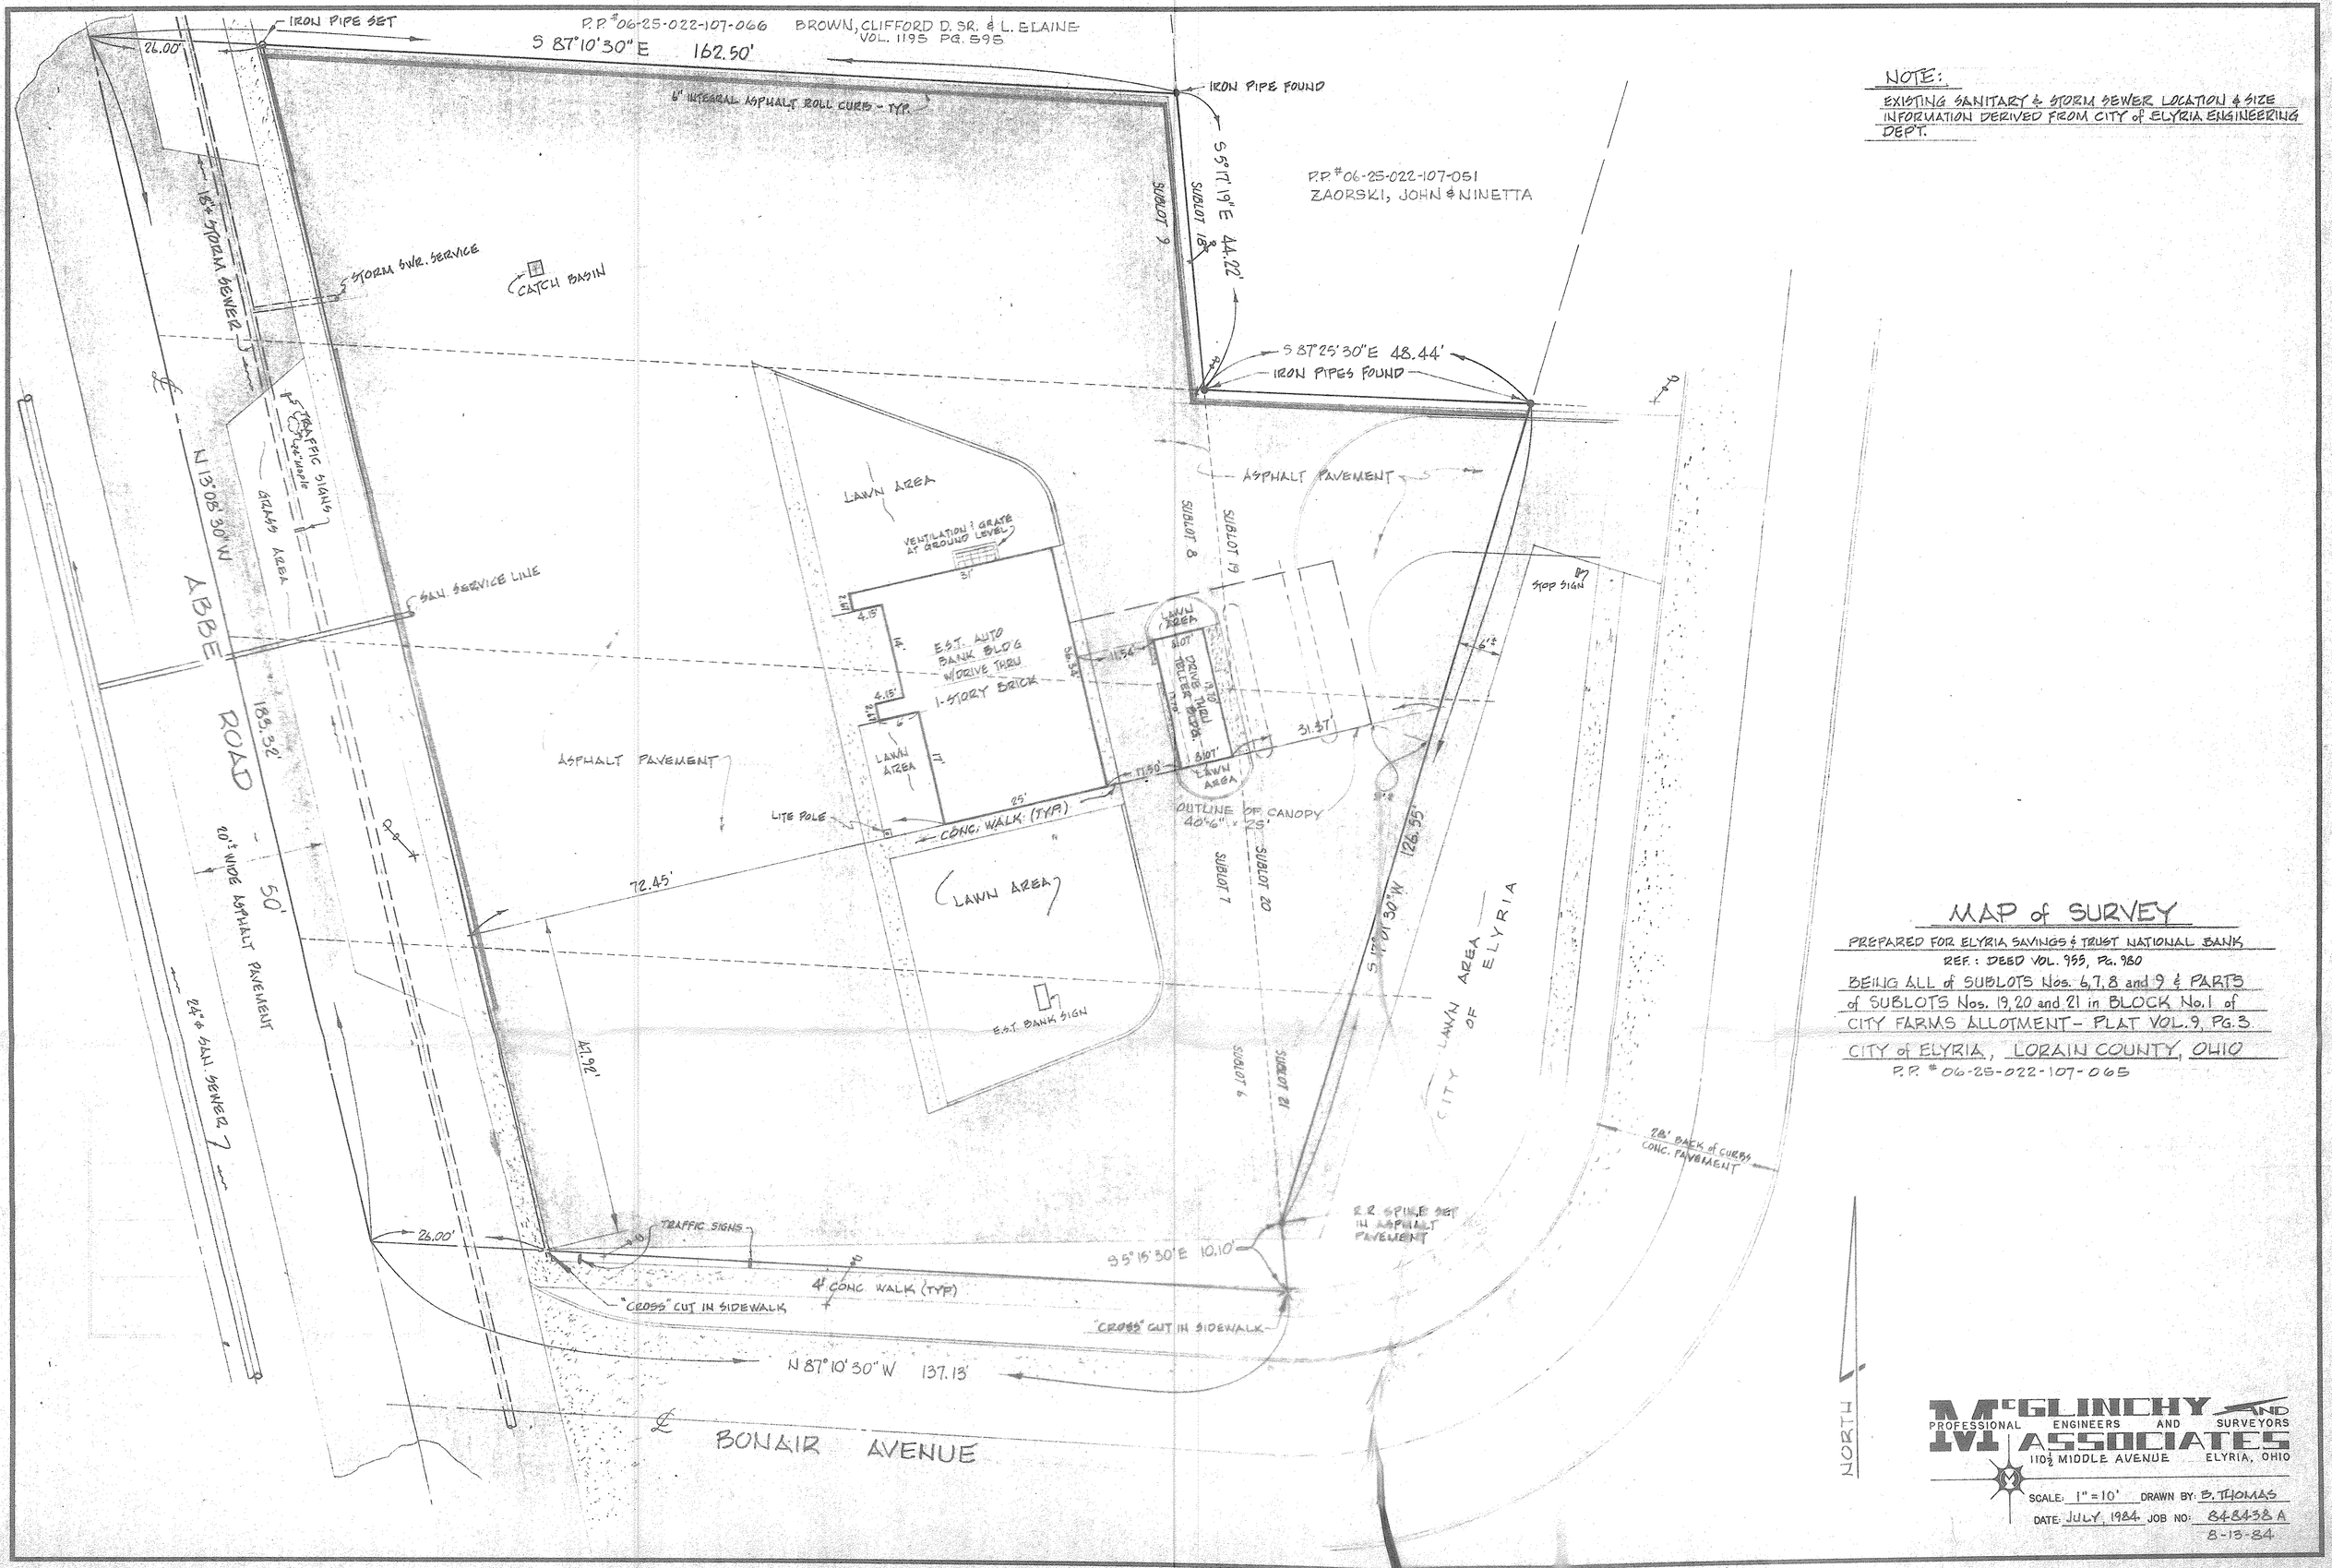

MAP of SURVEY

PREPARED FOR ELYRIA SAVINGS & TRUST NATIONAL BANK
REF.: DEED VOL. 955, PG. 980
BEING ALL of SUBLOTS Nos. 6, 7, 8 and 9 & PARTS of SUBLOTS Nos. 19, 20 and 21 in BLOCK No. 1 of CITY FARMS ALLOTMENT - PLAT VOL. 9, PG. 3.
CITY of ELYRIA, LORAIN COUNTY, OHIO
P.P. # 06-25-022-107-065

McGLINCHY AND ASSOCIATES
PROFESSIONAL ENGINEERS AND SURVEYORS
110½ MIDDLE AVENUE ELYRIA, OHIO

SCALE: 1" = 10' DRAWN BY: B. THOMAS
DATE: JULY, 1984 JOB NO: 848438 A
8-13-84