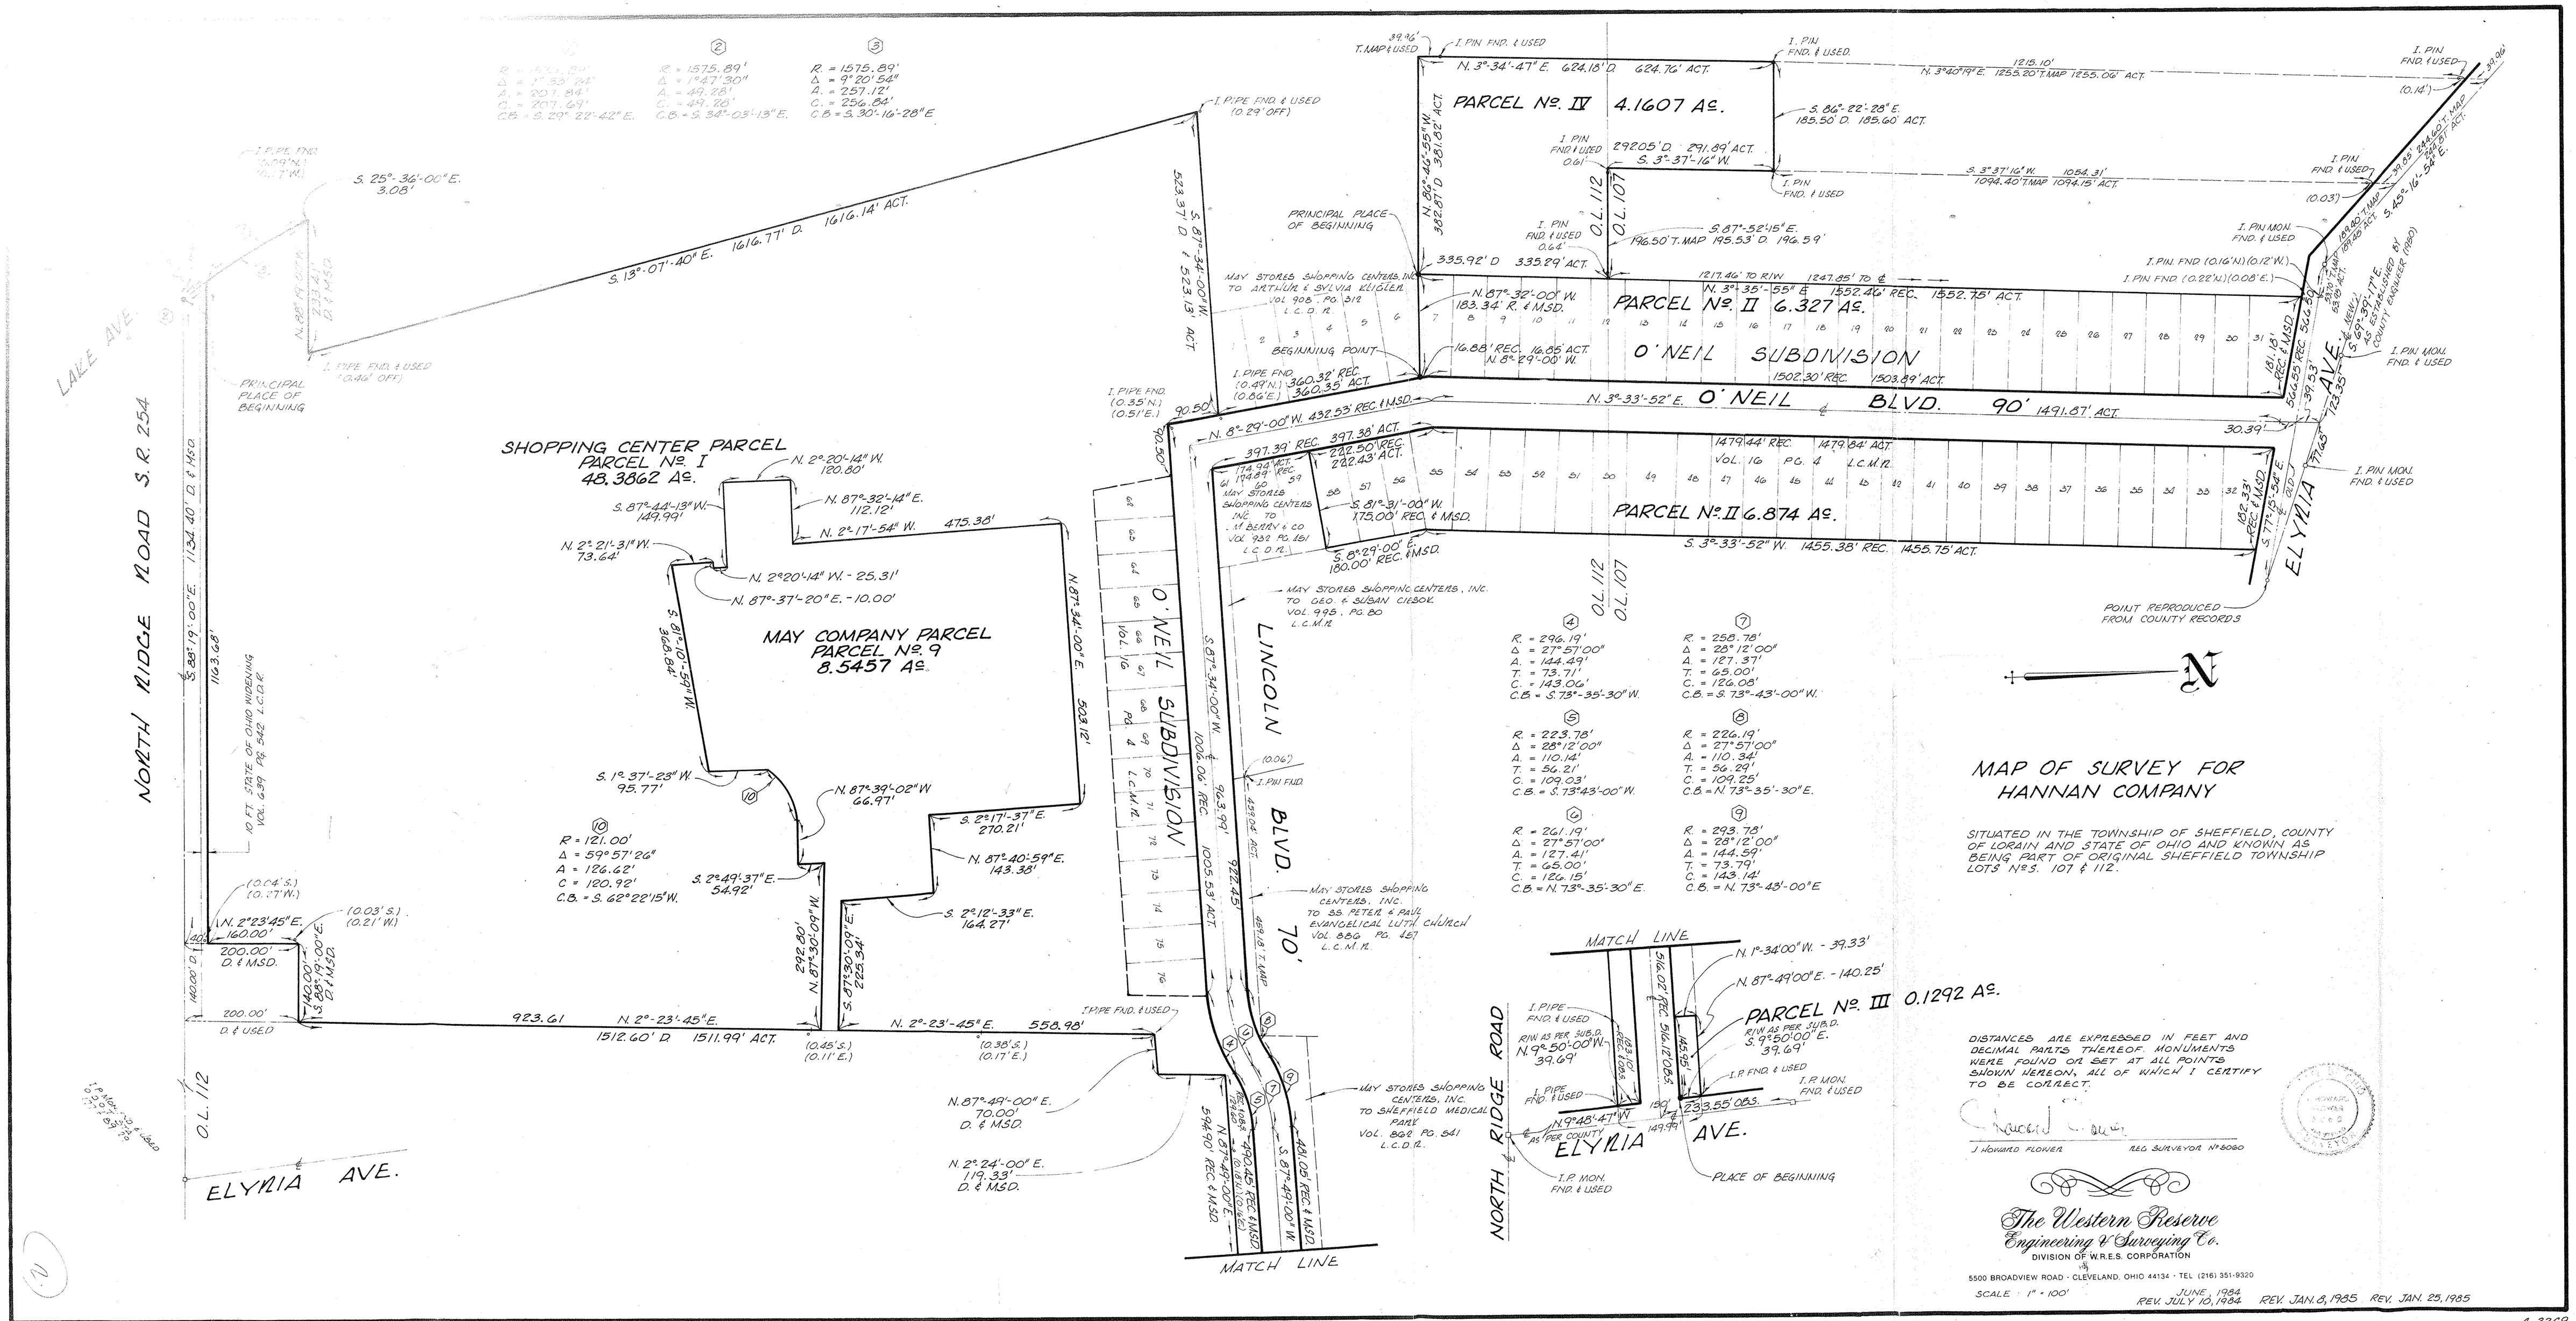
MAP OF SURVEY FOR
HANNAN COMPANY
SITUATED IN THE TOWNSHIP OF SHEFFIELD, COUNTY OF LORAIN AND STATE OF OHIO AND KNOWN AS BEING PART OF ORIGINAL SHEFFIELD TOWNSHIP LOTS Nos. 107 & 112.
DISTANCES ARE EXPRESSED IN FEET AND DECIMAL PARTS THEREOF. MONUMENTS WERE FOUND OR SET AT ALL POINTS SHOWN HEREON, ALL OF WHICH I CERTIFY TO BE CORRECT.
J. HOWARD FLOWER
REG. SURVEYOR No. 5060
The Western Reserve Engineering & Surveying Co.
DIVISION OF W.R.E.S. CORPORATION
5500 BROADVIEW ROAD · CLEVELAND, OHIO 44134 · TEL. (216) 351-9320
SCALE : 1" = 100'
JUNE, 1984
REV. JULY 10, 1984
REV. JAN. 8, 1985
REV. JAN. 25, 1985
A-2269
PARCEL No. IV 4.1607 Ac.
PARCEL No. II 6.327 Ac.
O'NEIL SUBDIVISION
O'NEIL BLVD. 90'
PARCEL No. II 6.874 Ac.
SHOPPING CENTER PARCEL
PARCEL No. I
48.3862 Ac.
MAY COMPANY PARCEL
PARCEL No. 9
8.5457 Ac.
NORTH RIDGE ROAD S.R. 254
LAKE AVE.
ELYRIA AVE.
LINCOLN BLVD. 70'
O'NEIL SUBDIVISION
PARCEL No. III 0.1292 Ac.
NORTH RIDGE ROAD
MATCH LINE
POINT REPRODUCED FROM COUNTY RECORDS
PRINCIPAL PLACE OF BEGINNING
BEGINNING POINT
PLACE OF BEGINNING
O.L. 112
O.L. 107
N