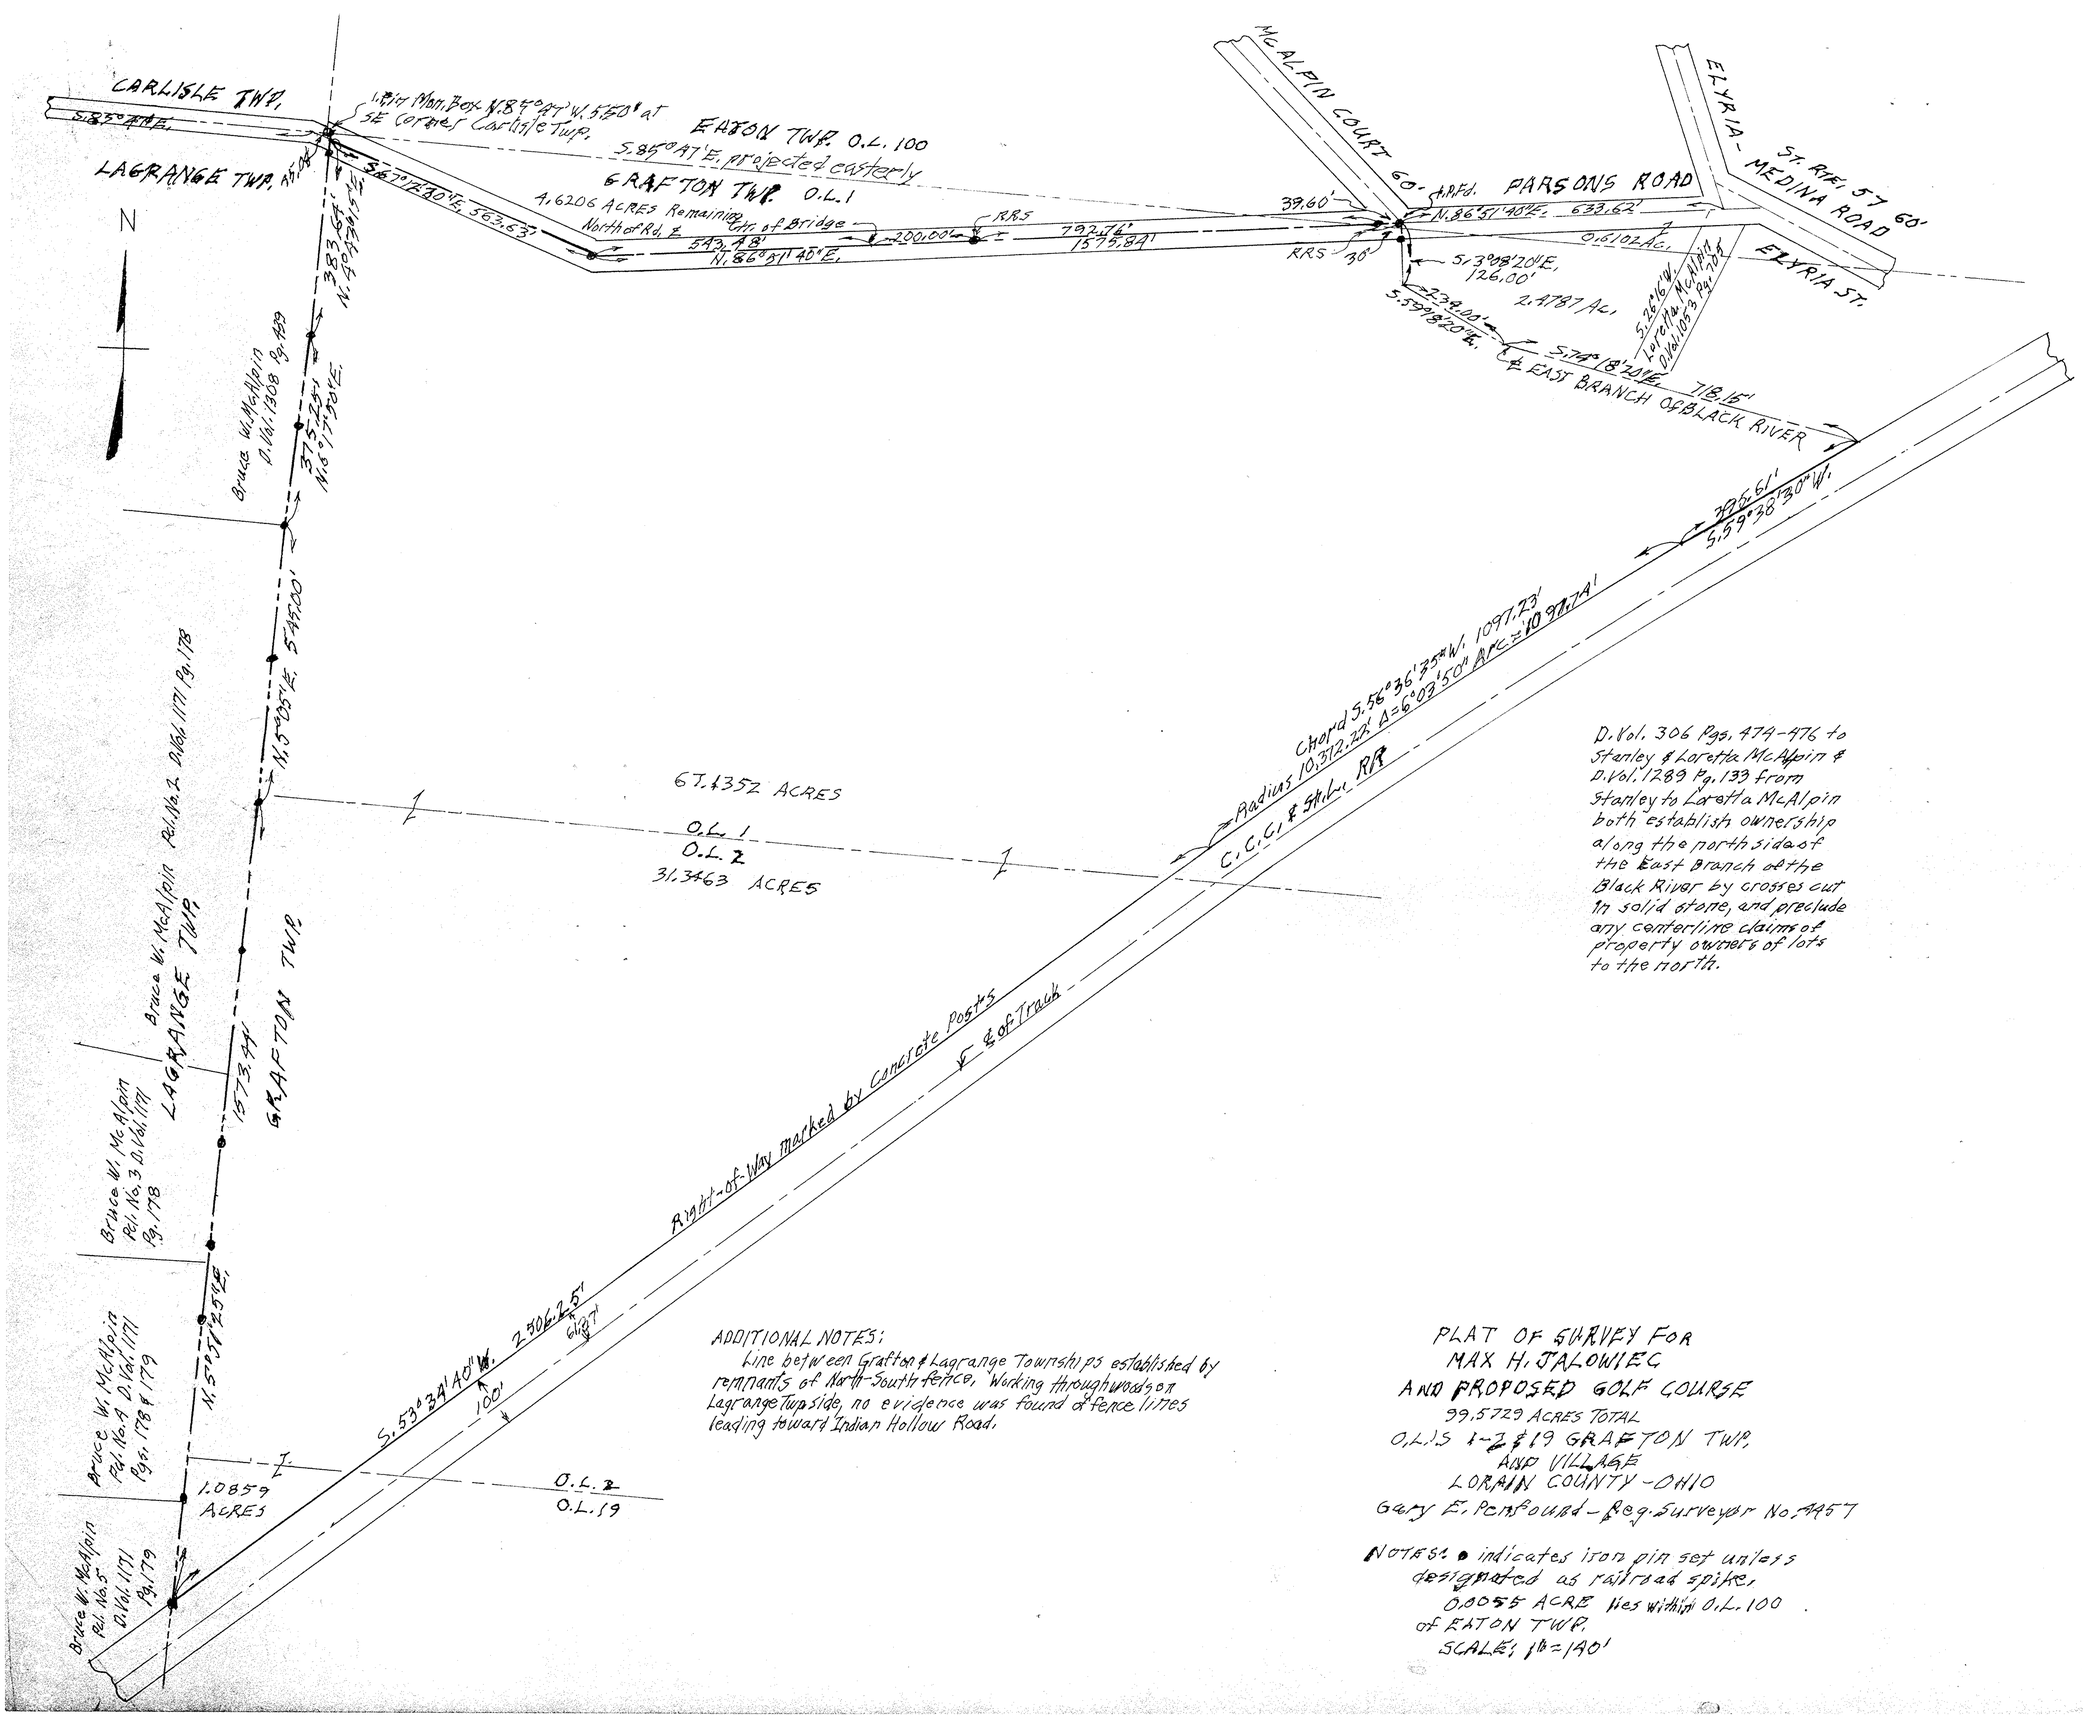

D. Vol. 306 Pgs. 474-476 to Stanley & Loretta McAlpin & D. Vol. 1289 Pg. 133 from Stanley to Loretta McAlpin both establish ownership along the north side of the East Branch of the Black River by crosses cut in solid stone, and preclude any centerline claims of property owners of lots to the north.

ADDITIONAL NOTES:
Line between Grafton & Lagrange Townships established by remnants of North-South fence. Working through woods on Lagrange Twp side, no evidence was found of fence lines leading toward Indian Hollow Road.

PLAT OF SURVEY FOR
MAX H. JALOWIEC
AND PROPOSED GOLF COURSE
99.5729 ACRES TOTAL
O.L.'S 1-2 & 19 GRAFTON TWP.
AND VILLAGE
LORAIN COUNTY - OHIO
Gary E. Pomfound - Reg. Surveyor No. 4957

NOTES: ● indicates iron pin set unless designated as railroad spike.
0.0055 ACRE lies within O.L. 100 of EATON TWP.
SCALE: 1" = 190'