DATE	REVISIONS	BY

LEGEND

ITEM	DESCRIPTION
R/W	RIGHT-OF-WAY
C/L	CENTERLINE OF R/W
P/L	PROPERTY LINE
E.L.	EASEMENT LINE
COMB	COMBINATION STORM & SANITARY SEWER
W	WATER MAIN, HYDRANT & VALVE
WSO	WATER SHUTOFF
G GSO	GAS MAIN AND GAS SHUTOFF VALVE
	OVERHEAD WIRES (AS NOTED)
TELE	UNDRGD. TELEPHONE DUCTS/CONDUIT & MANHOLE
ELEC	UNDRGD. ELECTRIC DUCTS/CONDUIT
	TREE
	WOOD UTILITY POLE
	WOOD UTILITY POLE WITH ANCHOR
	UTILITY POLE WITH LIGHT
	LIGHT POLE
	CONCRETE
	ASPHALT
726	SPOT ELEVATION
726	CONTOUR ELEVATION
	METAL PIPE WITH WIRE (DIA. VARIES)
	TRAFFIC SIGN

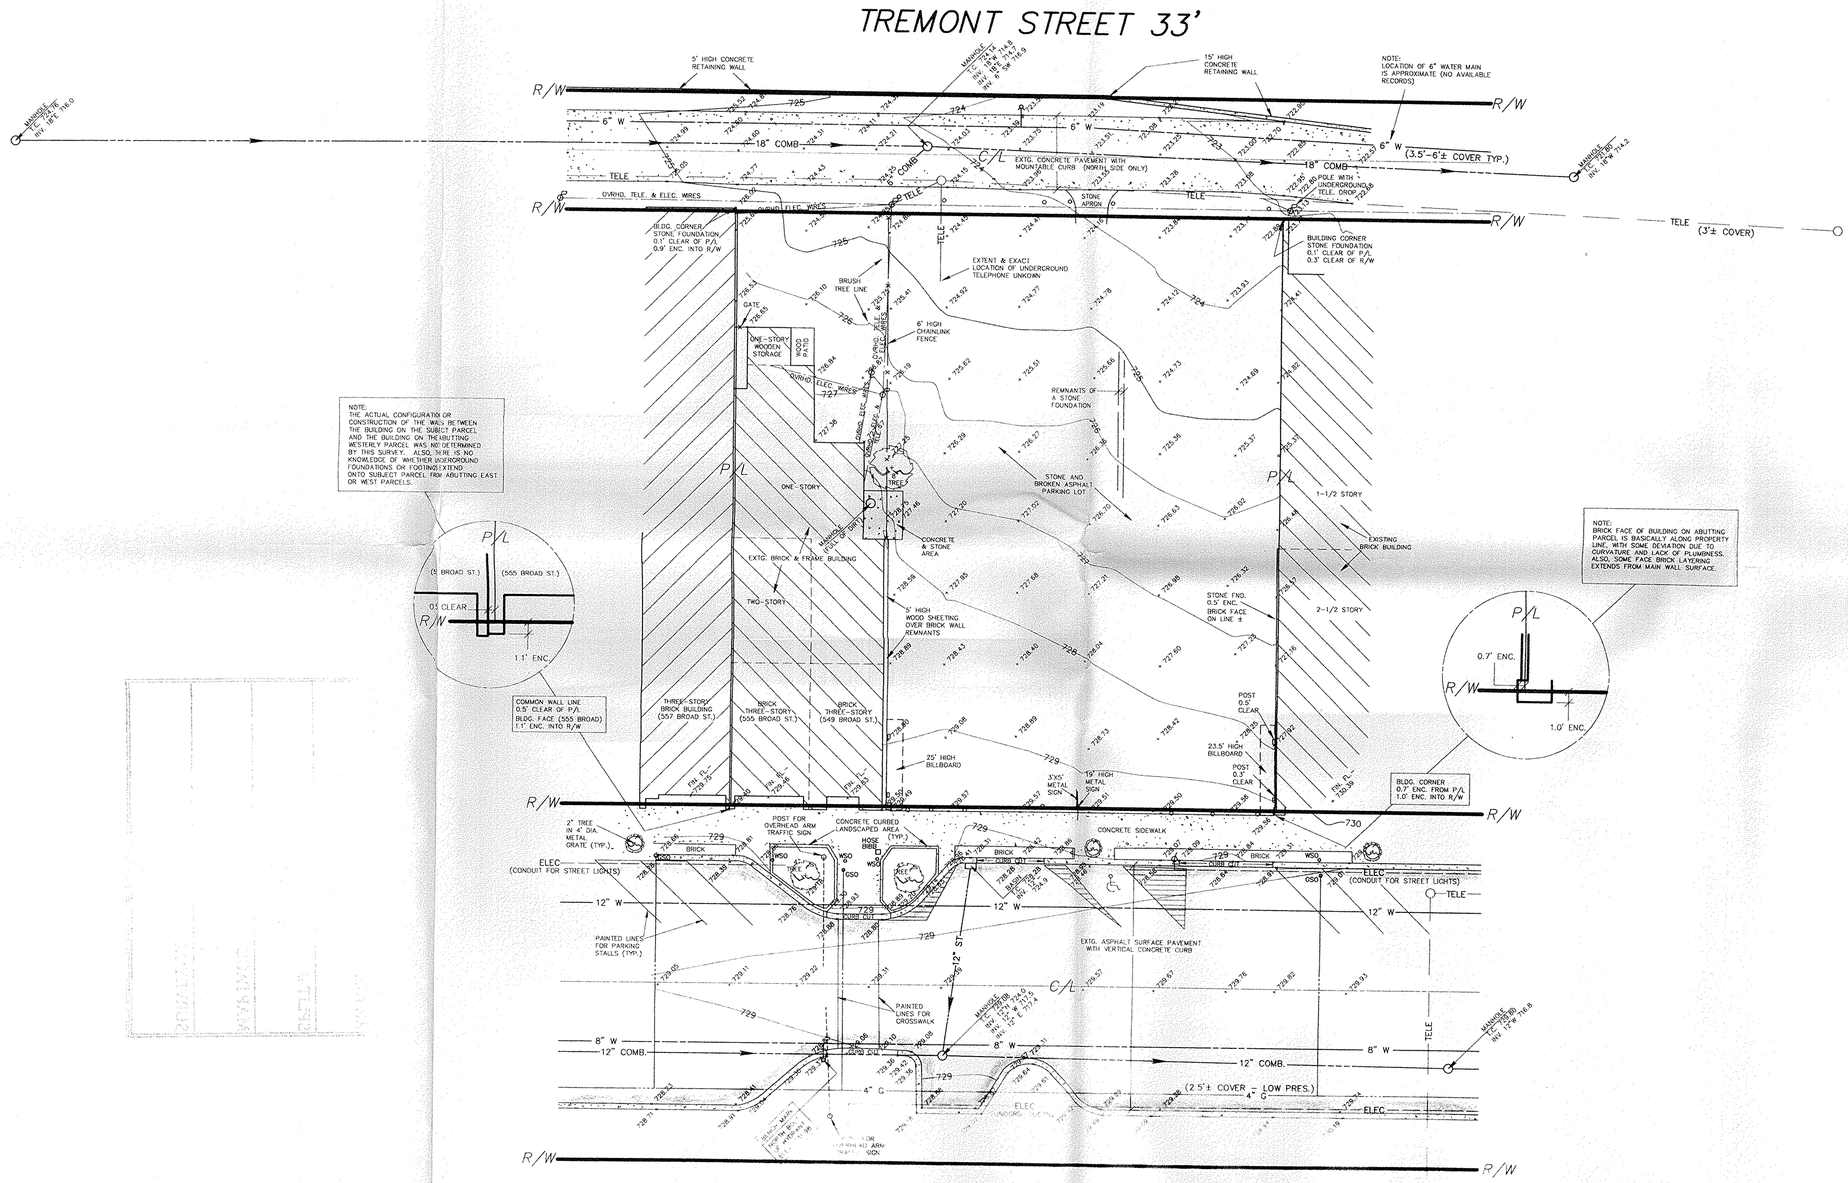

NOTE:
UNDERGROUND UTILITIES ARE SHOWN BASED UPON ACTUAL LOCATIONS OF ABOVE GROUND STRUCTURES AND RECORDS OF OTHERS AS TO UNDERGROUND LOCATIONS, SIZES AND CONFIGURATIONS.

LOCATION MAP

DONALD G. BOHNING & ASSOCIATES, INC.
CIVIL ENGINEERING & SURVEYING
7979 HUB PARKWAY • VALLEY VIEW, OHIO 44125 • (216) 642-1130

HORIZ. SCALE	DR'N	CKD.	DATE	
1"=20'	M.G.	K.G.	SEPT., 1993	2/2
VERT. SCALE	FIELD BOOK		ORDER NO.	
-----			2484 S	