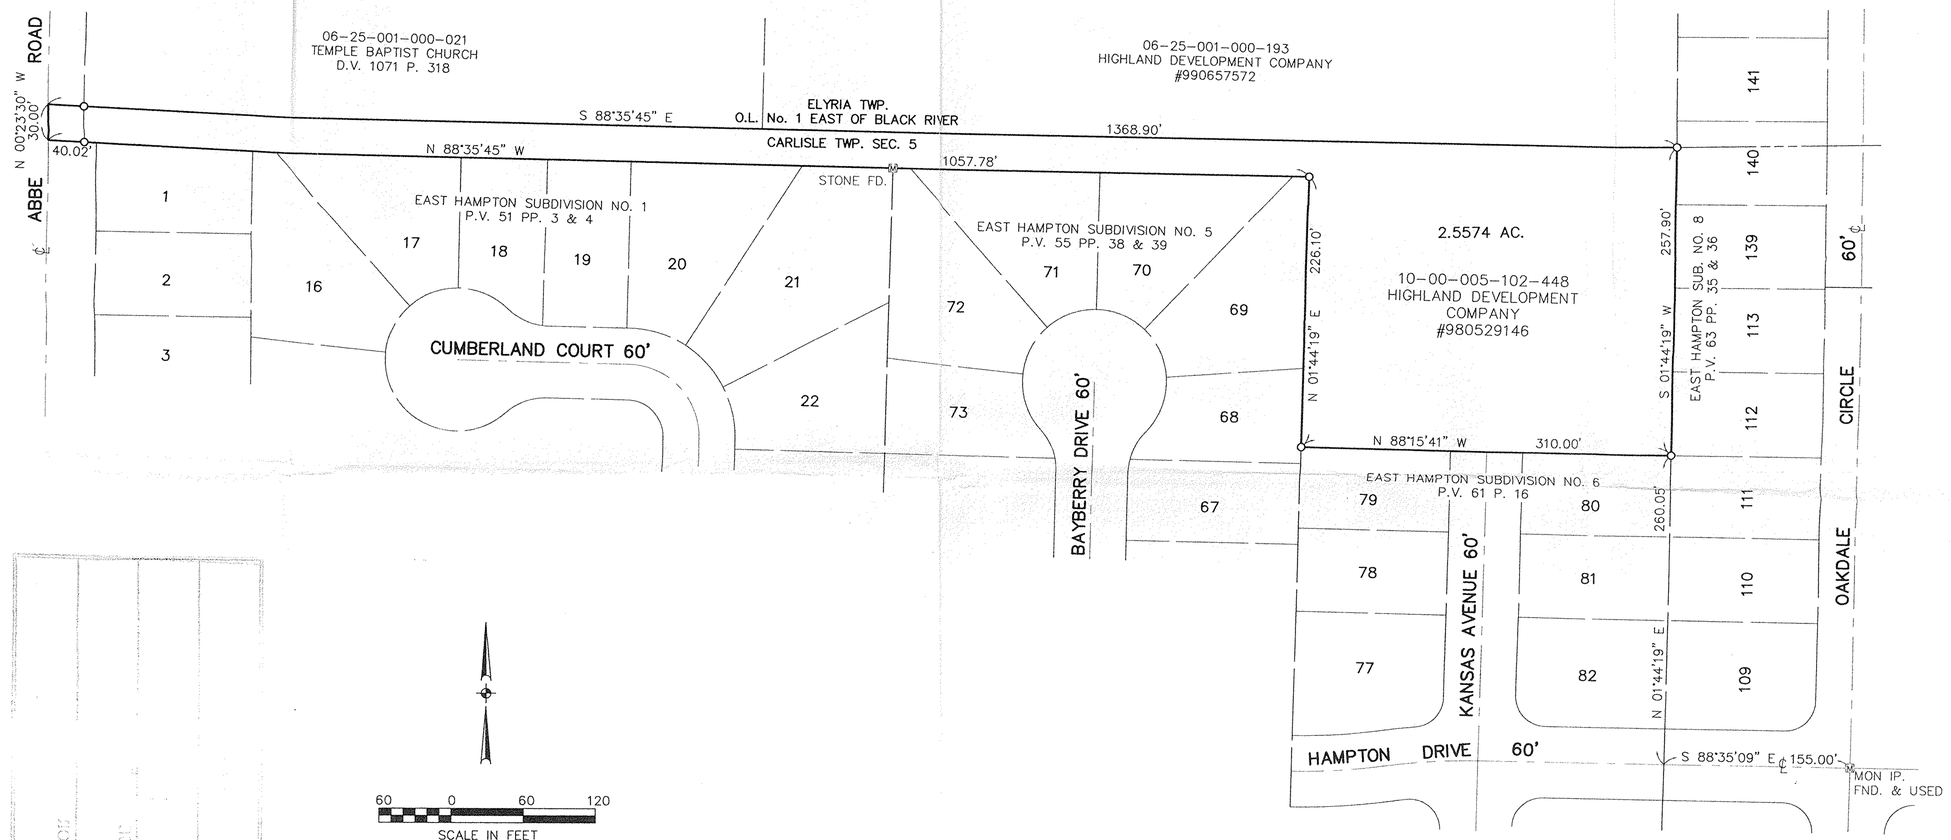

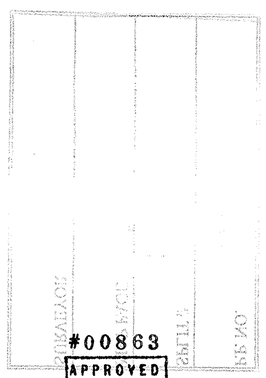

LEGEND

- MONUMENT BOX FOUND
- IRON PIN/PIPE FOUND
- 5/8" CAPPED REBAR SET

David L. Elwell

DAVID L. ELWELL, REG. SURVEYOR No. 6333

STATE OF OHIO
DAVID L. ELWELL
6333
REGISTERED
SURVEYOR

DATE: 8-13-01	REVISIONS	DATE	DESCRIPTION	BY
DRAWN BY: ABR				
CH'D BY:				
DWG. NAME: 1-SURV01				
PATH: 99174-CP1				
F.B.		8-13-01	ORIGINAL ISSUE	ABR

KS ASSOCIATES, INC.
260 Burns Road, Suite 100
P.O. Box 569
Elyria, Ohio 44036
Phone (440) 365-4730
Fax (440) 365-4790
mailroom@ksossoc.com
www.ksossoc.com
KS ASSOCIATES

SURVEY MAP

OF PART OF CARLISLE TOWNSHIP SECTION NO. 5
CITY OF ELYRIA COUNTY OF LORAIN STATE OF OHIO

SHEET 1 OF 1

JOB NO. 99174

14.18