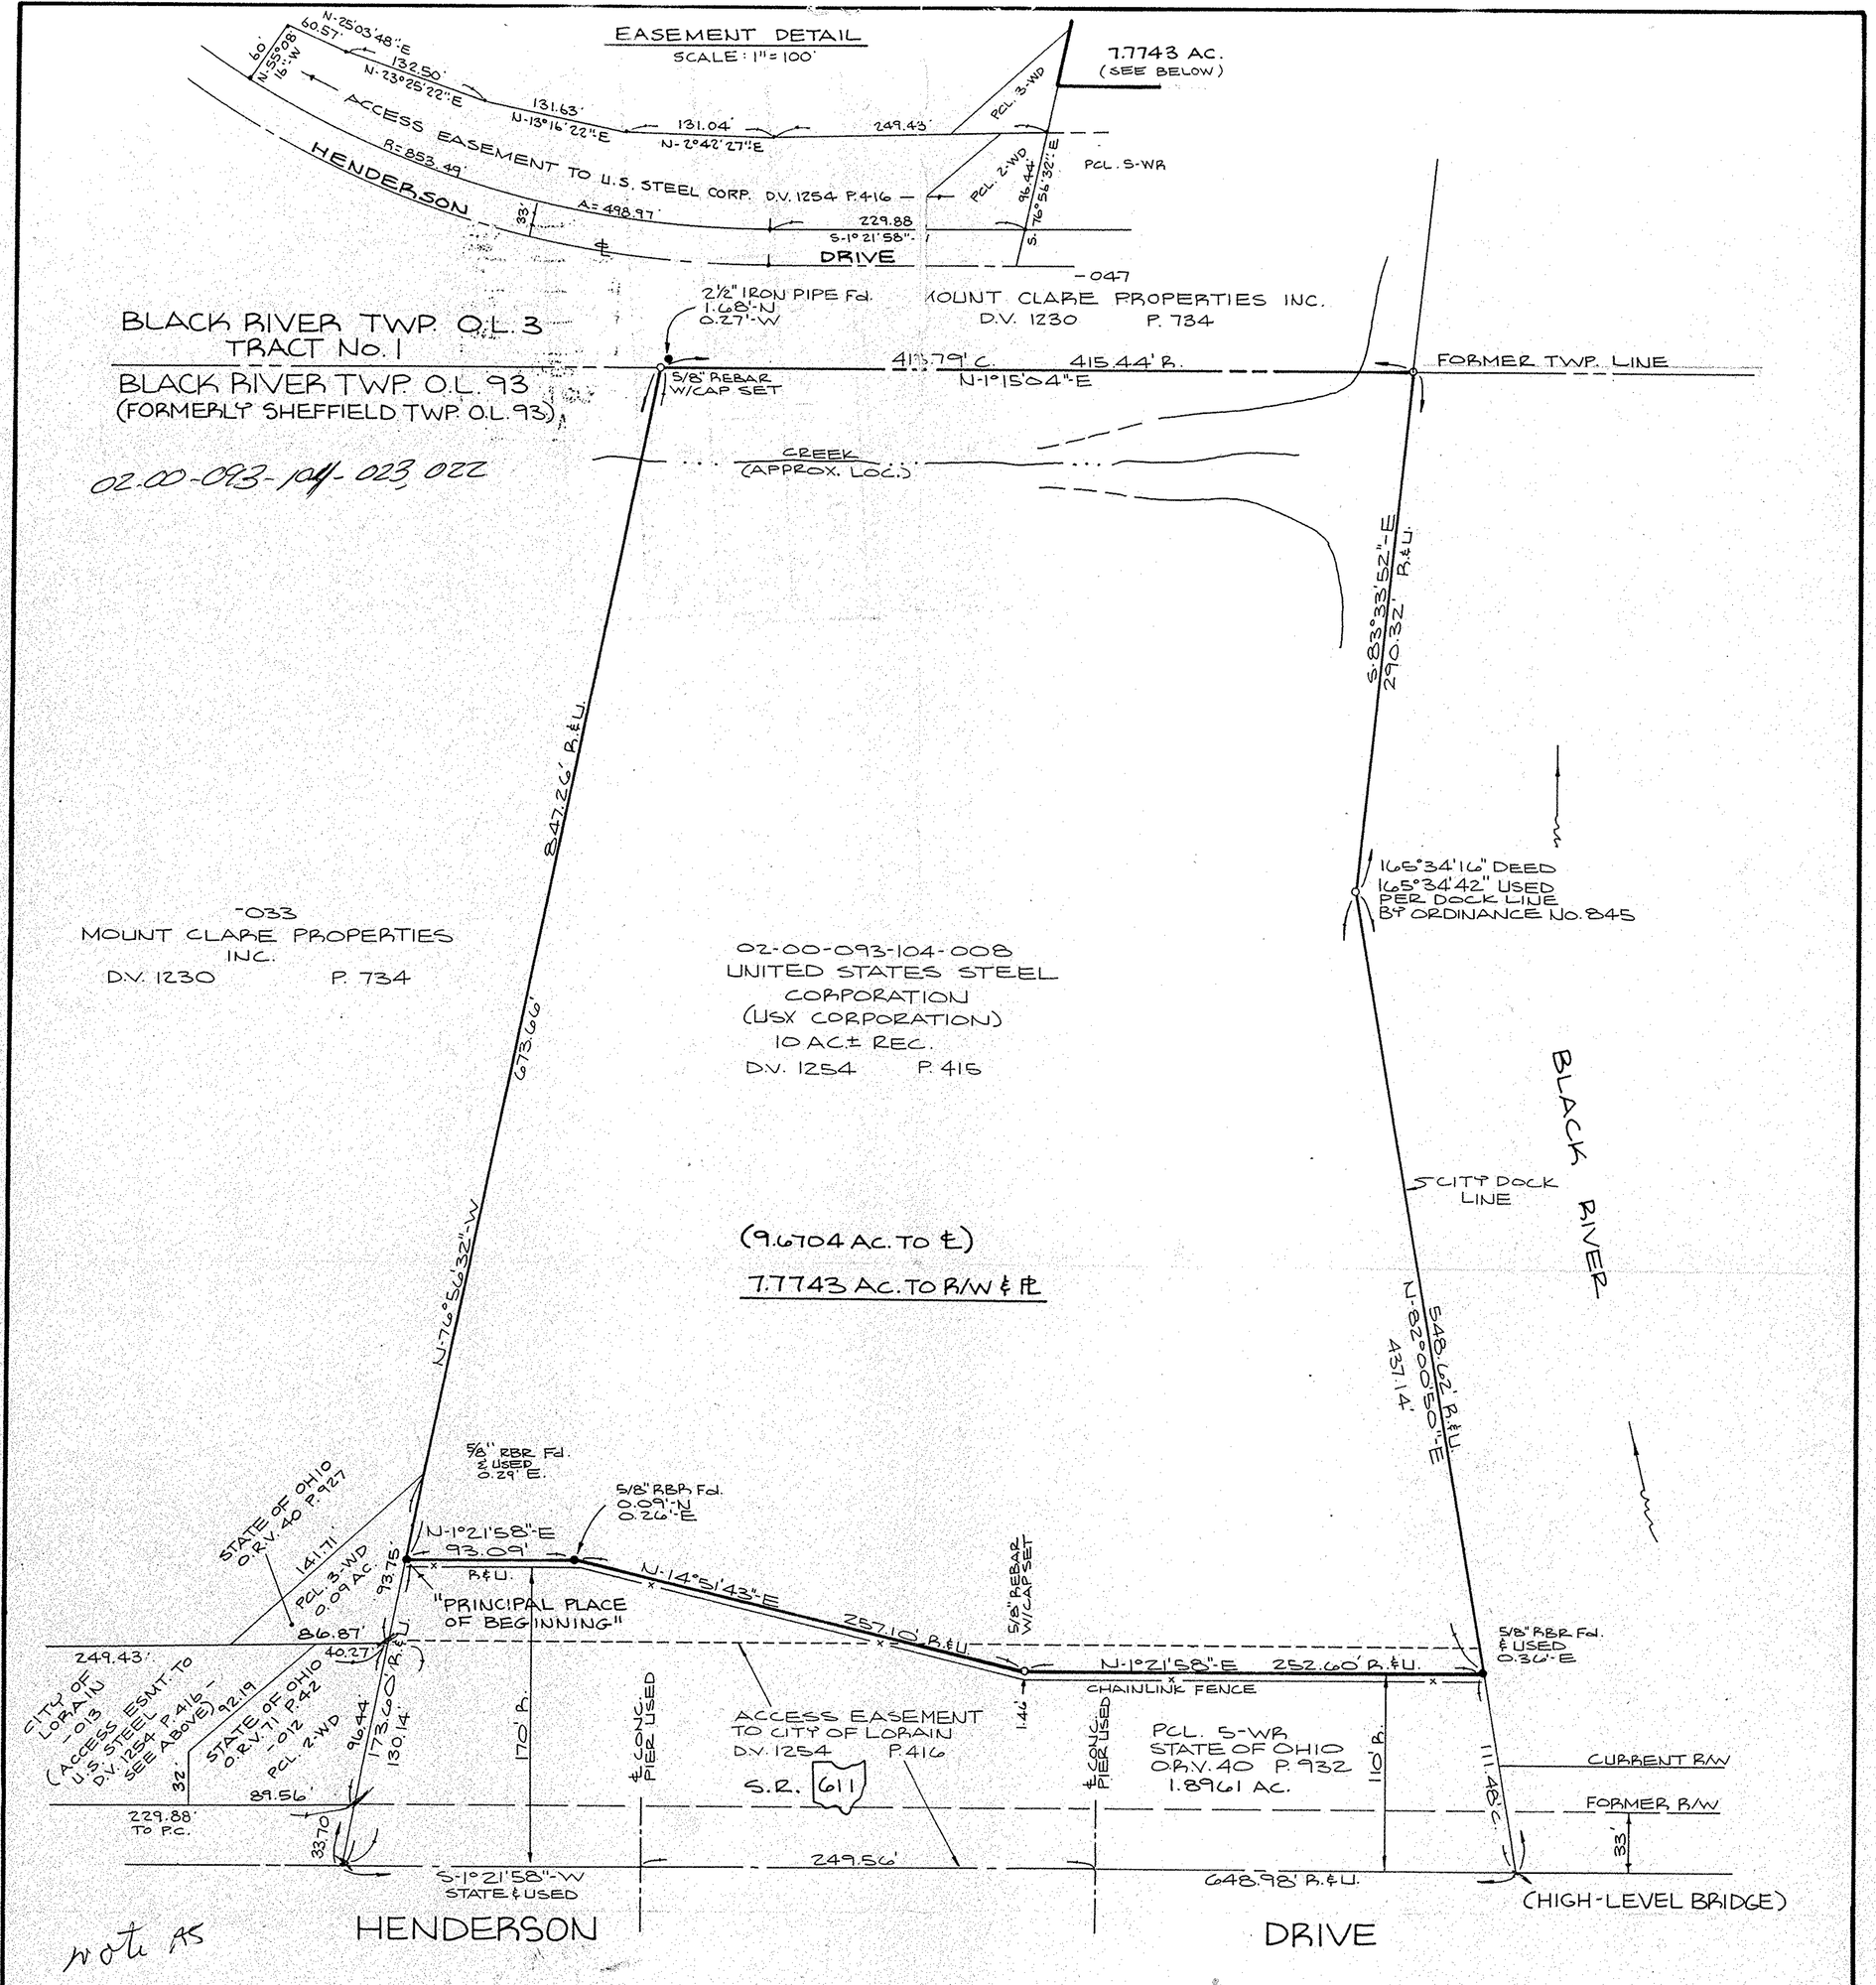

NORTH

BEARINGS SHOWN ARE TO AN ASSUMED MERIDIAN AND USED FOR THE PURPOSE OF DESCRIBING ANGLES ONLY.

0 50 100 150
FEET
SCALE: 1" = 60'

#22113
APPROVED
LORAIN CO.
MAP DEPT.
DATE 4-10-97
PAGE 2-00-052
BY R. BELL
VOID AFTER # 22113

SURVEY MAP
OF PART OF
ORIGINAL BLACK RIVER TOWNSHIP
LOT No. 93
CITY OF LORAIN
COUNTY OF LORAIN STATE OF OHIO
AUGUST 25, 1995

NOTE: HEAVY LINE DENOTES BOUNDARY LINES OF SURVEYED PARCEL:

LEGEND

——— - ———	CENTERLINE
——— - - ———	ORIGINAL LOT LINE
- - - - - - - -	EASEMENT LINE
— — — —	FORMER RIGHT OF WAY
R.&U.	RECORD AND USED
C.	CALCULATED
R.	RECORD

PREPARED BY:
KS ASSOCIATES INC.
ENGINEERS SURVEYORS
REVISION 9-8-95

David L. Elwell
DAVID L. ELWELL
REG. SURVEYOR No. 6333

STATE OF OHIO
DAVID L. ELWELL
6333
REGISTERED
SURVEYOR

95304-A