Scale: 1" = 30'

Surety Title Agency, Inc.
ORDER NO. ST 23369
ESCROW NO. 99-193C

ALTA SURVEY

MADE FOR AND AT
THE INSTANCE OF

GMAC COMMERCIAL MERTGAGE CORPORATION, A CALIFORNIA CORPORATION, AMD ITS SUCCESSORS AND ASSIGNS
FIRST AMERICAN TITLE INSURANCE COMPANY
ICARUS DEVELOPEMENT GROUP, LLC
L.E.W. DEVELOPEMENT COMPANY
SURETY TITLE COMPANY, AND ITS SUCCESSORS AND ASSIGNS

CITY OF ELYRIA COUNTY OF LORAIN STATE OF OHIO
MAY 1999
ORDER NO.: ST 23369
AREA: 1.6507 ACRES

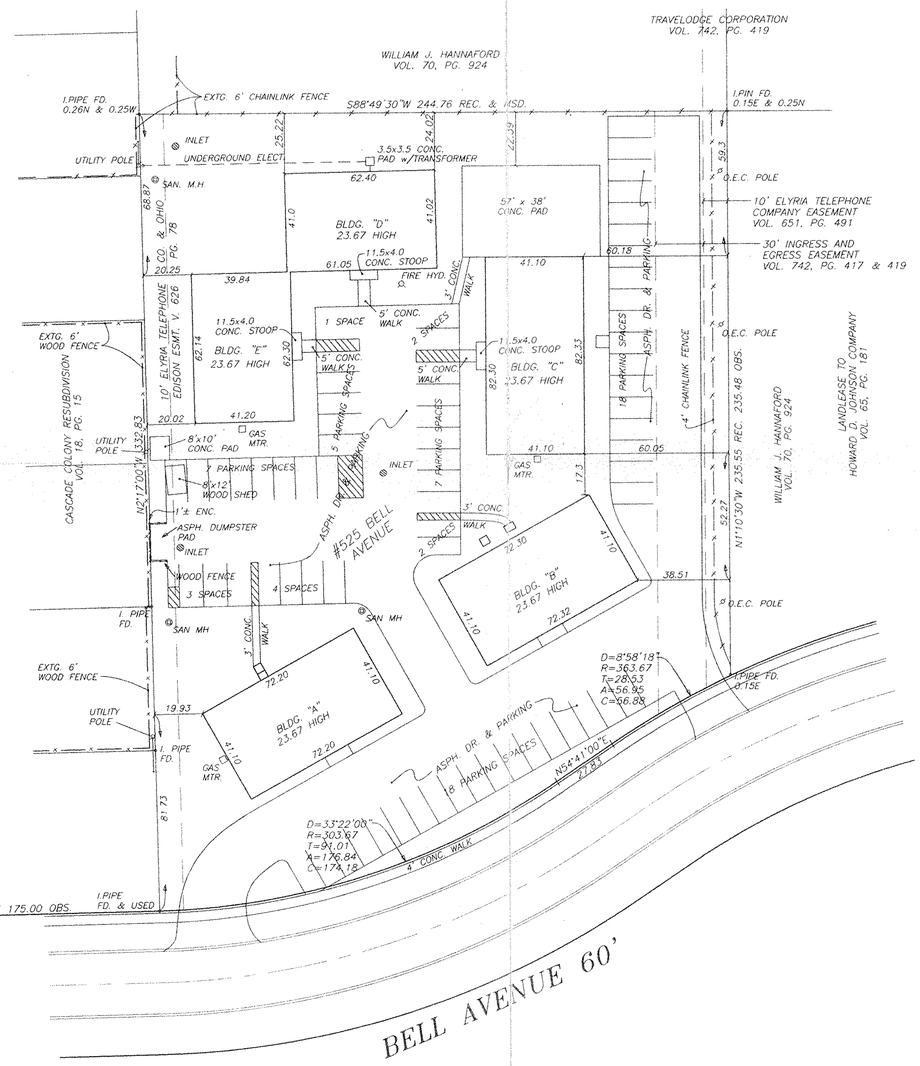

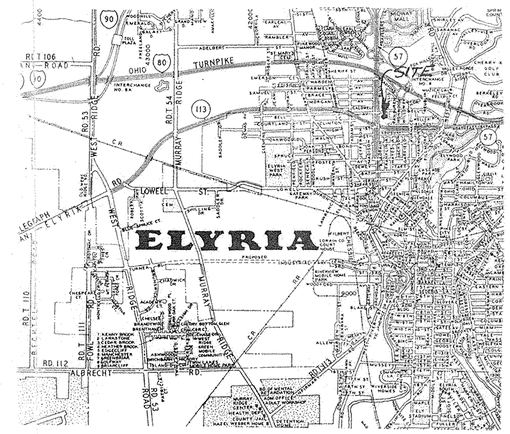
TURNPIKE
OHIO
LOWER
ELYRIA
SITE
ALBRECHT
RD 112
RD 110
RD 113
RD 57
RD 53
RD 54
RT 90
RT 57
RT 113
RT 10
RT 80
RT 57
RT 113