PLAT OF SURVEY FOR
AGNES C. CROWELL
ORIG. LOT 29 - WEST OF BLACK RIVER - ELYRIA TWP.
ELYRIA CITY - LORAIN COUNTY - OHIO
SCALE: 1" = 100' MARCH 1960
Gary E. Penfound Registered Surveyor No. 4457

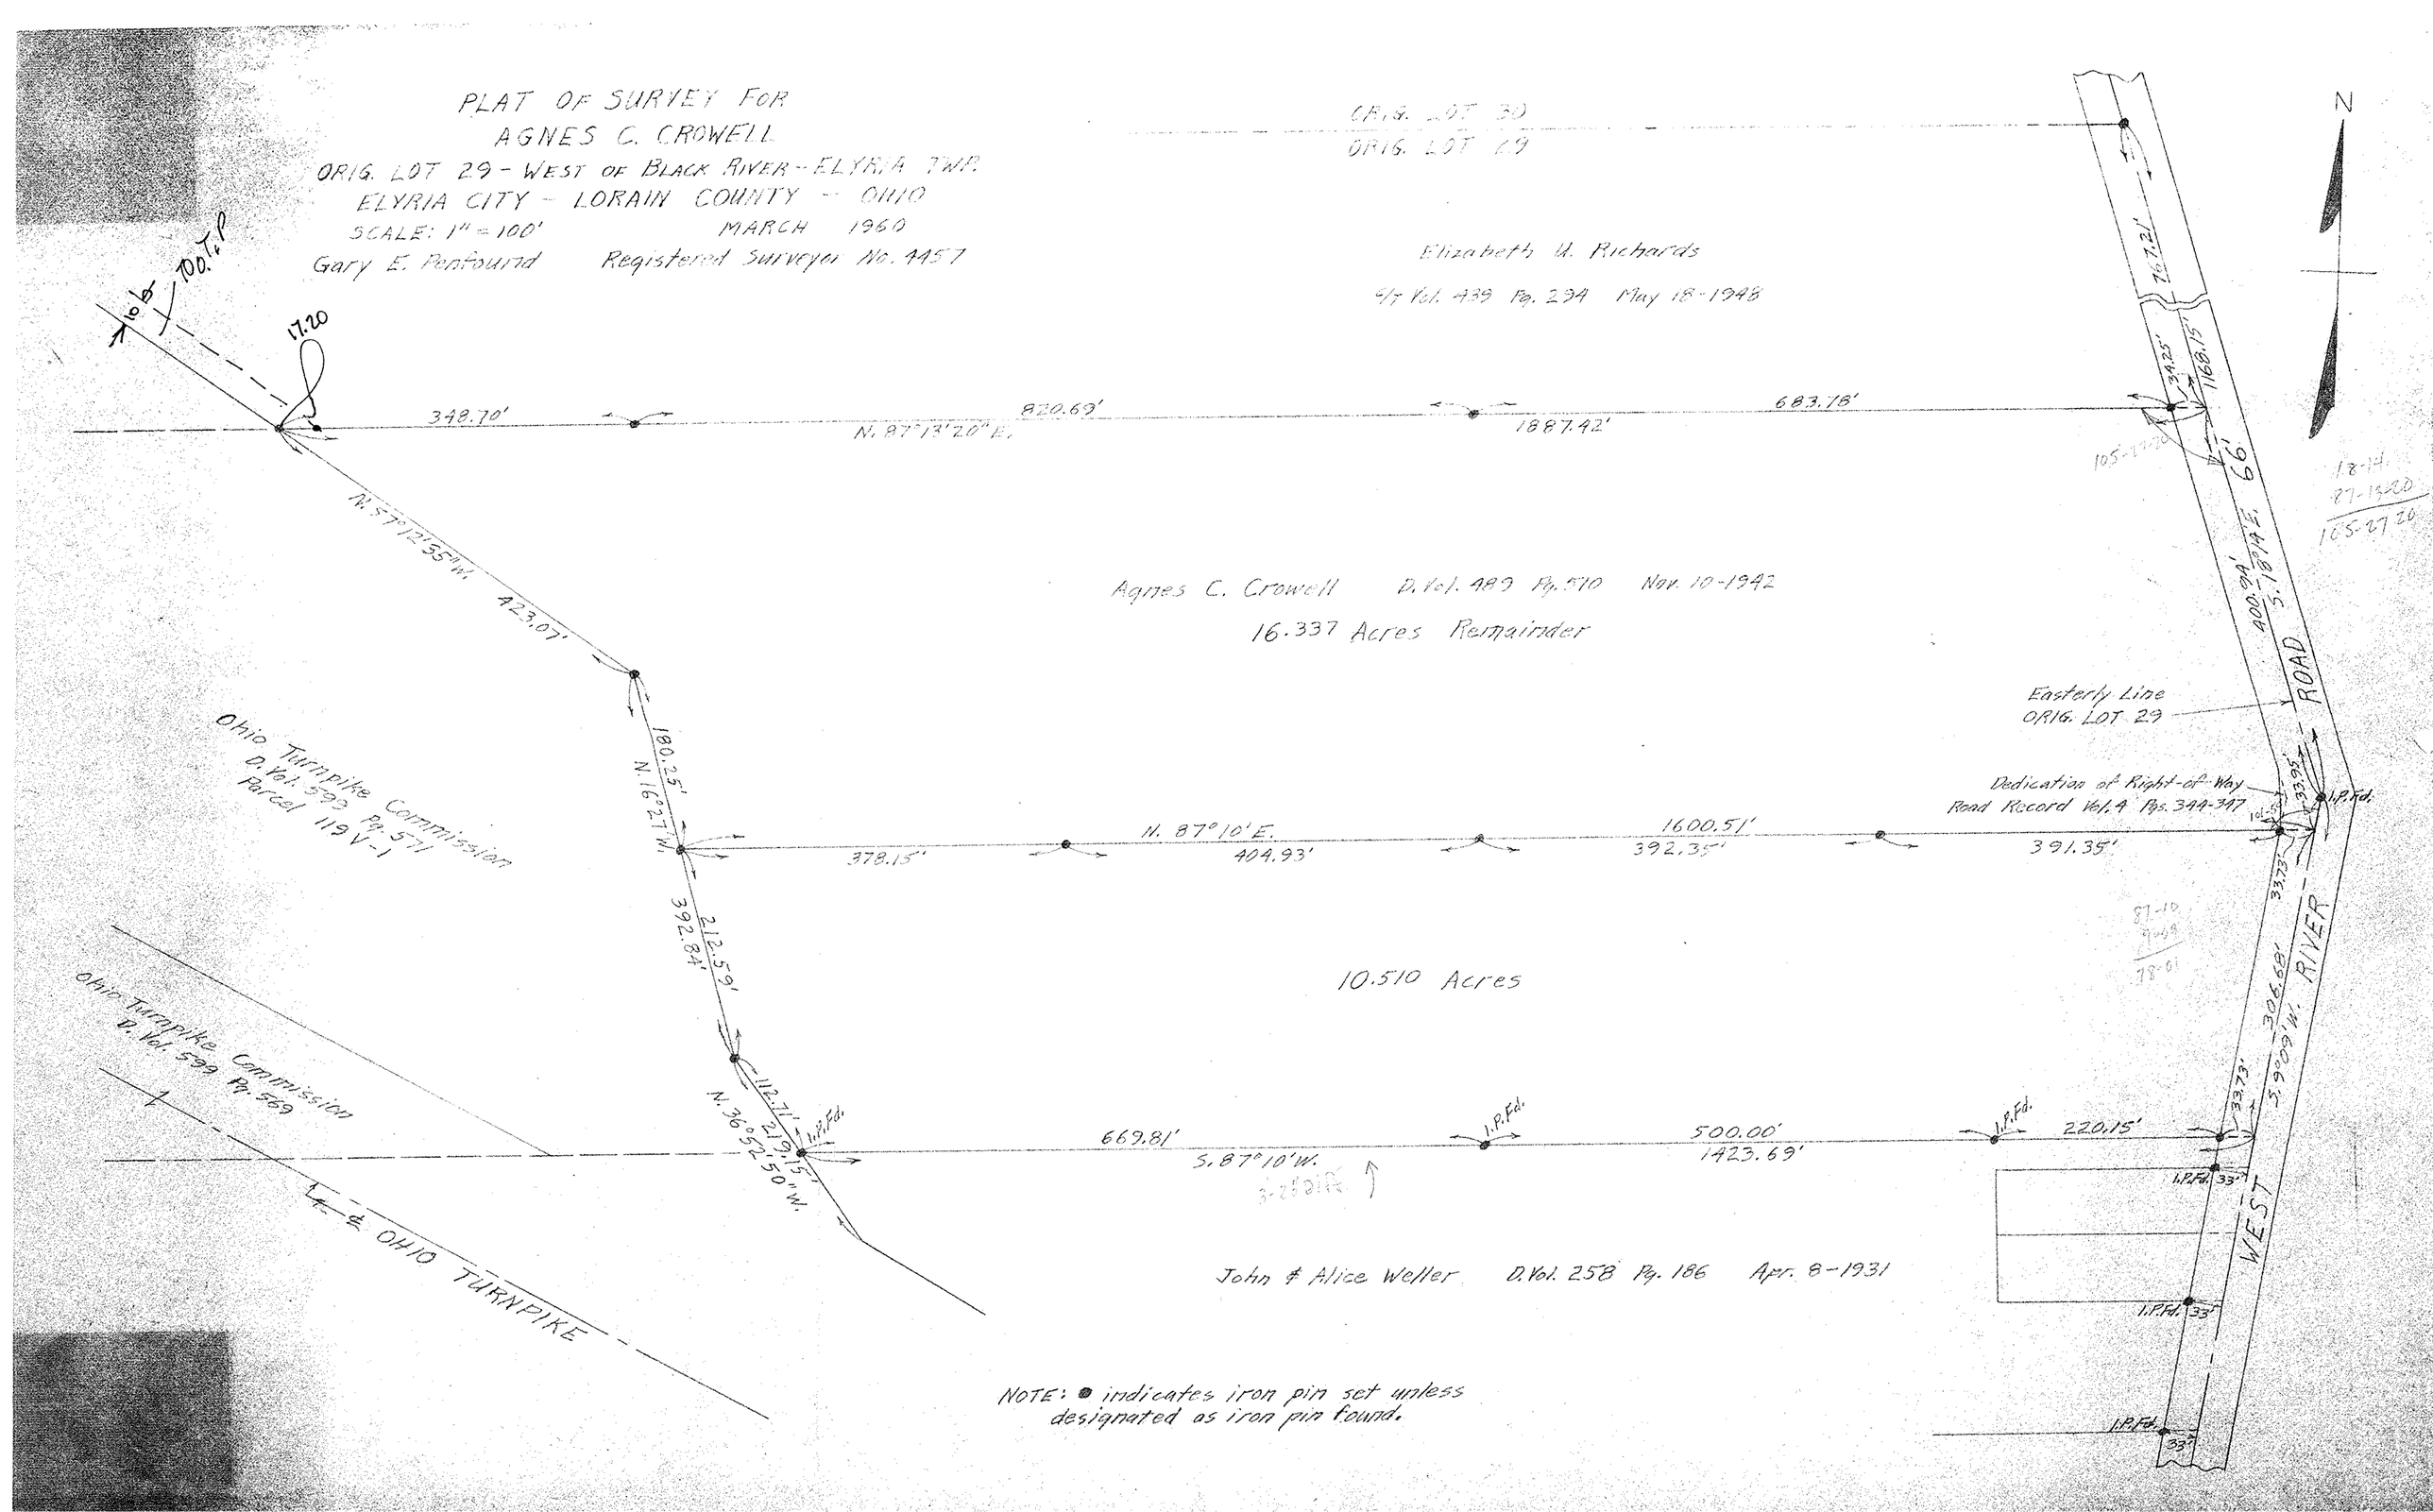

NOTE: ● indicates iron pin set unless designated as iron pin found.