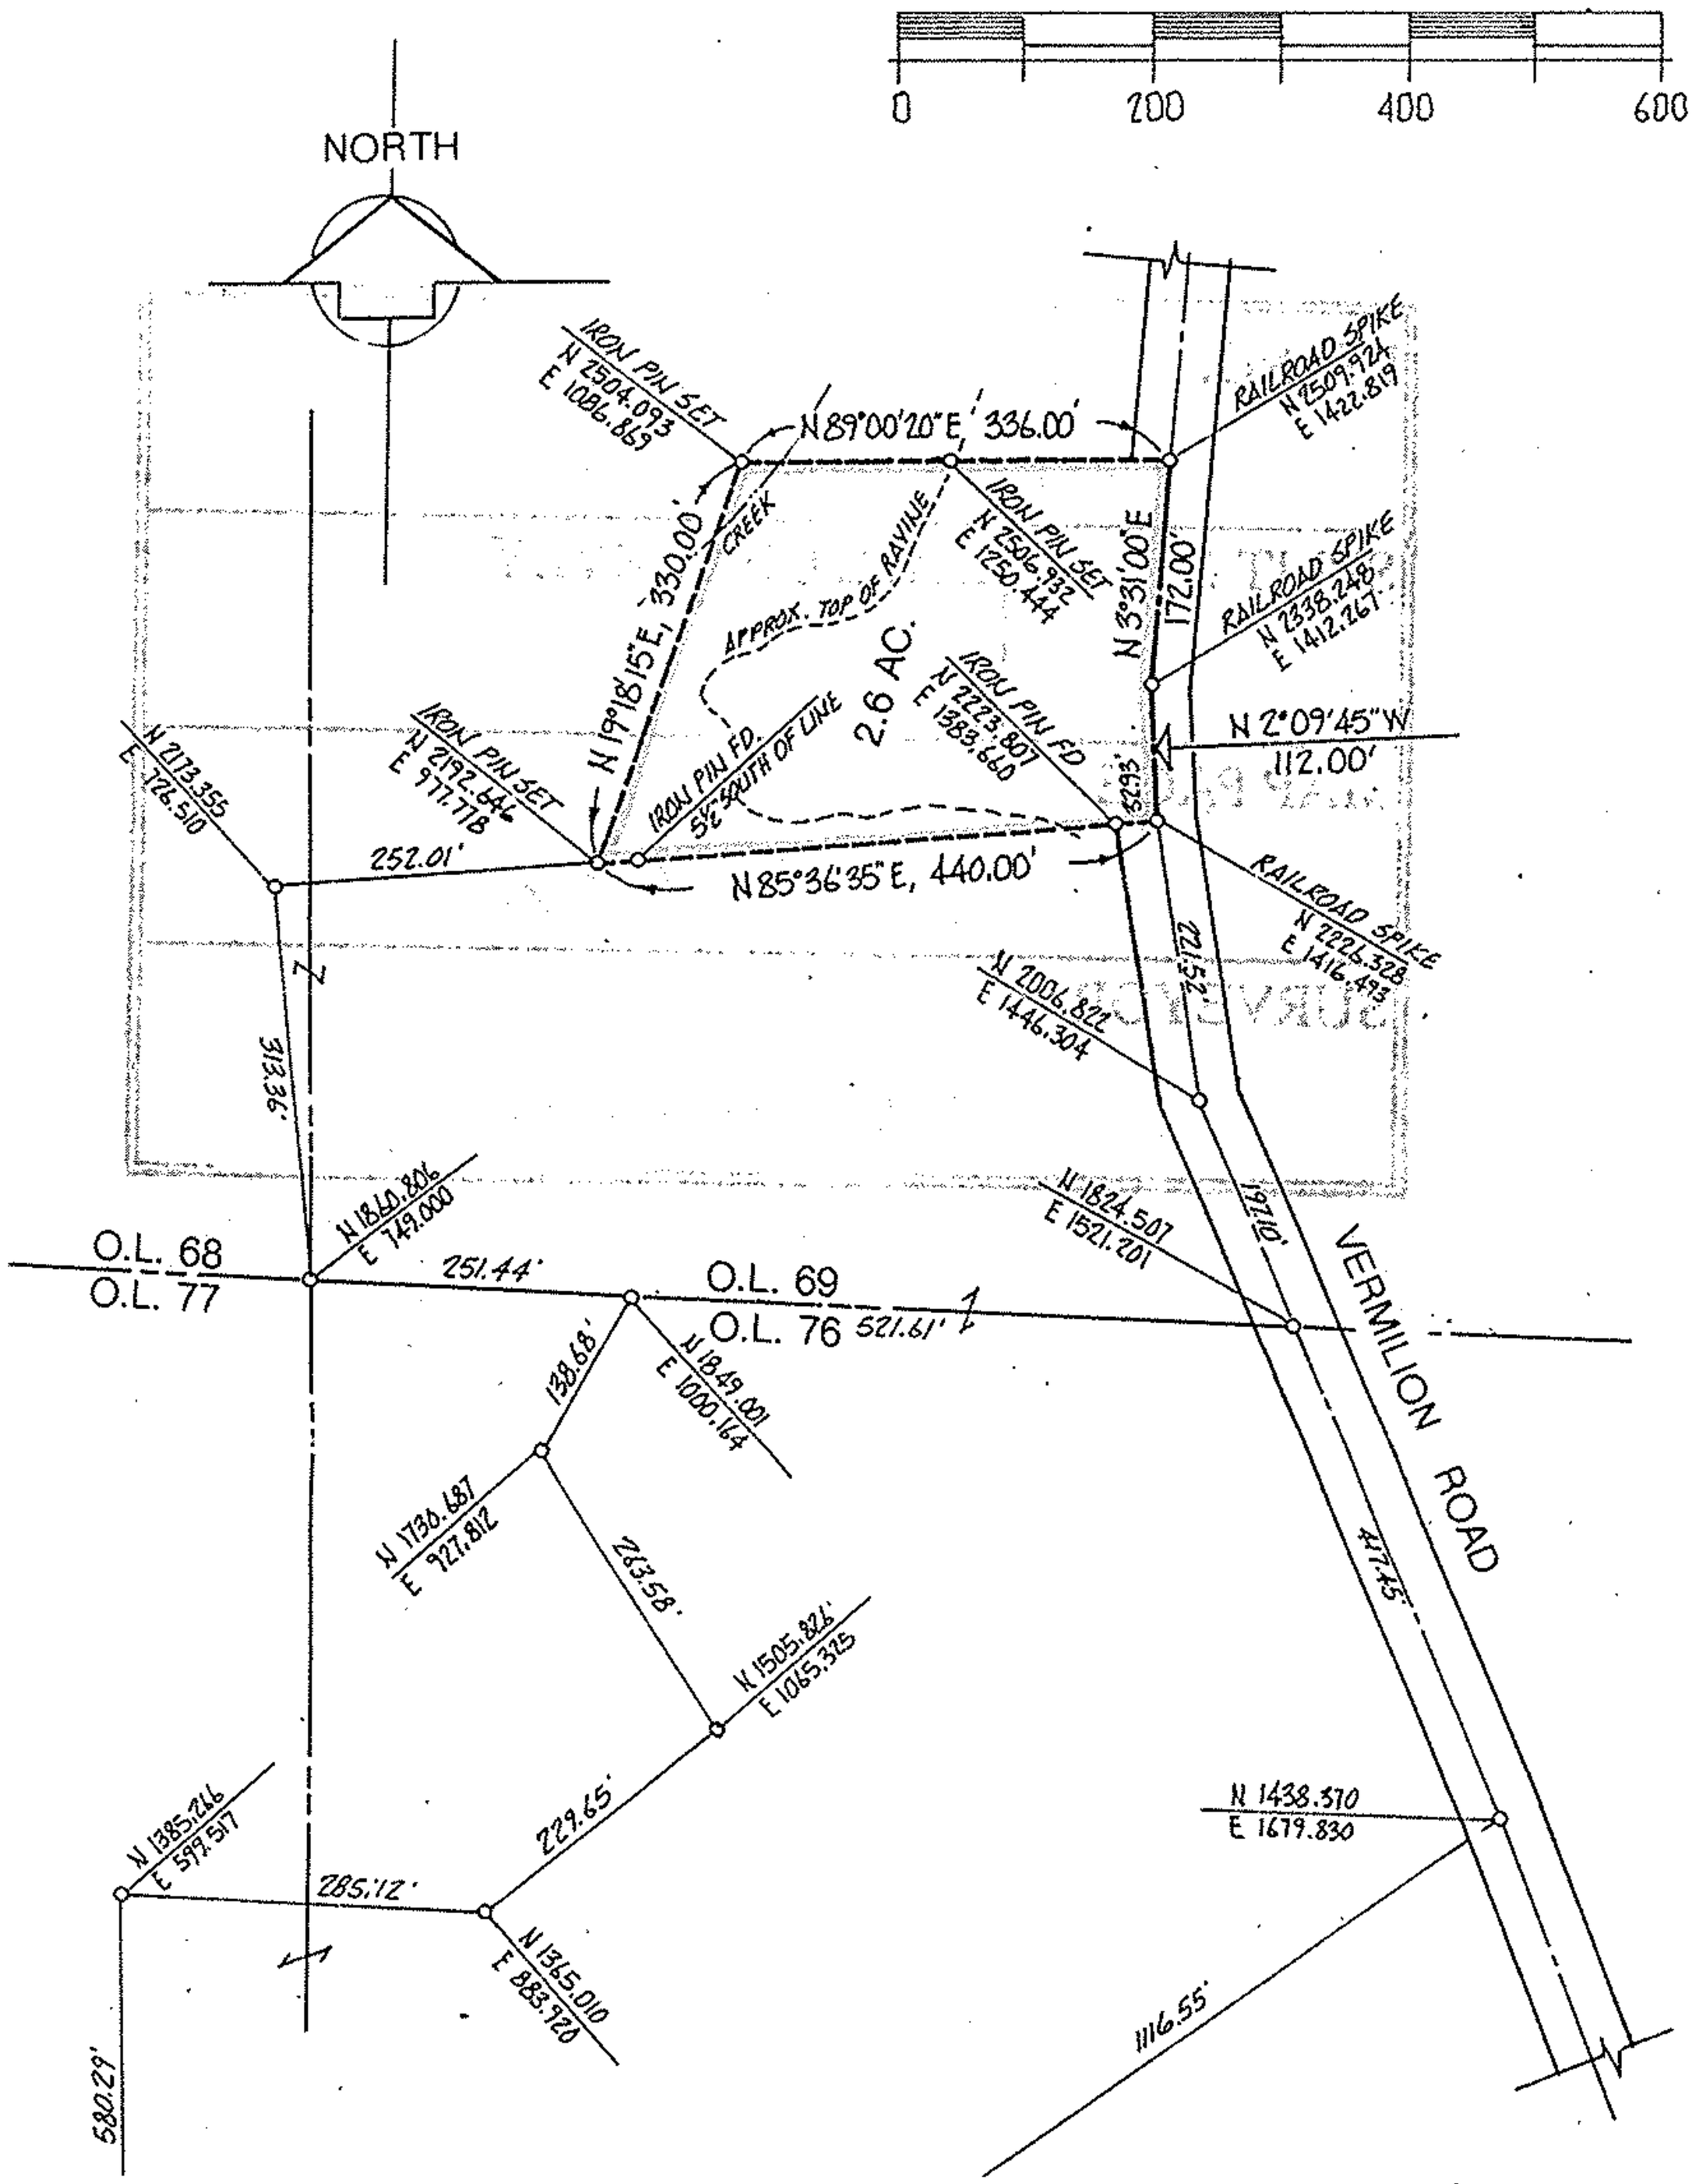

acreage 2.6	PREPARED FOR GERALD A. BUCKHOLZ 5217 RISDEN RD - VERMILION
date NOV-86	
drawn MGH	M.G. HURA, REGISTERED SURVEYOR 12706 MASON ROAD, VERMILION, OHIO (440) 965-4040
scale 1" = 200'	PERIMETER SURVEY
STATE OF OHIO M. G. HURA No. 4712 REGISTERED PROFESSIONAL SURVEYOR	PART(S) OF SUBLOT(S) NO. _____ OF _____ _____ VOLUME ____ PAGE _____ OF PLATS PART of O.L. 69 Tract ____ Section ____ OF BROWNHELM TOWNSHIP LORAIN CO., OHIO

VILLAGE OF

CITY OF