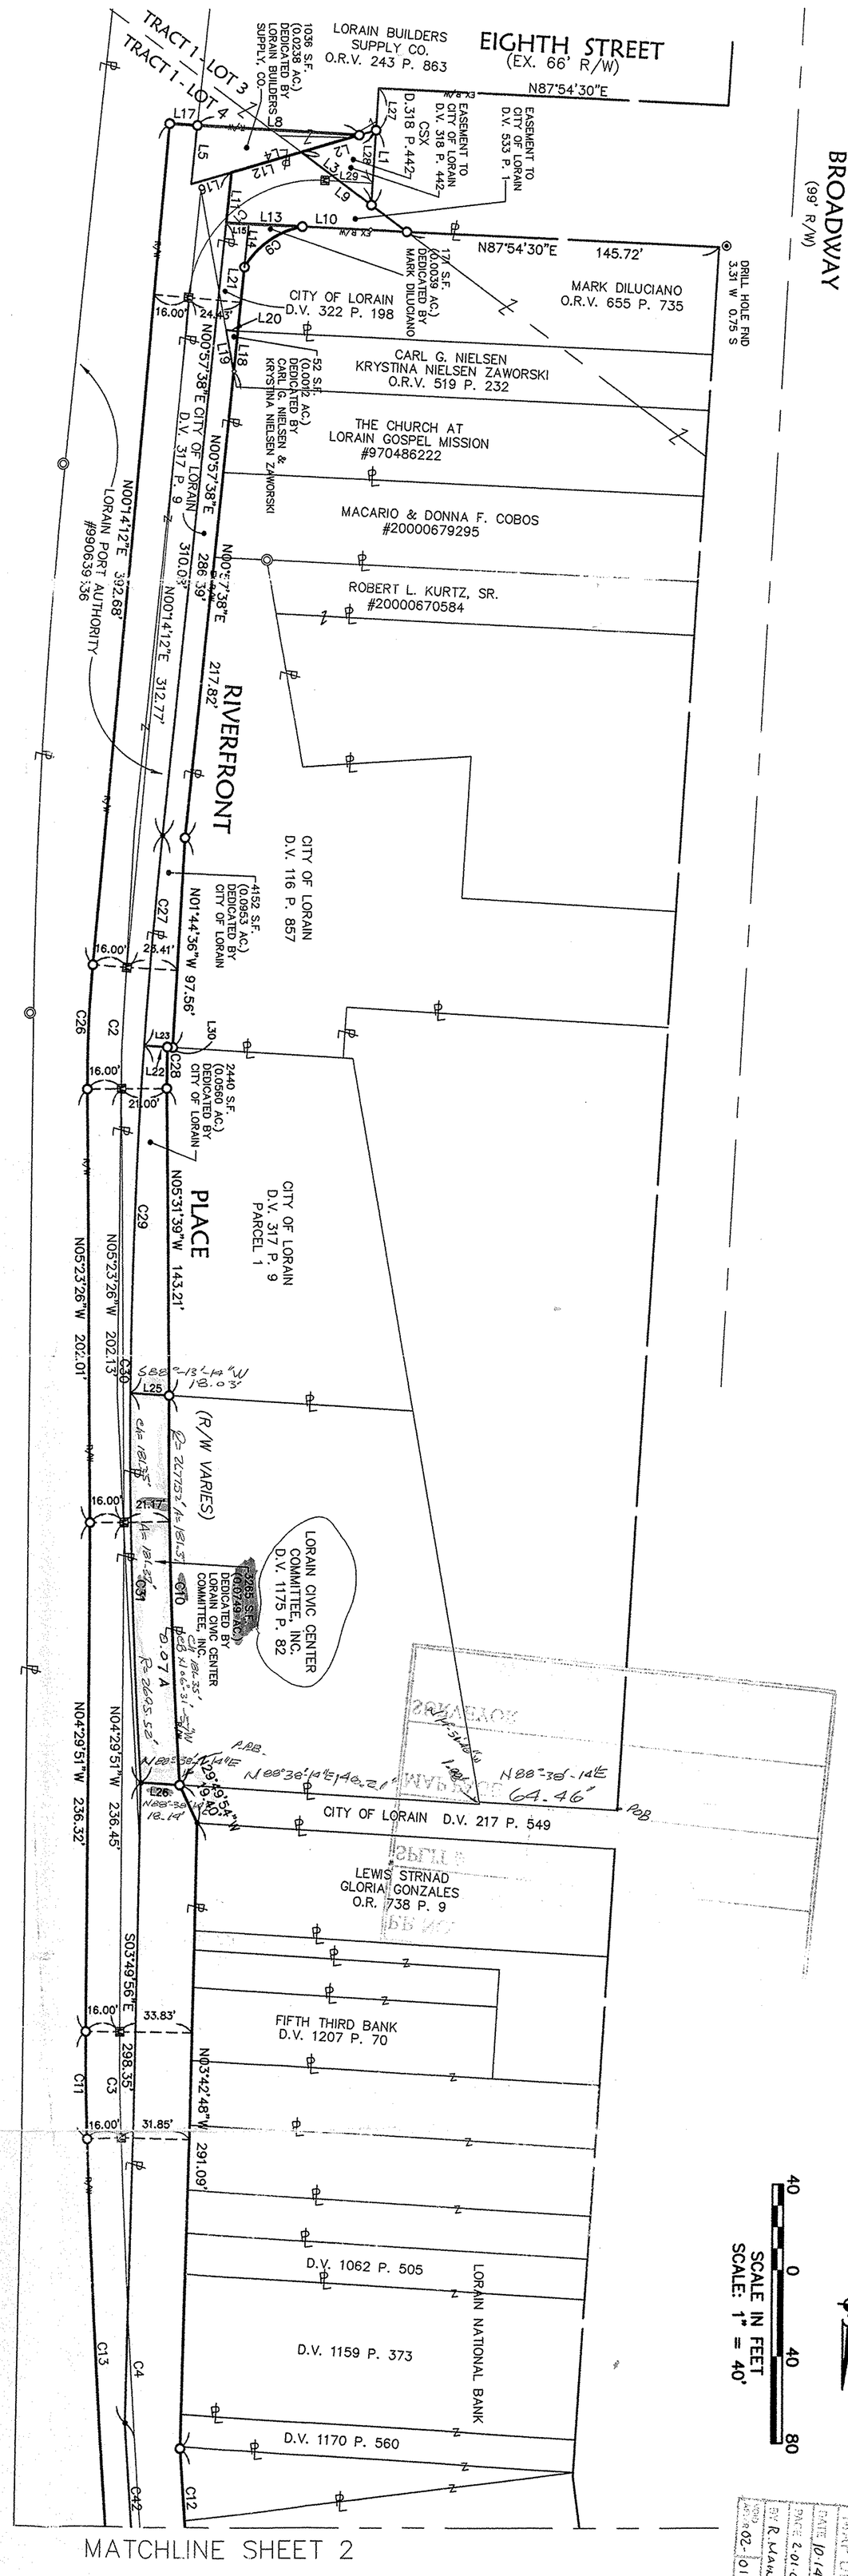

LINE TABLE

LINE	BEARING	LENGTH
L1	S01°21'33"E	34.84
L2	N68°53'58"E	36.43
L3	N58°02'30"W	41.03
L4	S68°53'58"W	81.35
L5	N01°02'57"E	27.49
L8	N88°37'51"E	75.42
L9	S58°02'30"E	61.80
L10	S87°54'30"W	84.25
L11	N00°57'38"E	23.69
L12	N68°53'58"E	33.61
L13	N87°54'30"E	24.82
L14	N00°57'38"E	20.16
L15	S87°54'30"W	10.51
L16	S68°53'58"W	19.48
L17	S88°37'51"W	12.93
L18	N00°57'38"E	19.06
L19	S15°01'59"E	19.73
L20	S89°57'39"W	5.44
L21	N00°57'38"E	50.07
L22	N88°38'14"E	10.81
L23	N88°38'14"E	13.33
L24	N12°10'22"W	0.45
L25	S88°38'14"W	18.03
L26	S88°38'14"W	18.14
L27	N01°21'33"W	19.53
L28	N01°21'33"W	24.76
L29	N88°37'51"E	22.30
L30	N88°38'14"E	2.52
L31	S12°10'22"E	9.39

CURVE TABLE

CURVE	RADIUS	LENGTH	TANGENT	CHORD	BEARING	DELTA
C1	60.00	92.57	58.34	83.66	N44°26'02"E	88°23'40"
C2	574.96	46.47	28.26	56.45	N02°34'37"W	5°37'38"
C3	1002.00	50.76	25.39	50.76	N05°56'56"W	2°54'10"
C4	6599.12	217.98	109.00	217.97	N08°20'48"W	1°53'33"
C5	2852.93	383.99	192.28	383.70	N13°08'55"W	7°42'42"
C6	212.36	87.55	44.41	86.93	S05°11'34"E	23°37'19"
C7	212.36	70.67	35.66	70.34	N02°54'50"W	19°04'02"
C8	200.00	218.29	167.00	256.38	N52°18'37"W	79°43'30"
C9	39.45	33.83	18.03	32.80	N50°02'18"E	49°07'44"
C10	2677.52	181.37	90.72	181.35	N06°31'57"W	3°52'53"
C11	1018.00	51.57	25.79	51.57	N05°56'56"W	2°54'10"
C12	6578.12	72.52	36.28	72.52	N08°58'37"W	0°37'54"
C13	6615.12	218.50	109.26	218.48	N08°20'48"W	1°53'33"
C14	2831.95	380.93	190.75	380.64	N13°08'47"W	7°42'25"
C15	2868.93	386.14	193.36	385.85	N13°08'55"W	7°42'42"
C16	233.36	48.44	48.92	95.75	S05°13'09"E	23°40'39"
C17	196.36	80.96	41.06	80.38	S05°11'34"E	23°37'19"
C18	191.36	53.96	27.16	53.79	N04°22'08"W	16°09'28"
C19	228.36	75.99	38.35	75.64	N02°54'51"W	19°04'02"
C20	179.00	249.07	149.47	229.46	N52°18'37"W	79°43'30"
C21	216.00	174.93	92.58	170.19	N35°38'54"W	46°24'04"
C22	216.00	130.11	67.09	128.15	N69°55'37"W	34°30'43"
C23	23.00	20.15	10.77	19.51	S62°43'33"W	50°12'10"
C24	28.00	0.34	0.17	0.34	S81°35'23"E	0°41'09"
C25	590.96	18.04	9.02	18.04	N02°34'37"W	1°45'09"
C26	2695.52	18.01	9.01	18.01	N00°04'55"W	0°38'29"
C27	2695.52	9.26	4.63	9.26	N04°23'40"W	0°11'48"
C28	553.96	12.15	6.08	12.15	N02°50'49"W	1°15'39"
C29	2695.52	41.54	20.77	41.54	N03°43'58"W	0°52'48"
C30	2695.52	81.37	40.69	81.37	N06°29'52"W	1°43'11"
C31	2695.52	81.37	40.69	81.37	N06°29'52"W	1°43'11"
C32	2856.93	96.61	48.31	96.60	N07°01'01"W	1°56'24"
C33	191.36	9.71	4.86	9.71	N14°10'21"W	2°54'29"
C34	179.00	42.40	21.29	42.30	N05°09'50"E	13°34'17"
C35	216.00	82.52	41.71	82.00	N29°57'44"W	21°53'11"
C36	179.00	83.98	42.67	83.20	N36°35'37"W	26°52'42"
C37	216.00	156.55	81.98	153.07	N50°51'44"W	41°30'20"
C38	216.00	47.19	23.80	47.08	N58°20'41"W	12°30'54"
C39	179.00	54.23	27.16	54.00	N58°59'21"W	17°36'40"
C40	216.00	103.88	53.79	102.92	N75°18'16"W	27°32'07"
C41	1179.28	17.79	8.90	17.79	N70°01'01"W	0°51'57"
C42	6826.98	35.47	17.74	35.47	N70°01'01"W	0°17'26"
C43	179.00	37.26	18.63	37.20	S80°51'28"W	11°55'36"
C44	216.00	85.91	43.92	85.32	N08°55'34"W	22°47'46"
C45	1146.28	32.72	16.36	32.72	N14°32'31"W	1°38'08"
C46	216.00	23.57	11.79	23.56	N80°57'17"W	6°15'00"

DEDICATION PLAT
RIVERFRONT PLACE IMPROVEMENTS

SHEET 1 OF 2

JOB NO. 00119

KS ASSOCIATES, INC.
10 Burns Road, Suite 100
P.O. Box 569
Berea, Ohio 44036
Phone (440) 365-4730
Fax (440) 365-4790
kstroom@ksassoc.com

DATE: 2-05-01
DRAWN BY: AMK/RGR
CH'D BY:
DWG. NAME: 0-PLATRV
JOB NO. 00119

REVISIONS	DATE	DESCRIPTION	BY